


MICHAEL THOMAS

NICHOLAS HELFRICK

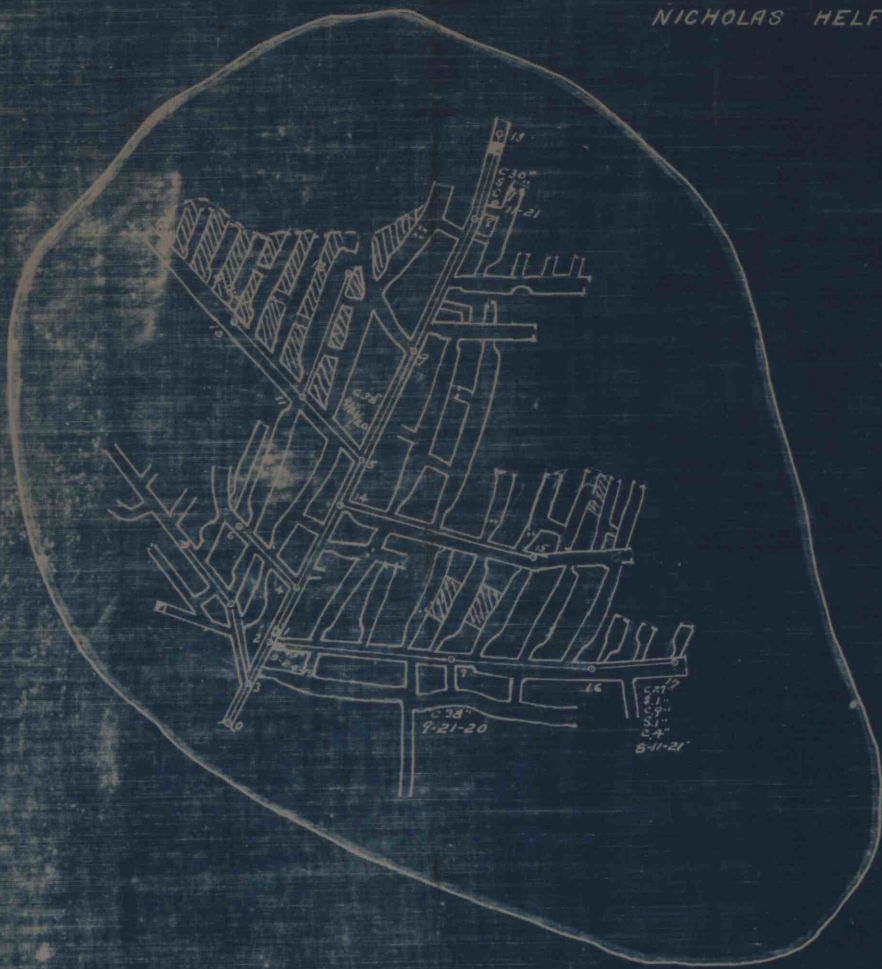

CHESTON COAL CO.
"E" SEAM
HASTINGS PA.

SEPT. 1913

SCALE 1" = 100'