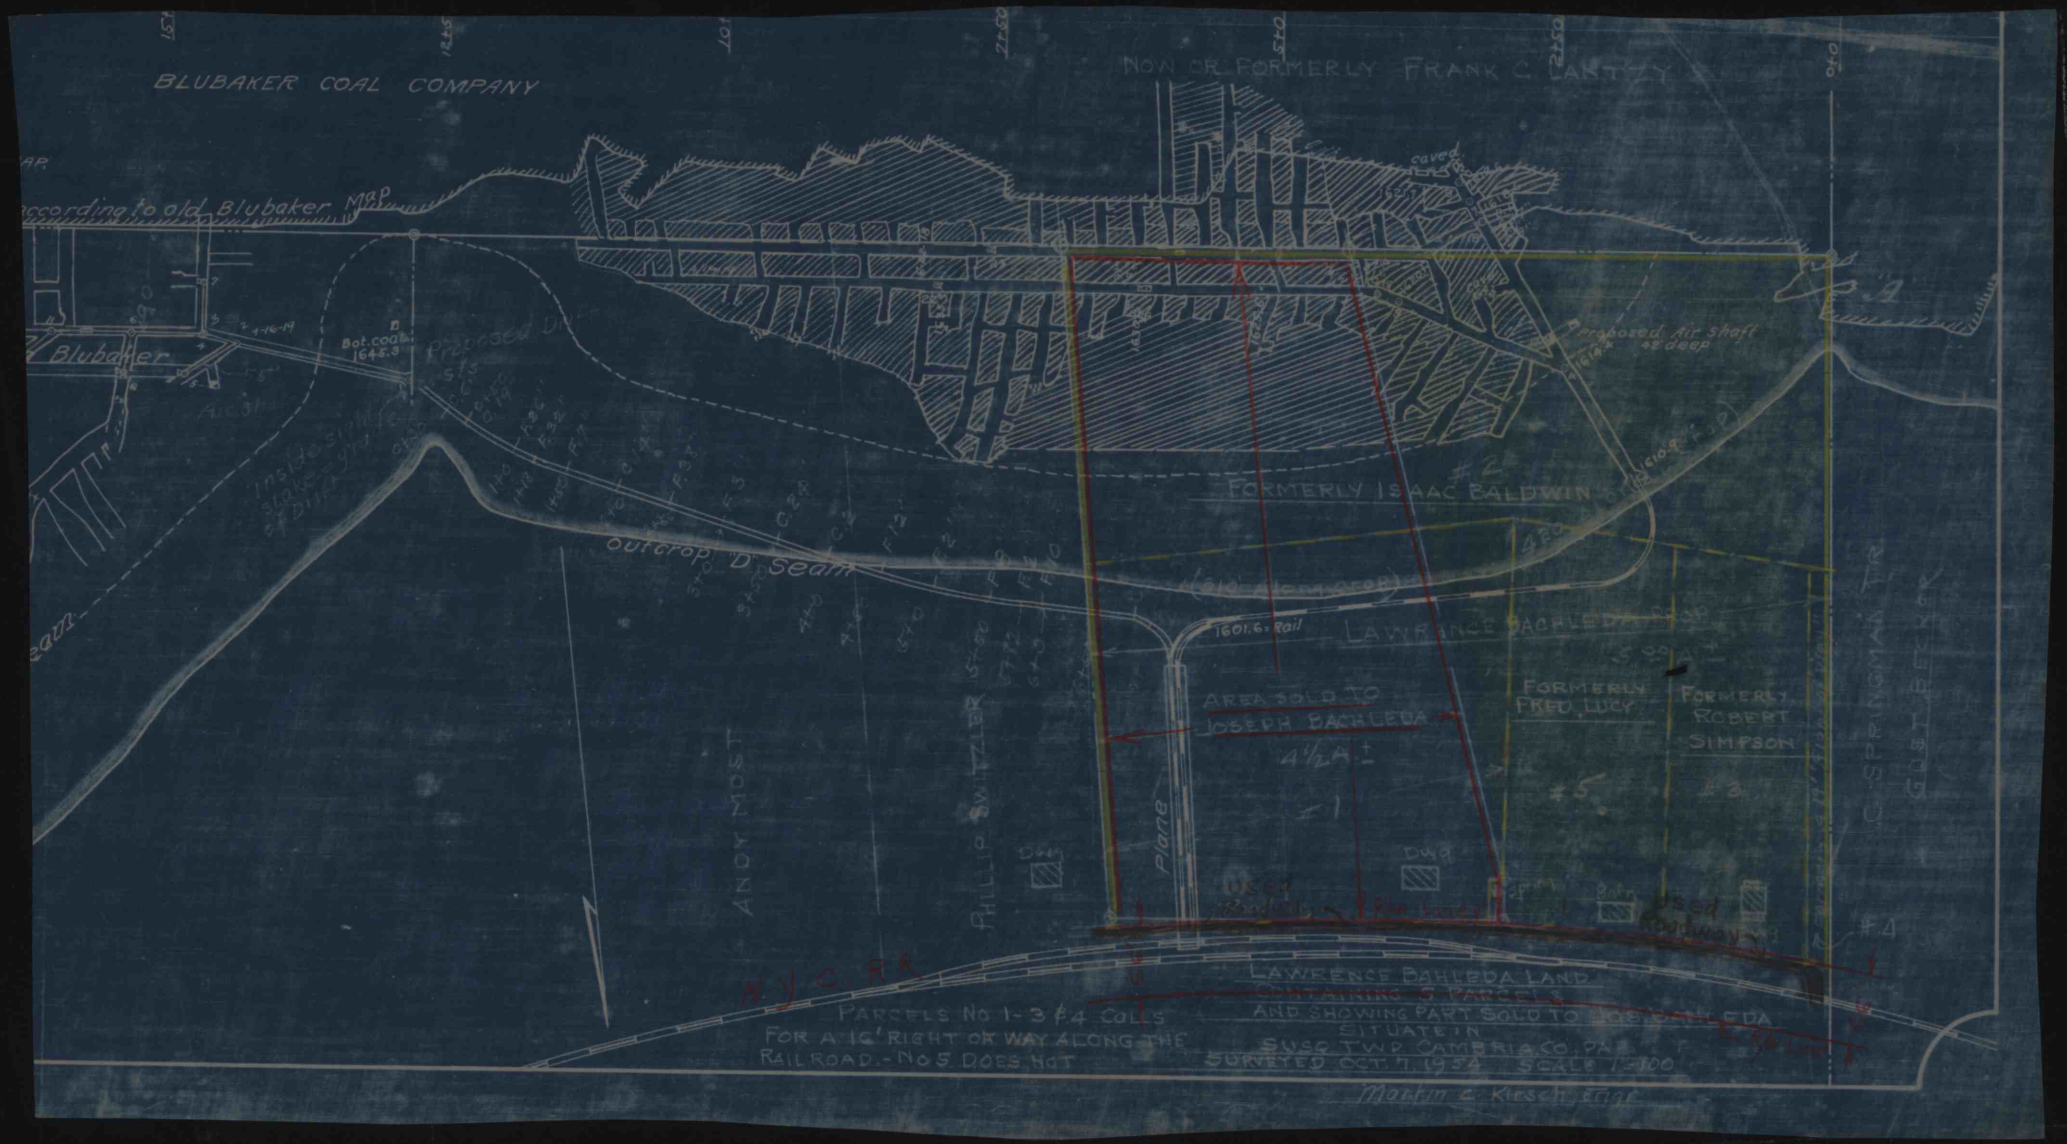
BLUBAKER COAL COMPANY
NOW OR FORMERLY FRANK C. LANTZY
According to old Blubaker Map
Blubaker
Bot. coal 1645.3
Proposed Air shaft 42' deep
caved
FORMERLY ISAAC BALDWIN
Outcrop "D" Seam
1601.6 Rail
LAWRENCE BACHLEDA
AREA SOLD TO JOSEPH BACHLEDA
4½A ±
FORMERLY FRED LUCY
FORMERLY ROBERT SIMPSON
#5
#3
#4
Plane
Used Roadway
Used Roadway
ANDY MOST
PHILLIP SWITZLER
N.Y.C.R.R.
LAWRENCE BACHLEDA LAND
AND SHOWING PART SOLD TO
SITUATE IN
SURVEYED OCT. 7, 1954 SCALE 1"=100'
PARCELS No. 1-3 & 4 CALLS FOR A 16' RIGHT OF WAY ALONG THE RAILROAD.- No 5 DOES NOT