


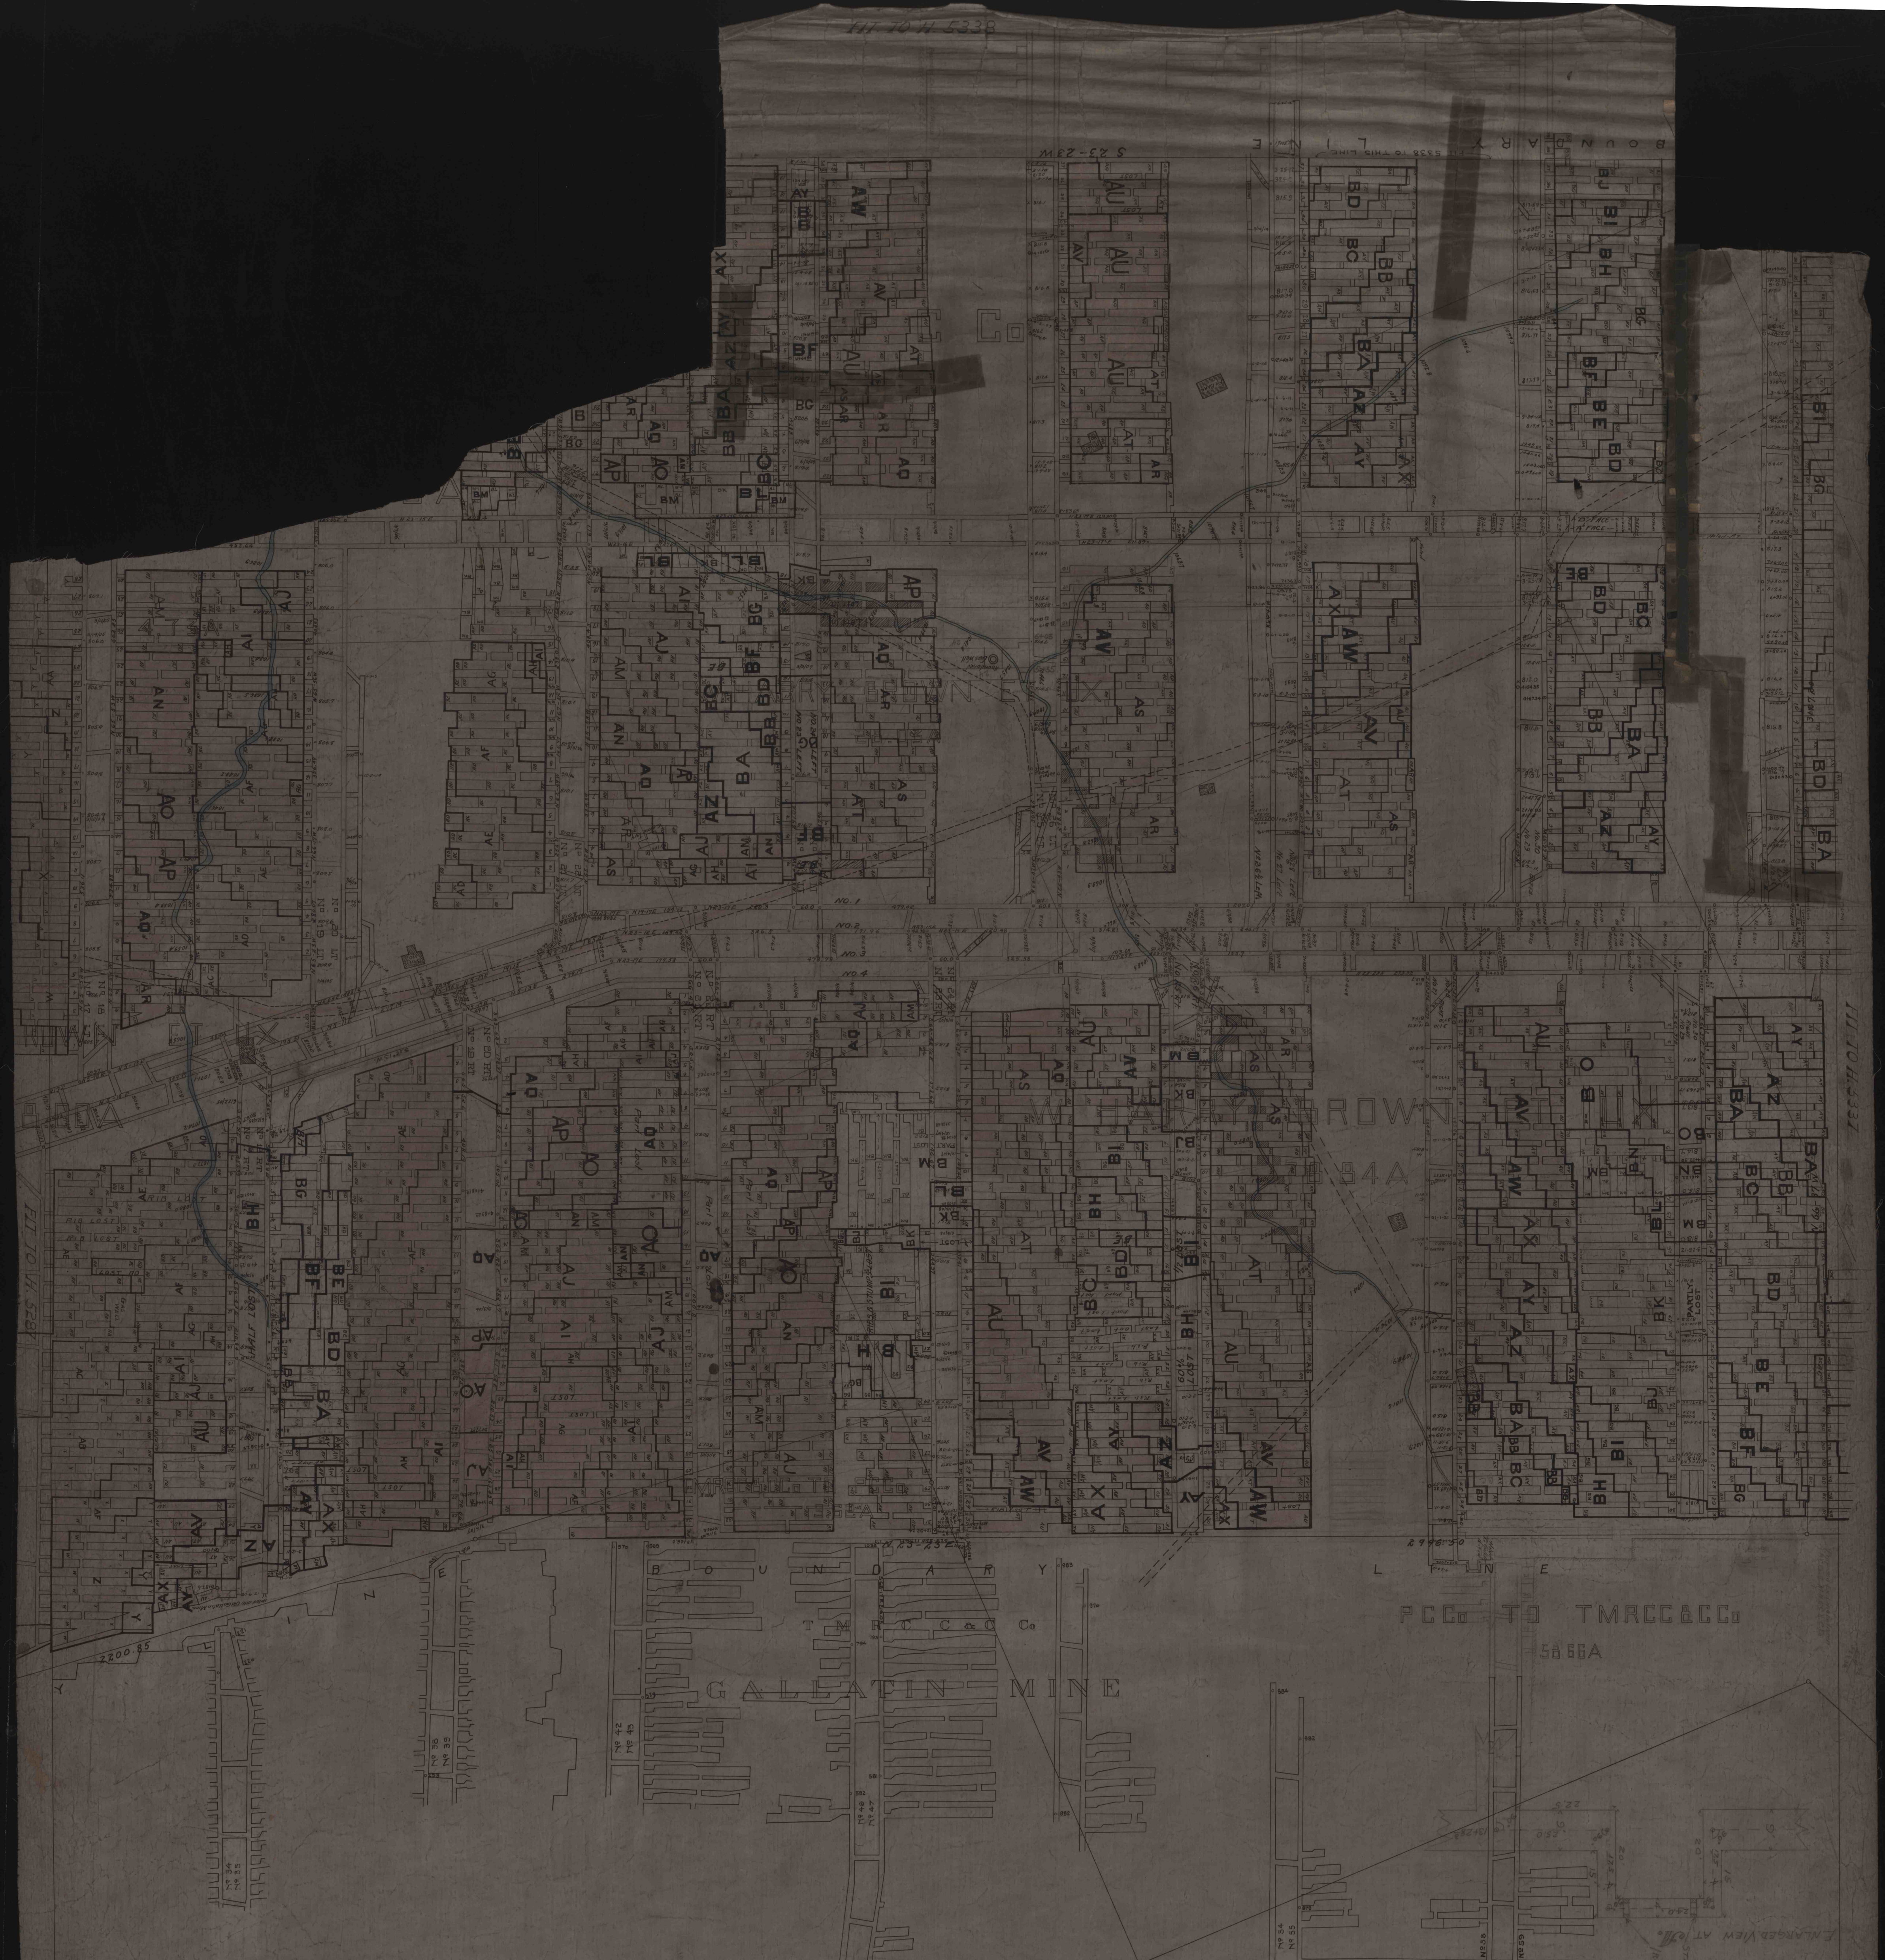

MANOWN MINE

WARD TOWNSHIP, ALLEGHENY CO., PA.

SCALE 1 IN. = 100 FT. AUGUST 1908.

SURVEYS

