


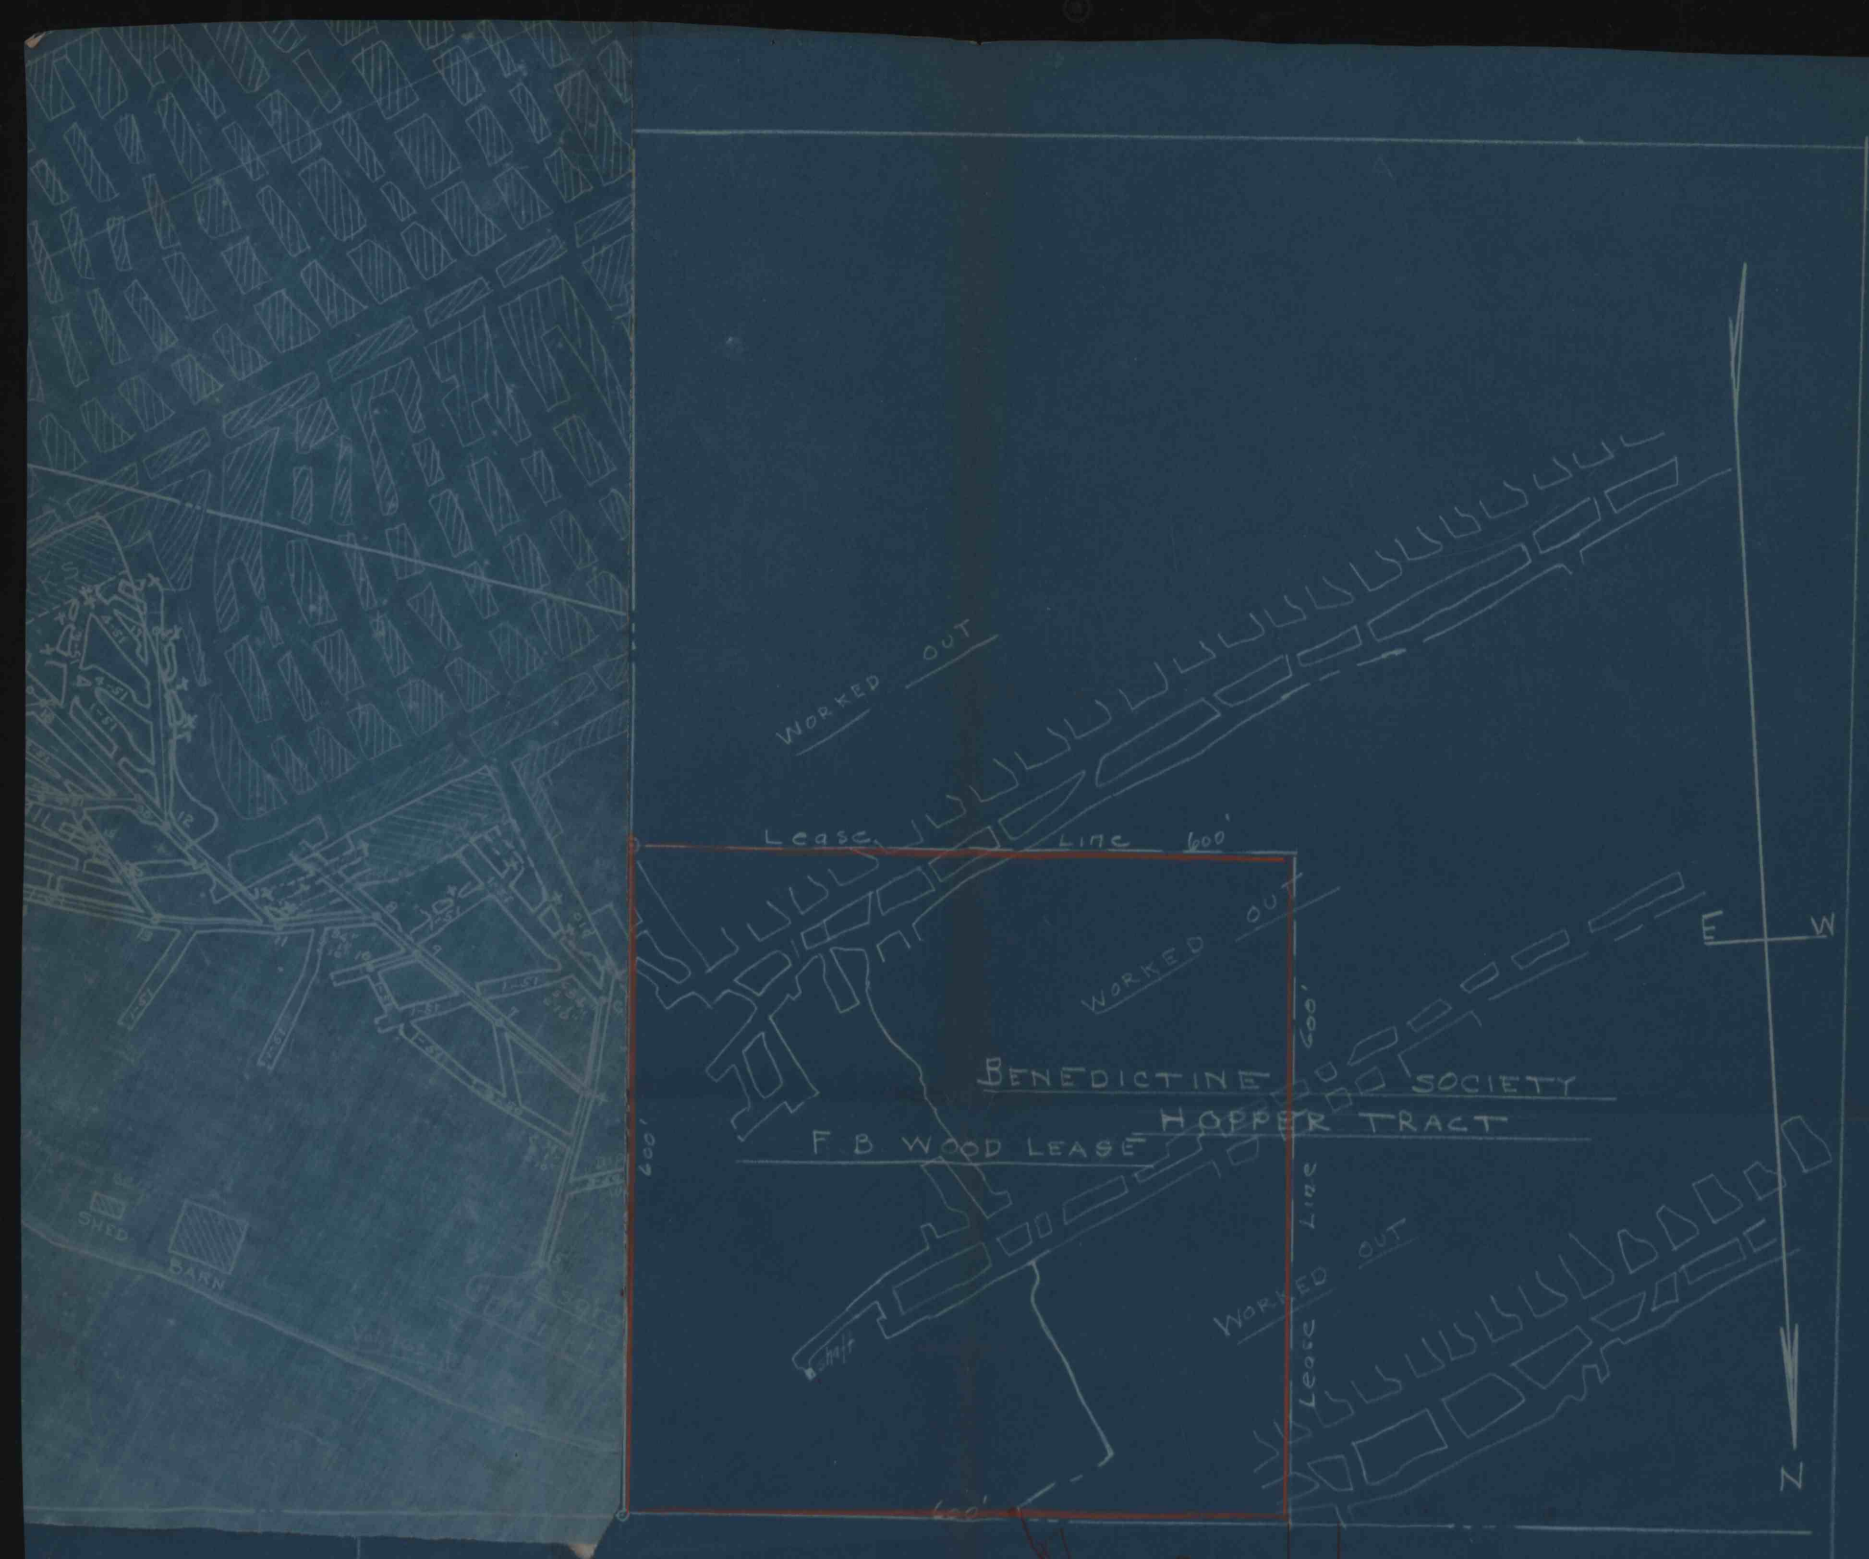

MINE MAP SHOWING
 "D" SEAM MINE WORKINGS OF
 VICTOR NO 1 MINE
 ON PROPERTY OF BENEDICTINE SOCIETY
 IN RELATION TO
 OLD "D" WORKINGS OF
 ESGRO MINE ON
 MILLER TRACT OF BLUEBAY COAL CO
 SITUATE IN
 W CARROLL TWP CAMBRIA CO, PA
 DEPT 1958
 SCALE 1"=100'
 Martin C. Birch RPE
 Spangler, PA