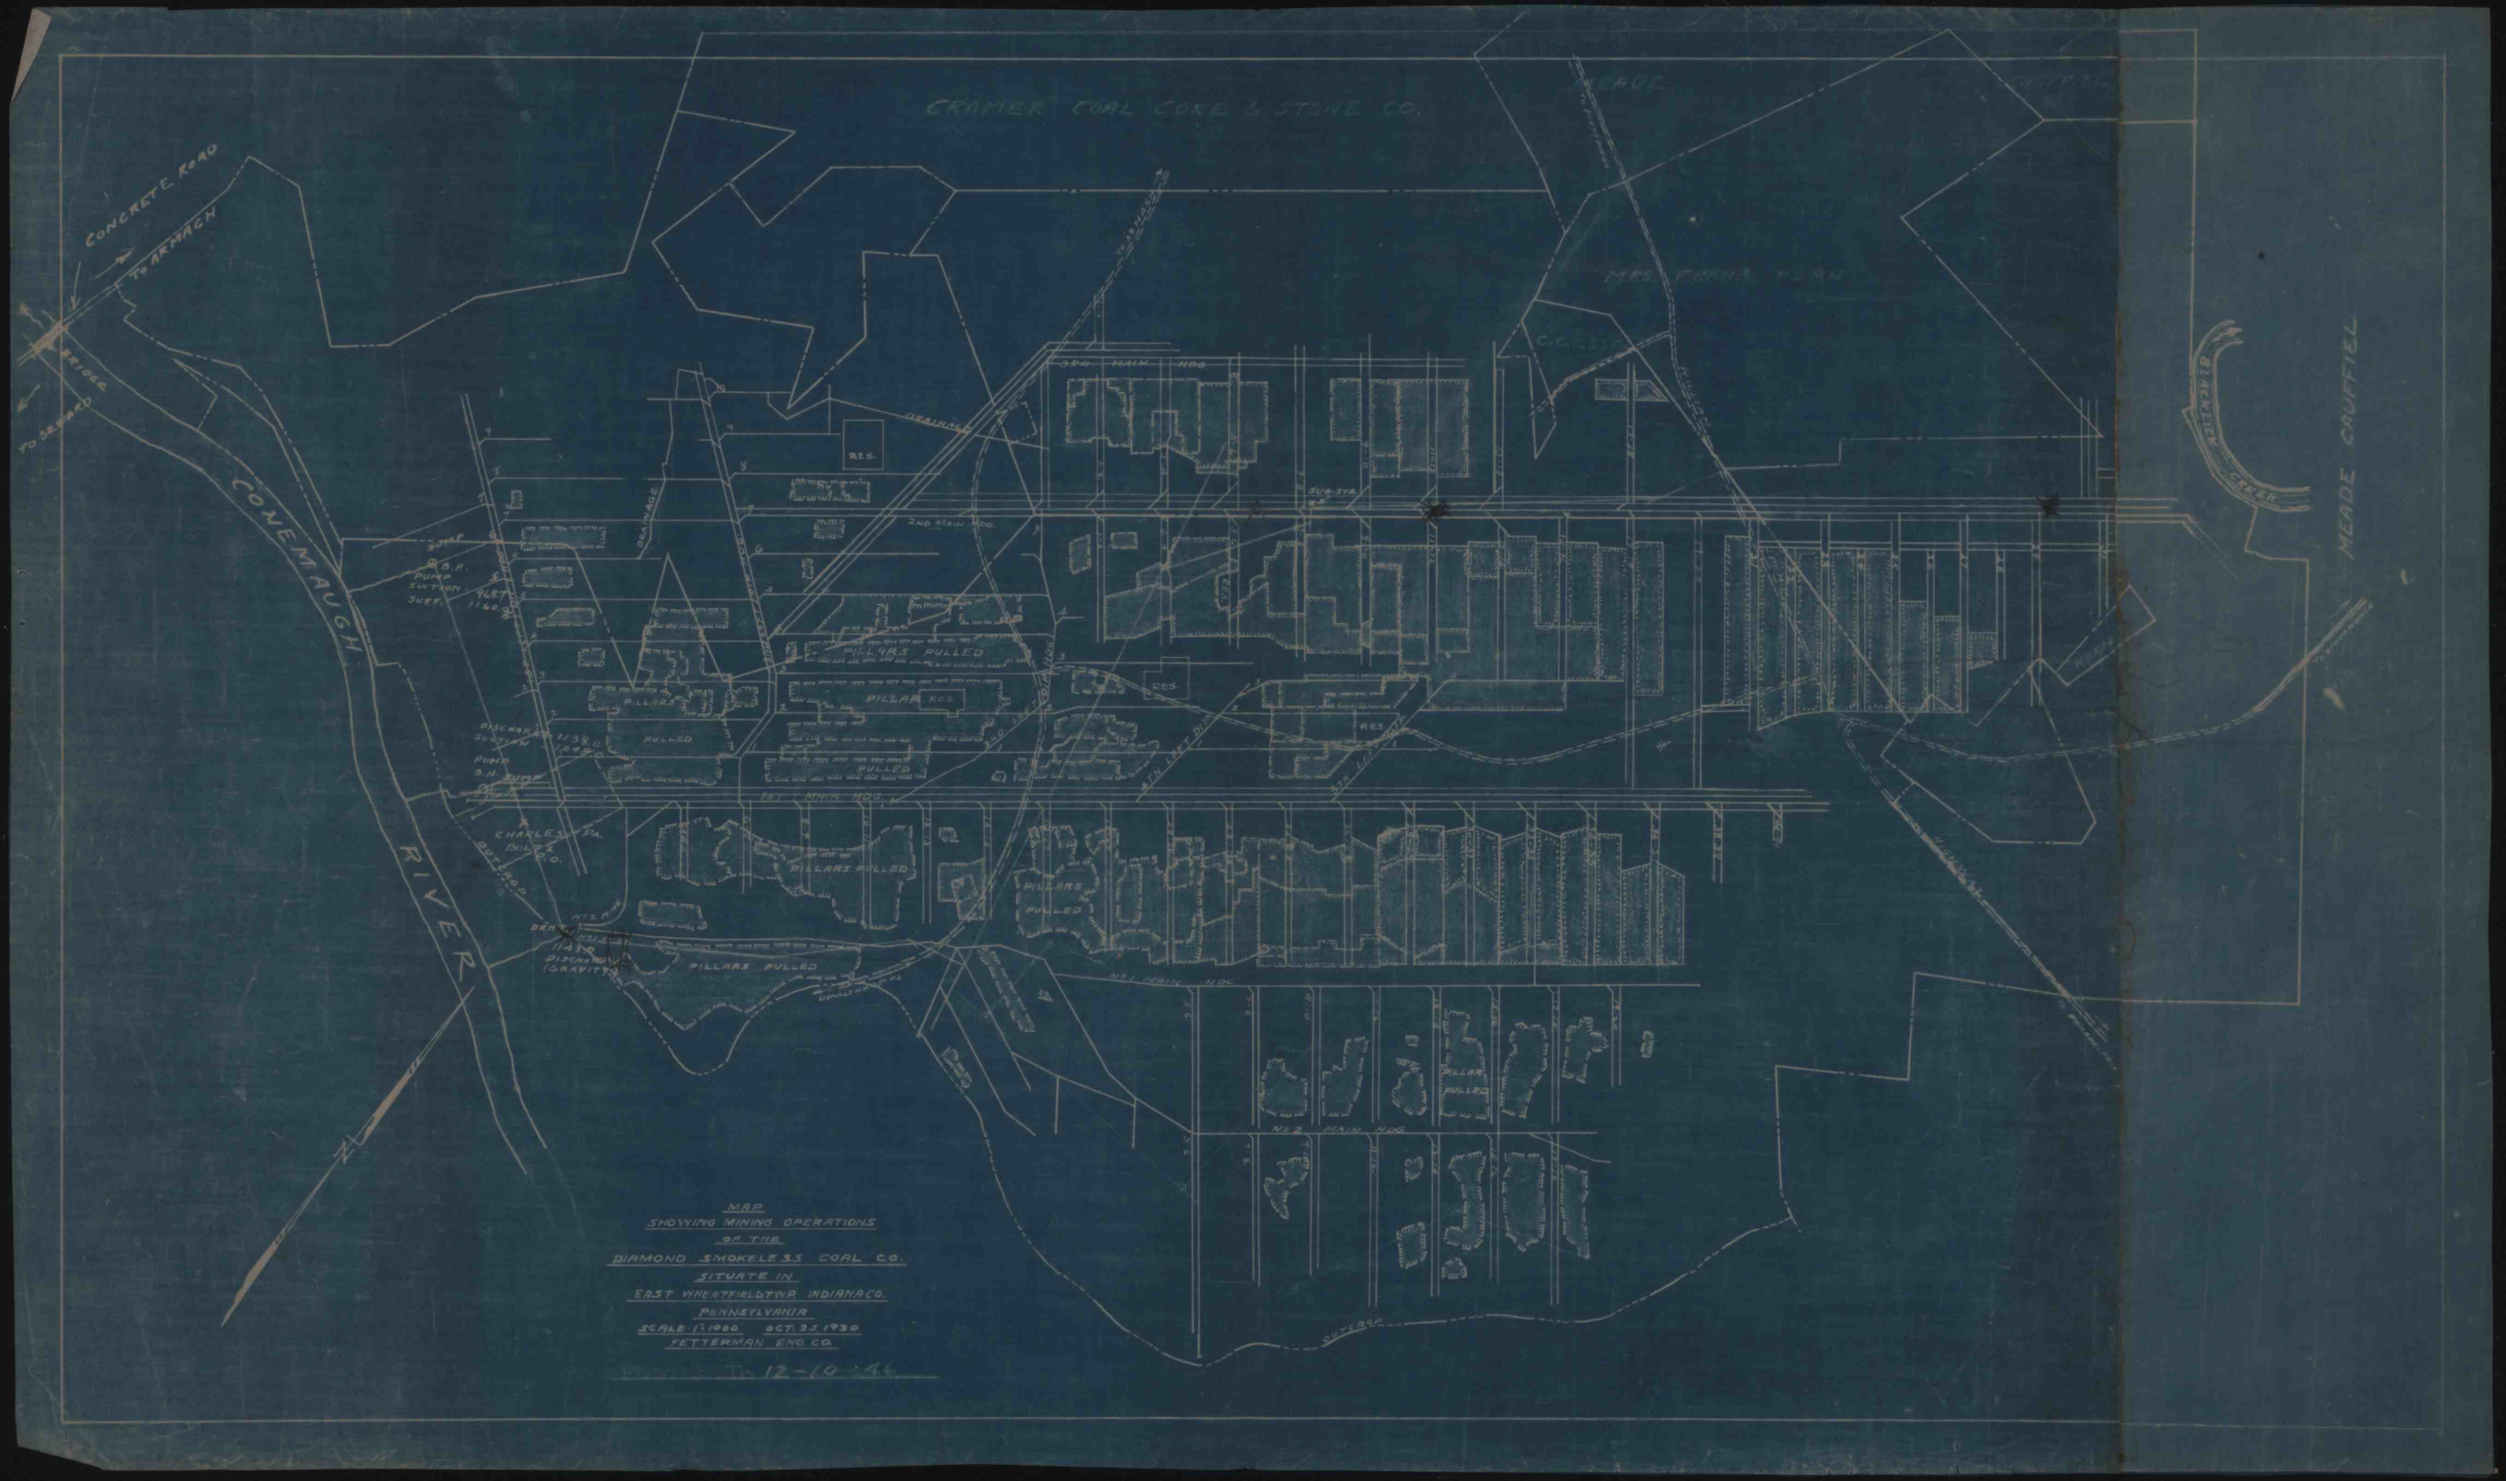
CRAMER COAL COKE & STONE CO.
CONCRETE ROAD
TO ARMAGH
BRIDGE
TO SEWARD
COVEMAUGH
RIVER
MEADE CRUFFIEL
BLACKLICK
CREEK
CAVE
MRS. FRANK PERRY
CEMETERY
3RD MAIN HDG.
2ND MAIN HDG.
1ST MAIN HDG.
NO. 2 MAIN HDG.
SUB-STA.
RES.
PILLARS PULLED
PILLAR
PULLED
B.H. PUMP SUCTION SUEF.
DISCHARGE SUCTION
PUMP
B.H. SUPER
CHARLES PA. BOLTS P.O.
DISCHARGE (GRAVITY)
OUTCROP
DRAINAGE
ROAD
MAP
SHOWING MINING OPERATIONS
OF THE
DIAMOND SMOKELESS COAL CO.
SITUATE IN
EAST WHEATFIELD TWP. INDIANA CO.
PENNSYLVANIA
SCALE 1" = 1000' OCT. 23 1930
FETTERMAN ENG. CO.
12-10-46