


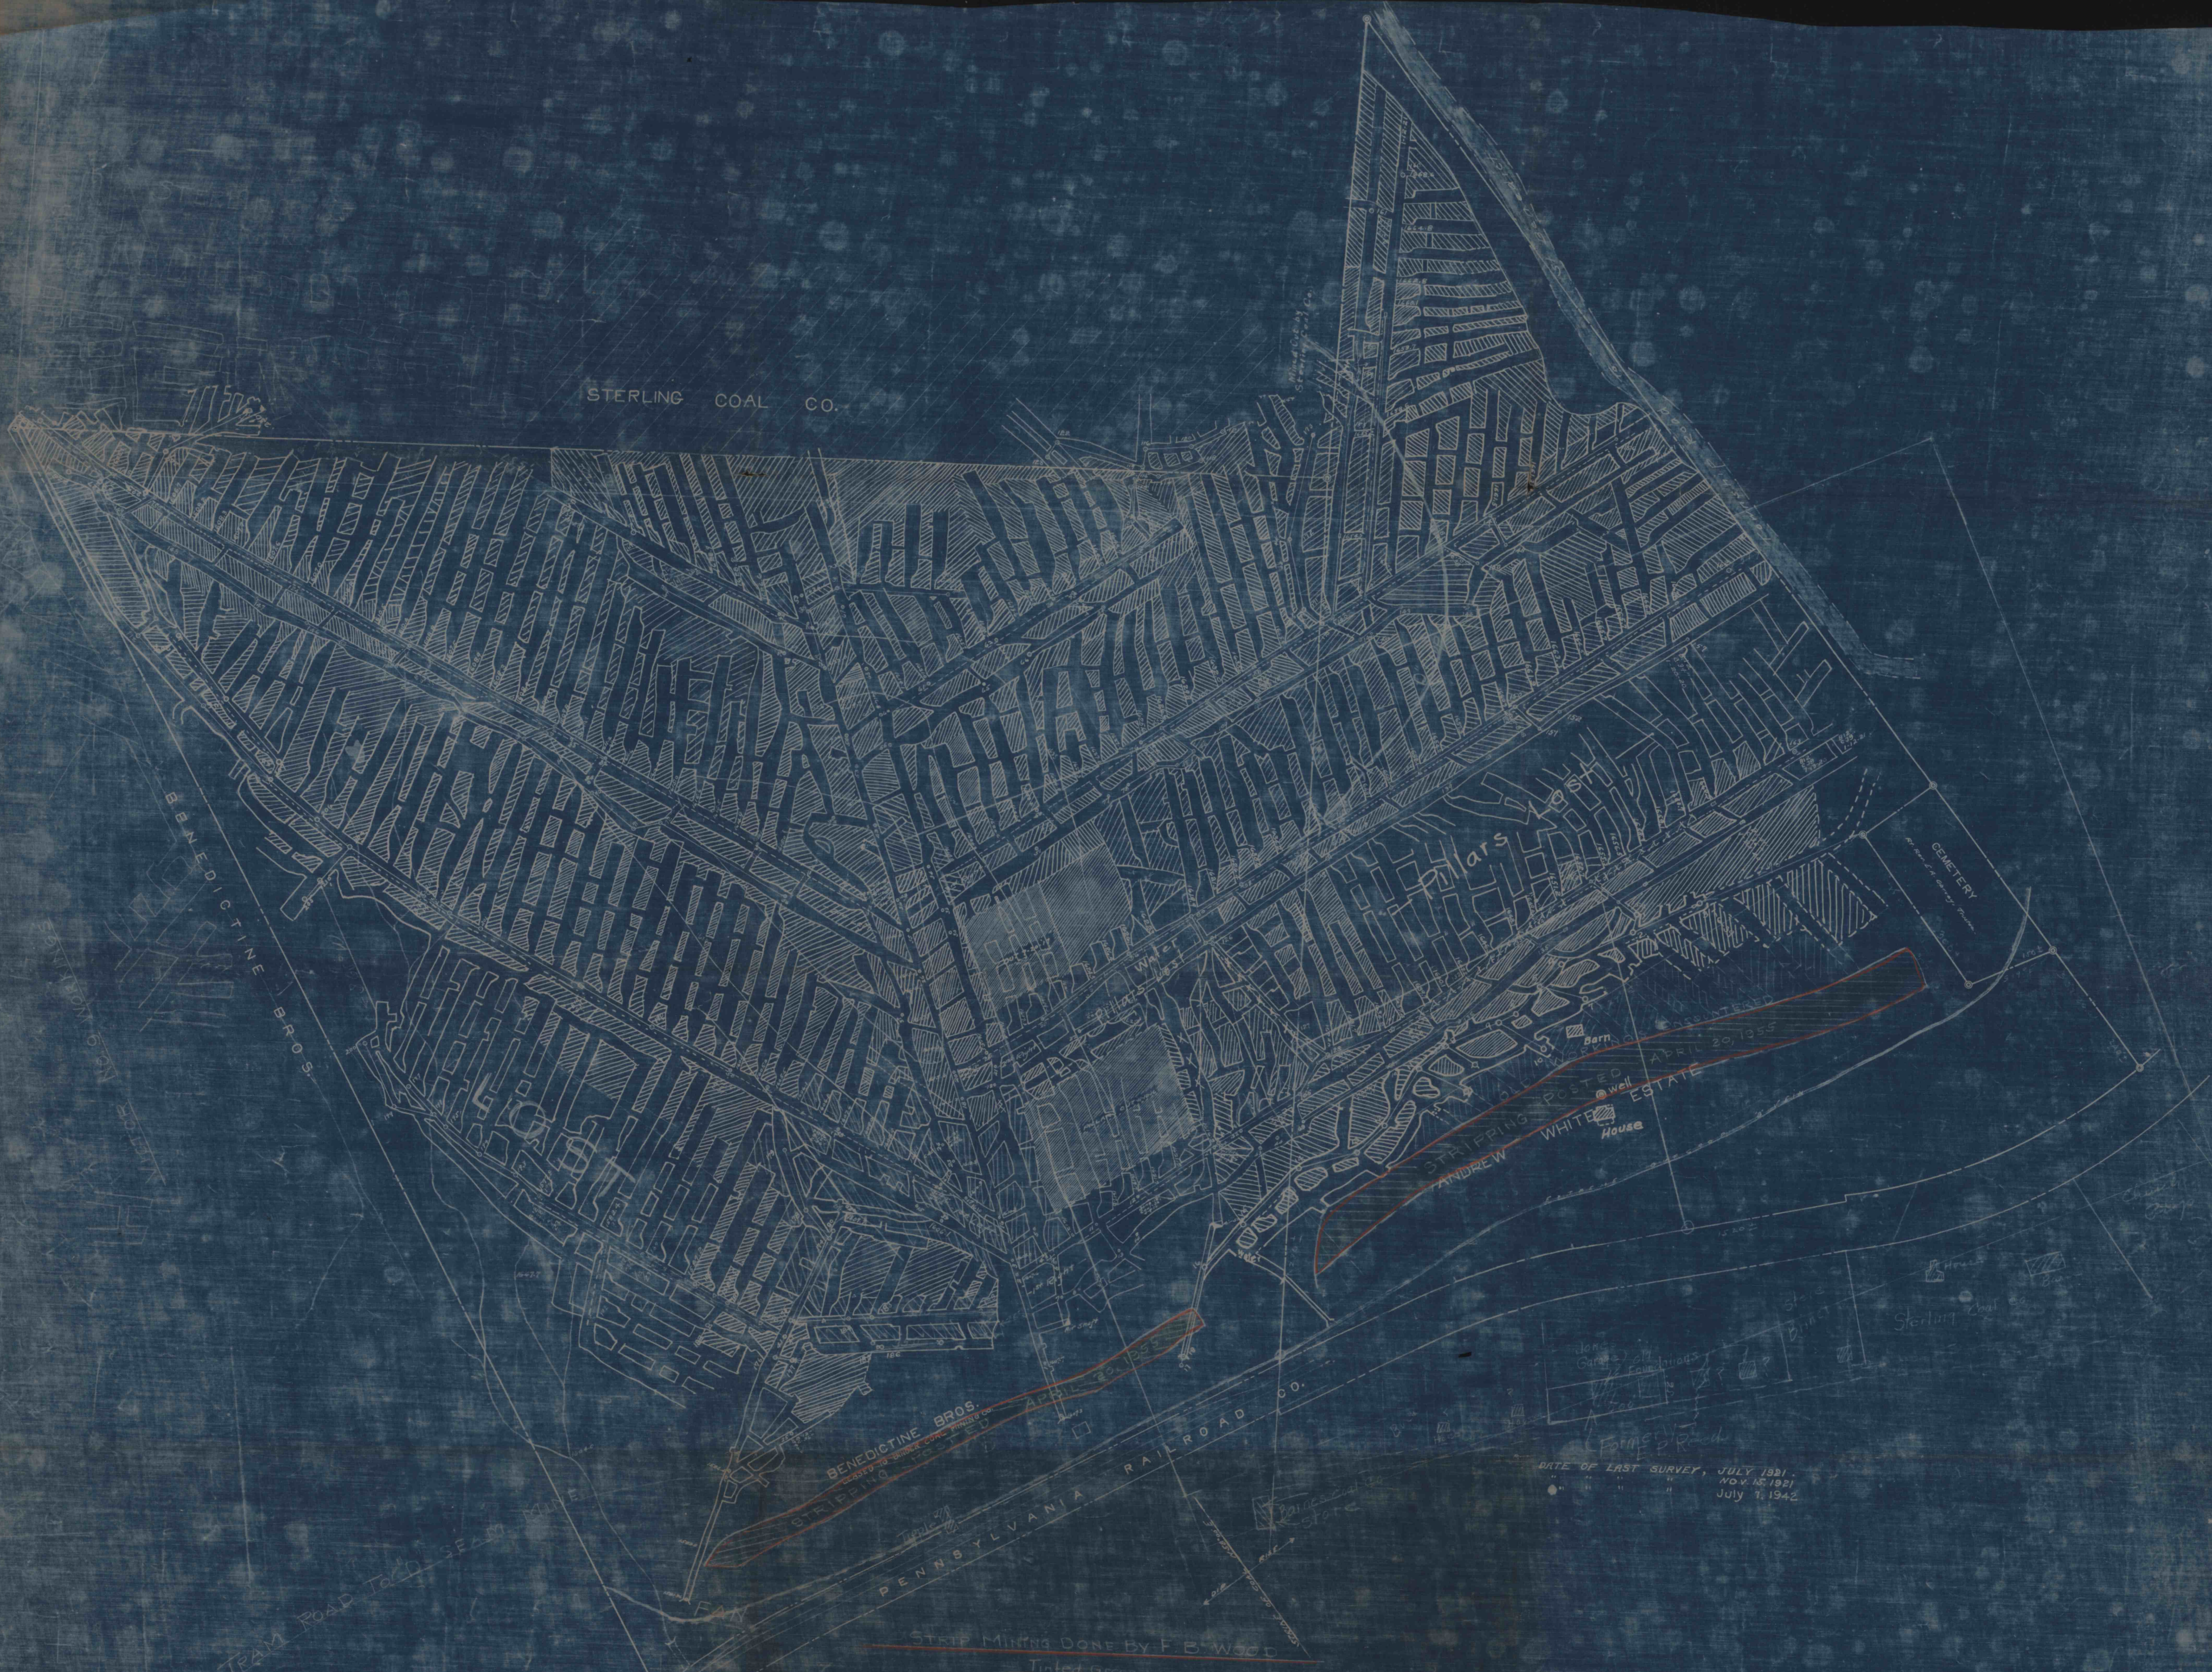

MAP
OF
BINDER COAL CO.'S
— MINE No. 1 —
NEAR
BAKERTON, PA.
SCALE 1"=100'
Martin & Kirsch, Engrs.

" " " " JULY 1, 1942

