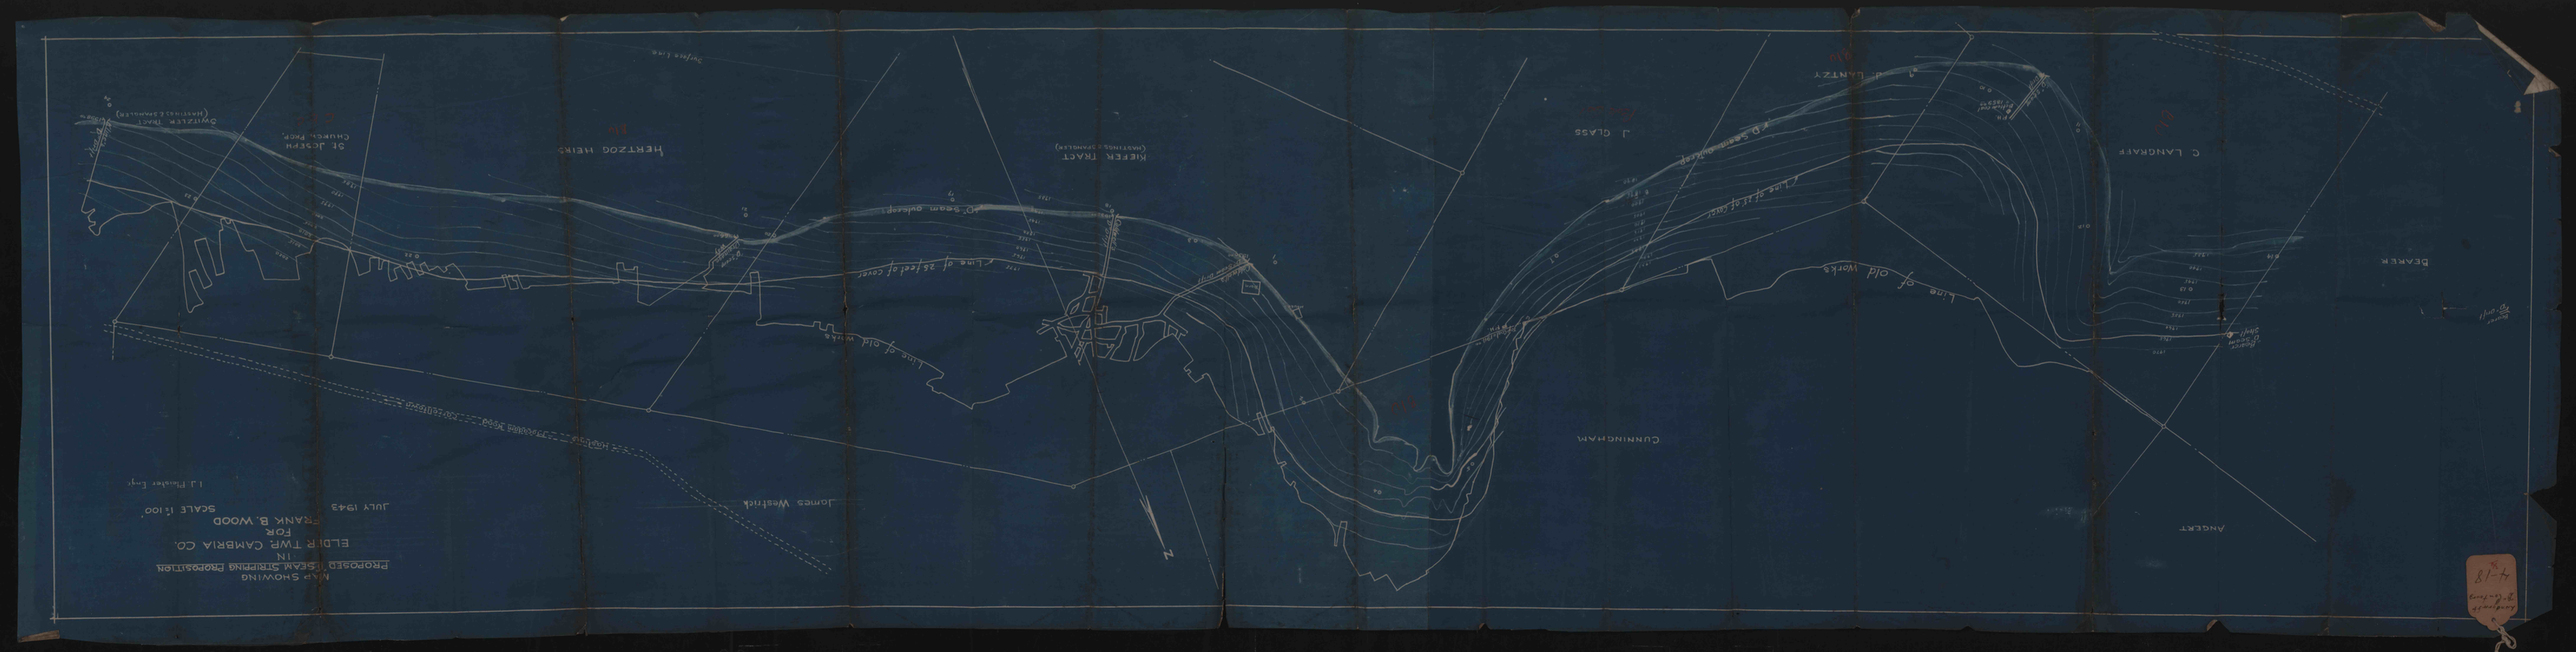

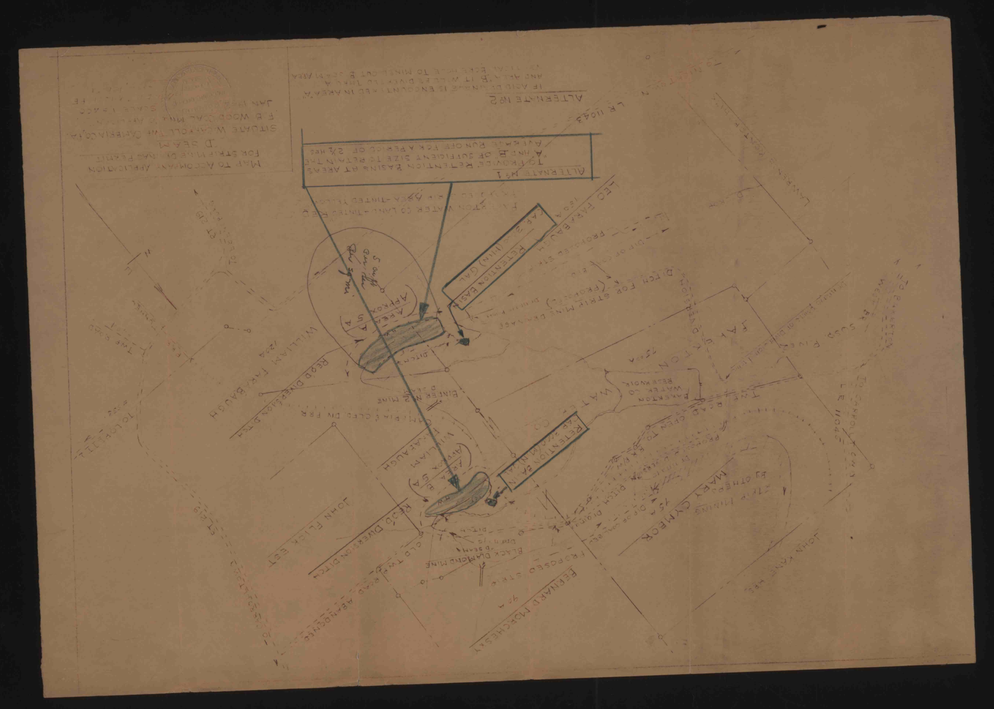

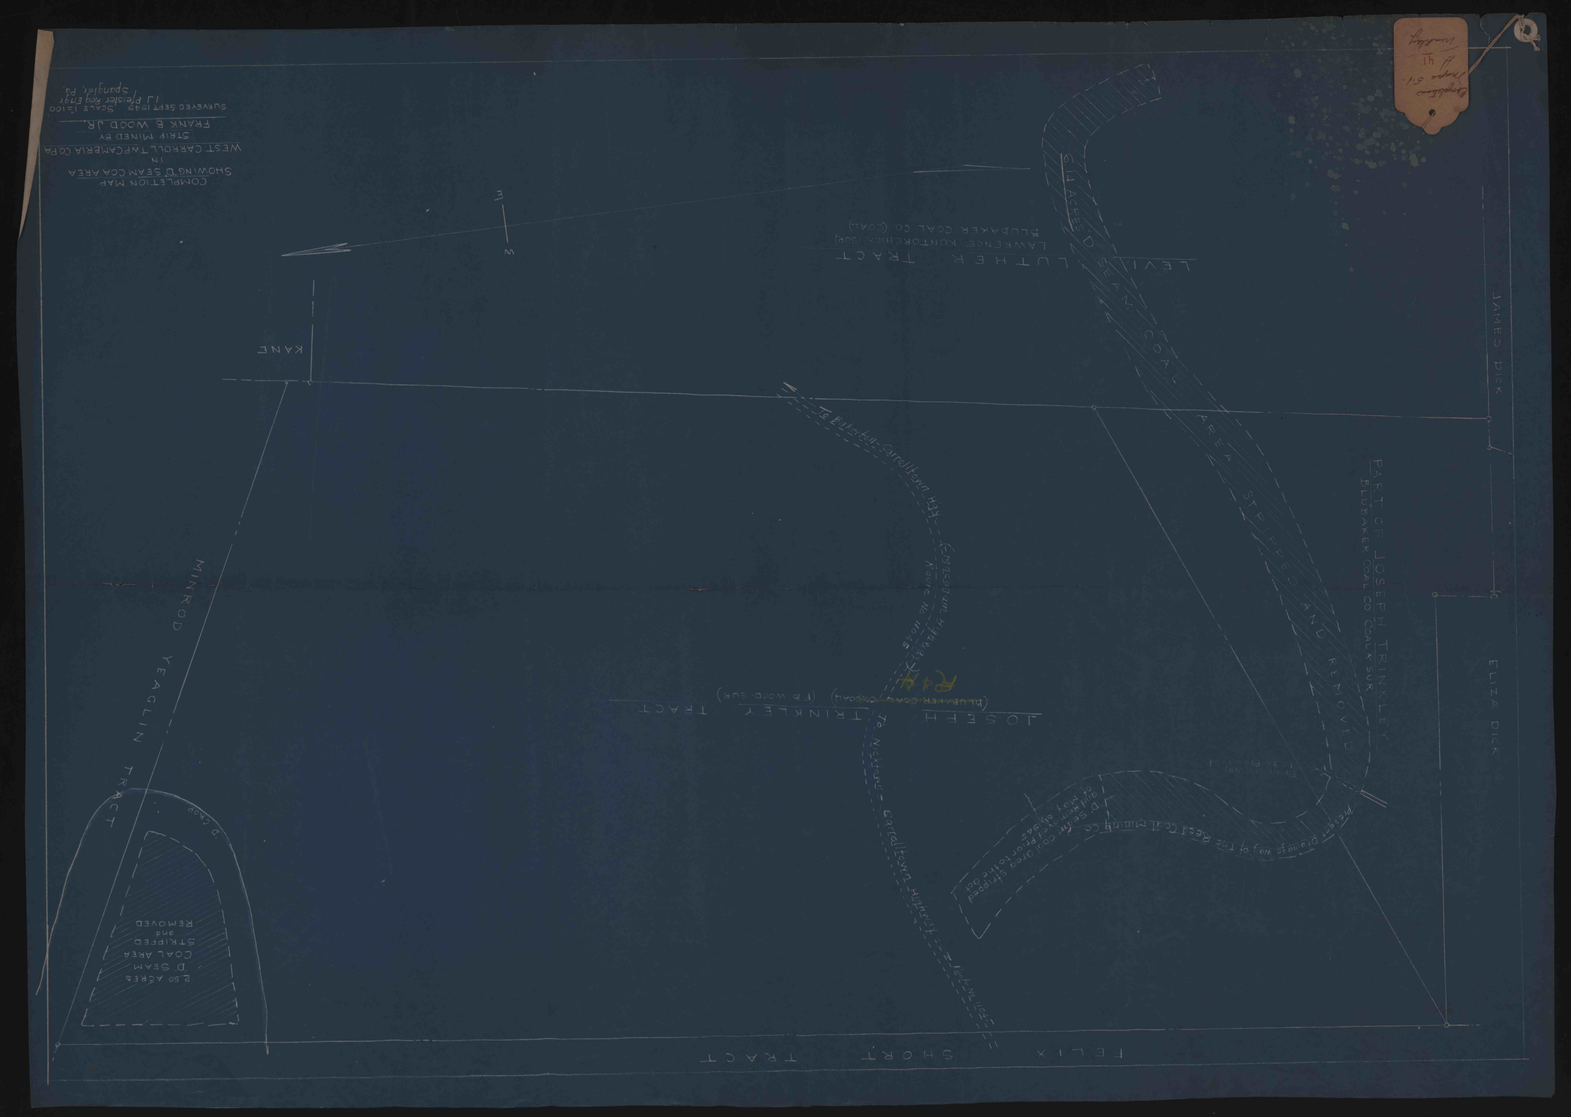
COMPLETION MAP
IN
L.J. Fisher Eng.
FELIX SHORT TRACT
KANE
