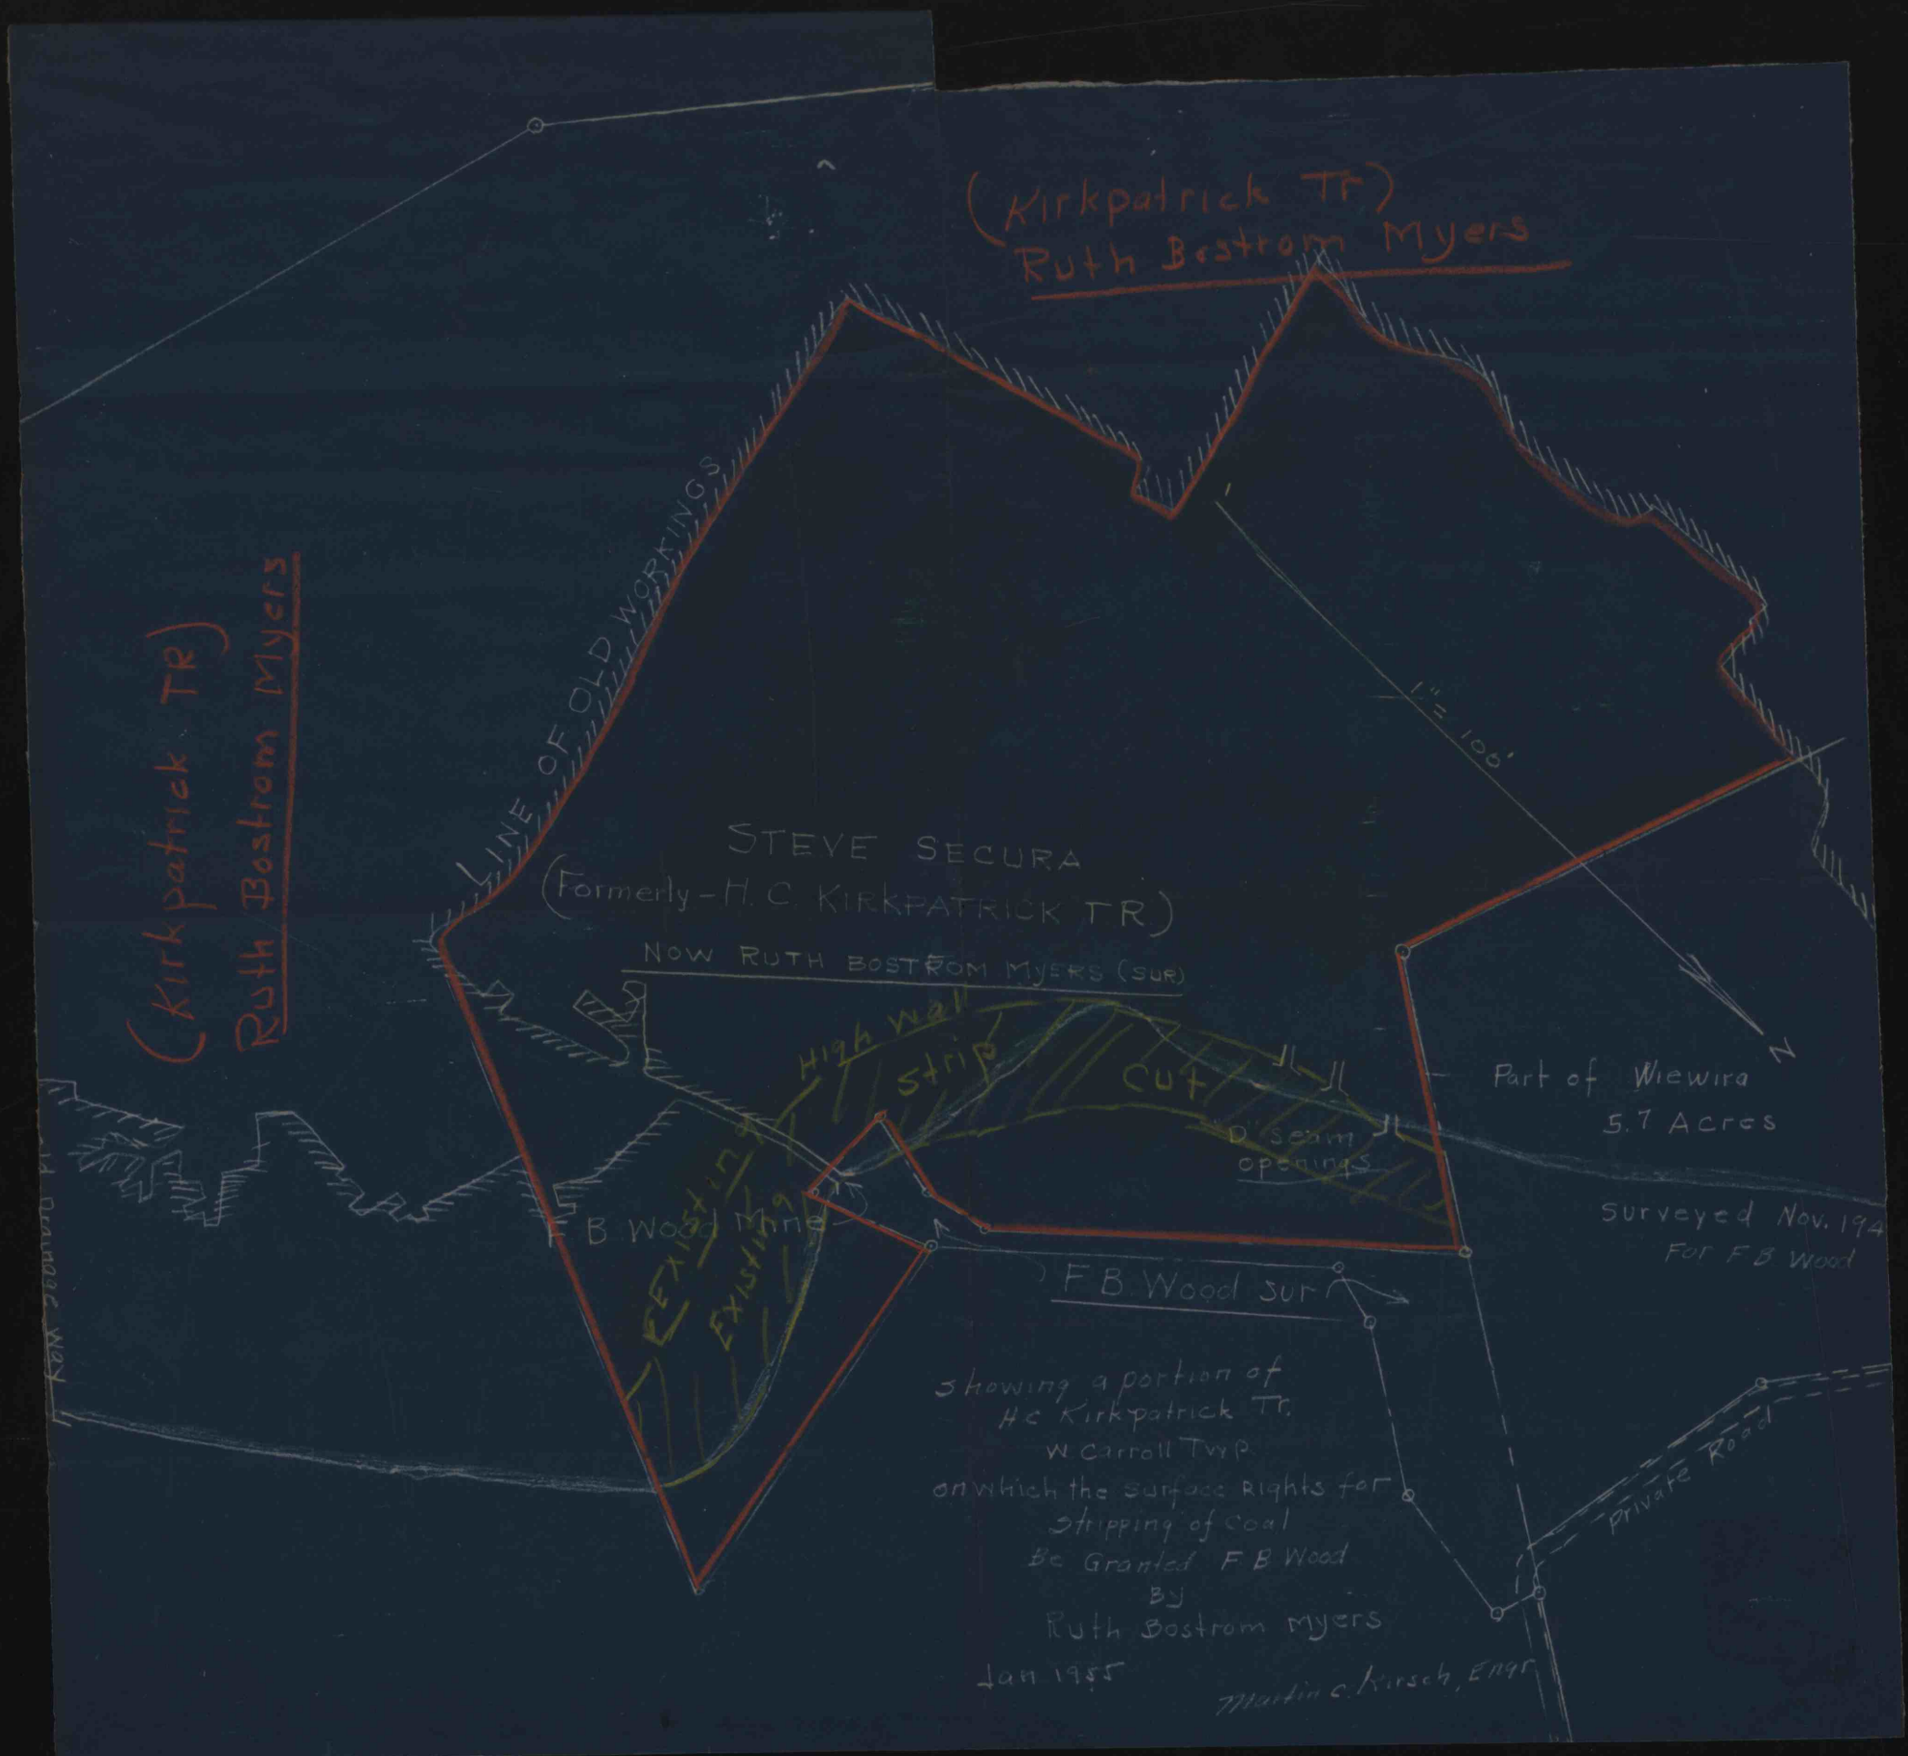
(Kirkpatrick TR)
Ruth Bostrom Myers
(Kirkpatrick TR)
Ruth Bostrom Myers
LINE OF OLD WORKINGS
1" = 100'
STEVE SECURA
(Formerly - H.C. KIRKPATRICK TR)
NOW RUTH BOSTROM MYERS (SUR)
High wall
strip
cut
D' Seam
openings
Part of Wiewira
5.7 Acres
Surveyed Nov. 194
For F B Wood
F B Wood mine
Existing
Existing
F.B. Wood Surf
Showing a portion of
Hc Kirkpatrick Tr.
W. Carroll Twp.
on which the surface Rights for
Stripping of Coal
Be Granted F.B. Wood
By
Ruth Bostrom Myers
Jan 1955
Martin C. Kirsch, Engr
Private Road