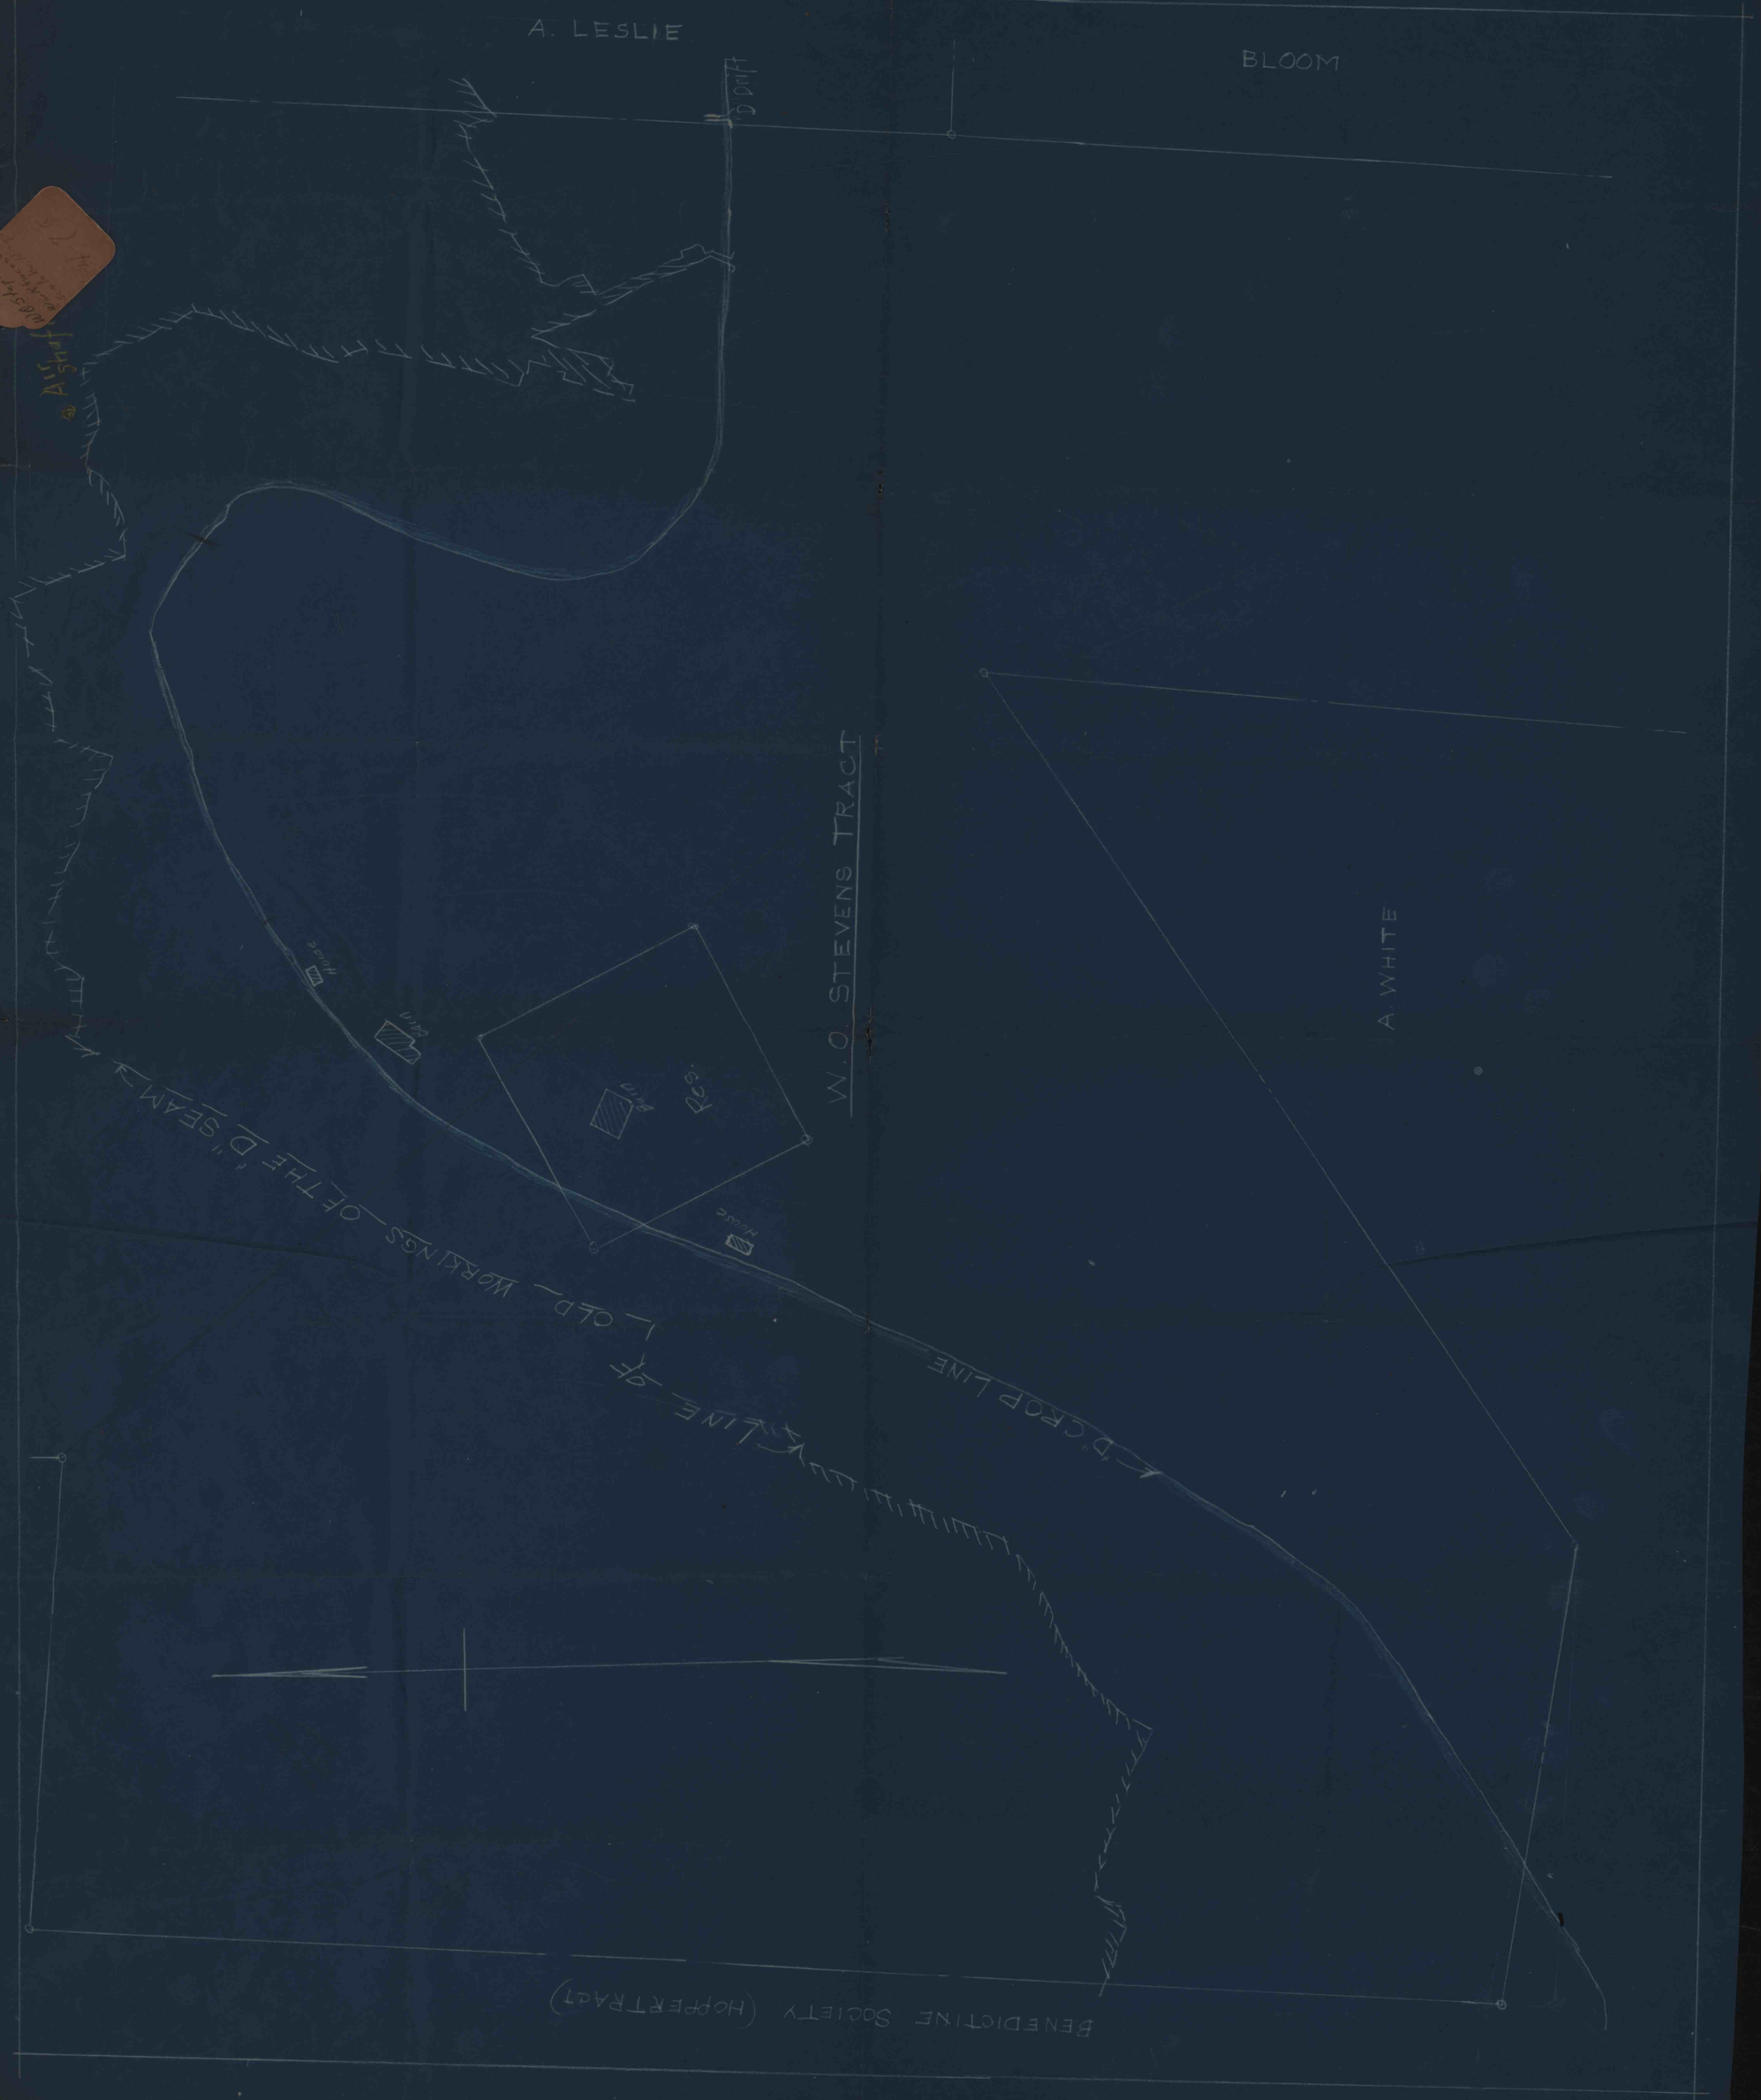
BENEDICTINE SOCIETY (HOPPERTRAUT)
OLD WORKINGS OF THE "D" SEAM
D. CROP LINE
STEVENS TRACT
A. WHITE
A. LESLIE
BLOOM
House
Barn
House
Barn
Drift