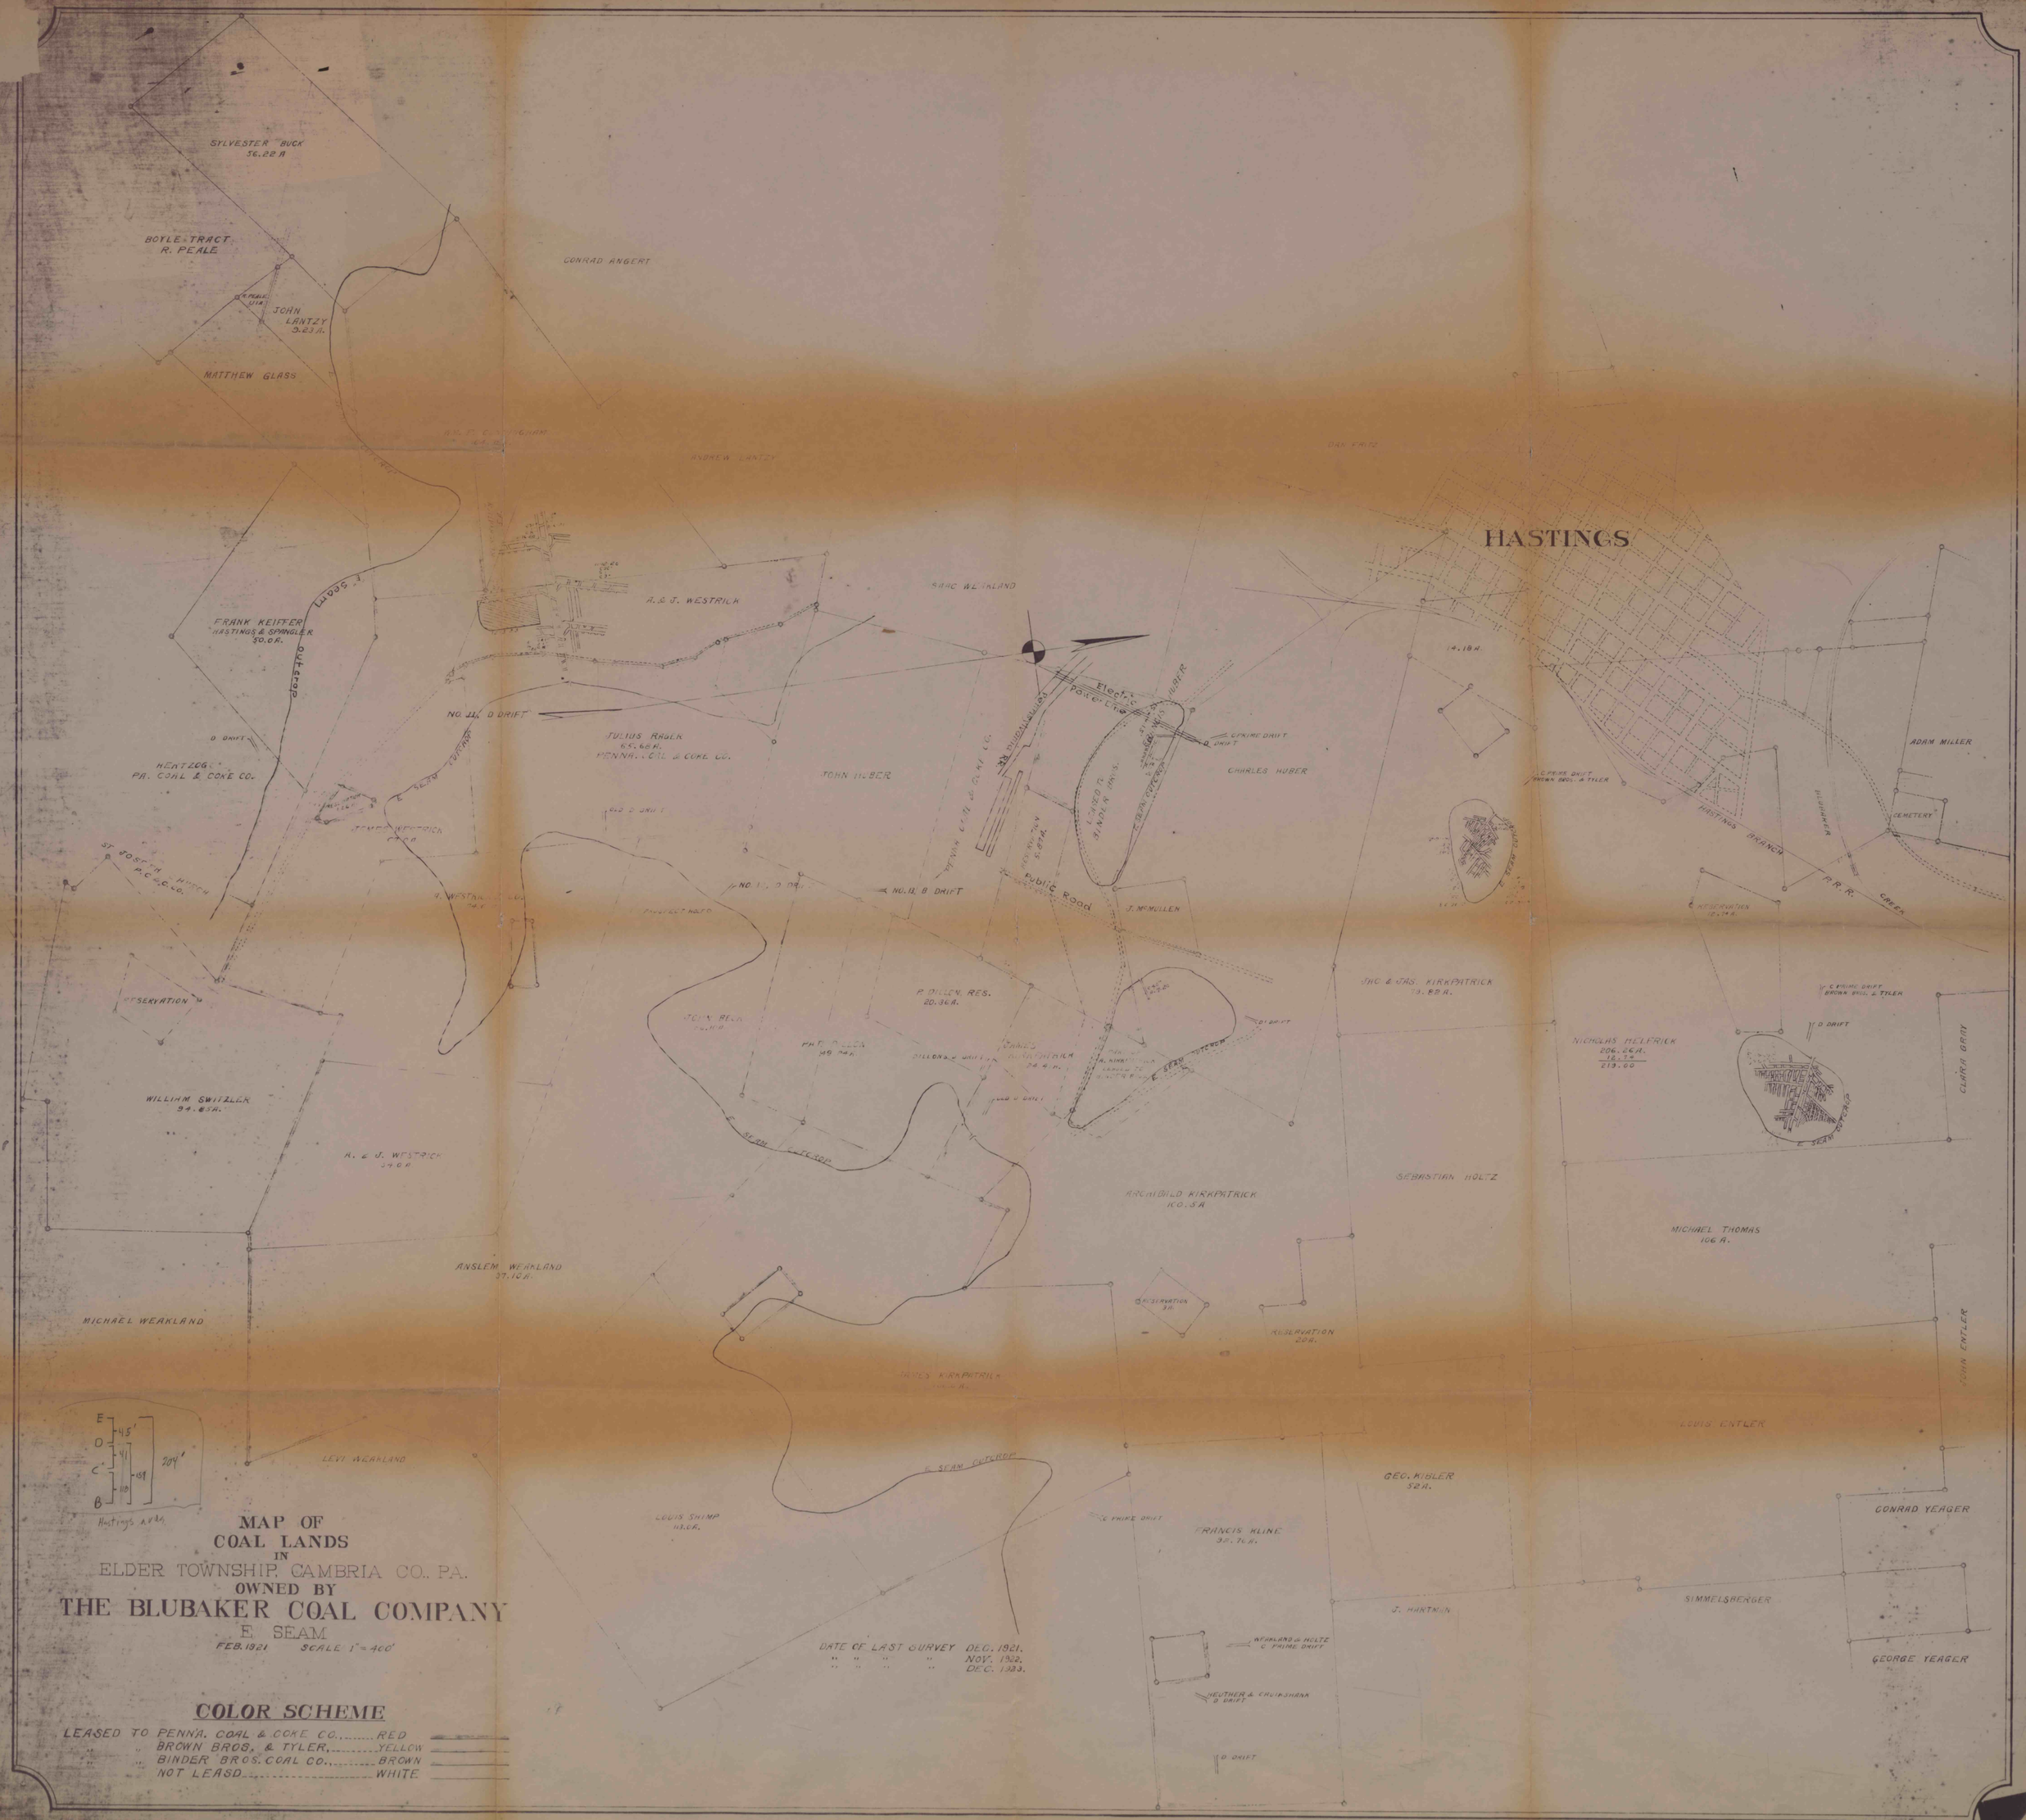

MAP OF COAL LANDS IN ELDER TOWNSHIP, CAMBRIA CO., PA. OWNED BY THE BLUBAKER COAL COMPANY

E. SEAM

FEB. 1921 SCALE 1" = 400'

COLOR SCHEME

LEASED TO PENNA. COAL & COKE CO. ..... RED

" BROWN BROS. & TYLER, ... YELLOW

" BINDER BROS. COAL CO., ... BROWN

NOT LEASD ..... WHITE

DATE OF LAST SURVEY DEC. 1921.
" " " " NOV. 1922.
" " " " DEC. 1923.