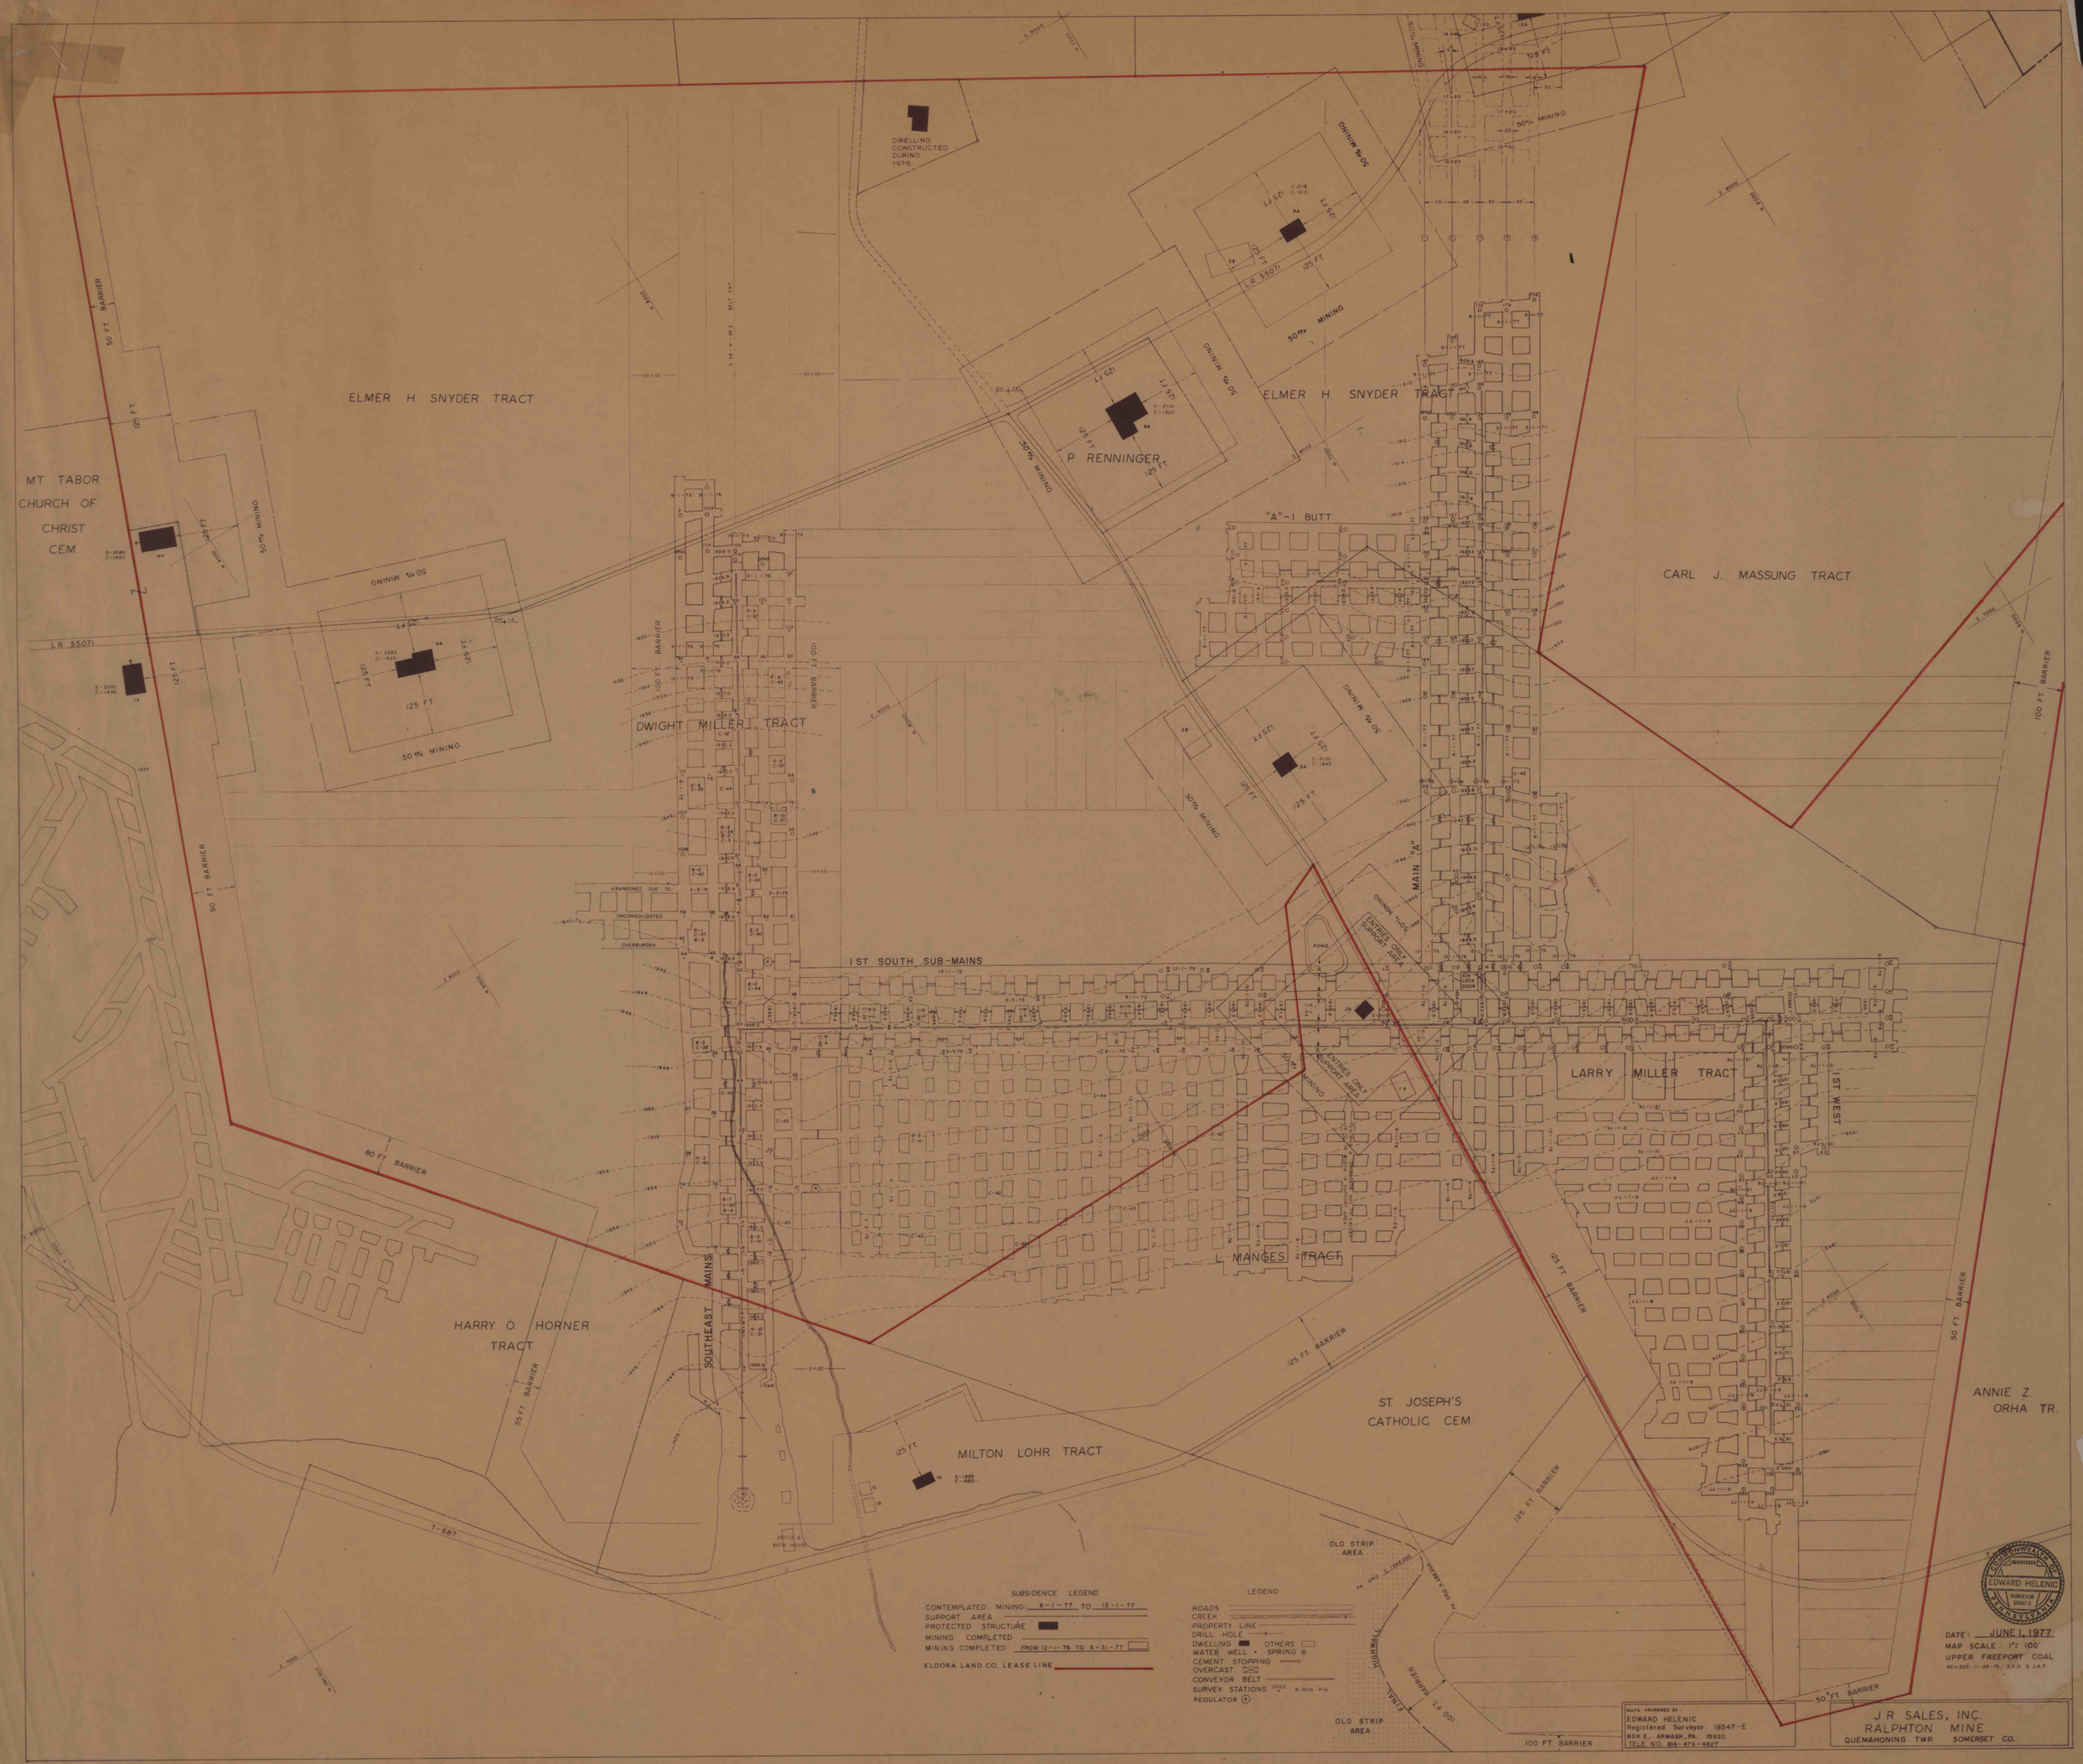
ELMER H. SNYDER TRACT
MT. TABOR CHURCH OF CHRIST CEM.
DWELLING CONSTRUCTED DURING 1976
P. RENNINGER
ELMER H. SNYDER TRACT
CARL J. MASSUNG TRACT
"A"-1 BUTT
DWIGHT MILLER TRACT
1ST SOUTH SUB-MAINS
MAIN "A"
LARRY MILLER TRACT
1ST WEST
L. MANGES TRACT
HARRY O. HORNER TRACT
SOUTHEAST MAINS
MILTON LOHR TRACT
ST. JOSEPH'S CATHOLIC CEM.
ANNIE Z. ORHA TR.
OLD STRIP AREA
SUBSIDENCE LEGEND
CONTEMPLATED MINING: 6-1-77 TO 12-1-77
SUPPORT AREA
PROTECTED STRUCTURE
MINING COMPLETED
MINING COMPLETED: FROM 12-1-76 TO 5-31-77
ELDORA LAND CO. LEASE LINE
LEGEND
ROADS
CREEK
PROPERTY LINE
DRILL HOLE
DWELLING
OTHERS
WATER WELL
SPRING
CEMENT STOPPING
OVERCAST
CONVEYOR BELT
SURVEY STATIONS
IRON PIN
REGULATOR
MAPS PREPARED BY
EDWARD HELENIC
Registered Surveyor 19347-E
BOX E, ARMAGH, PA. 15920
TELE. NO. 814-479-4827
EDWARD HELENIC
DATE: JUNE 1, 1977
MAP SCALE: 1" = 100'
UPPER FREEPORT COAL
J R SALES, INC.
RALPHTON MINE
QUEMAHONING TWP. SOMERSET CO.