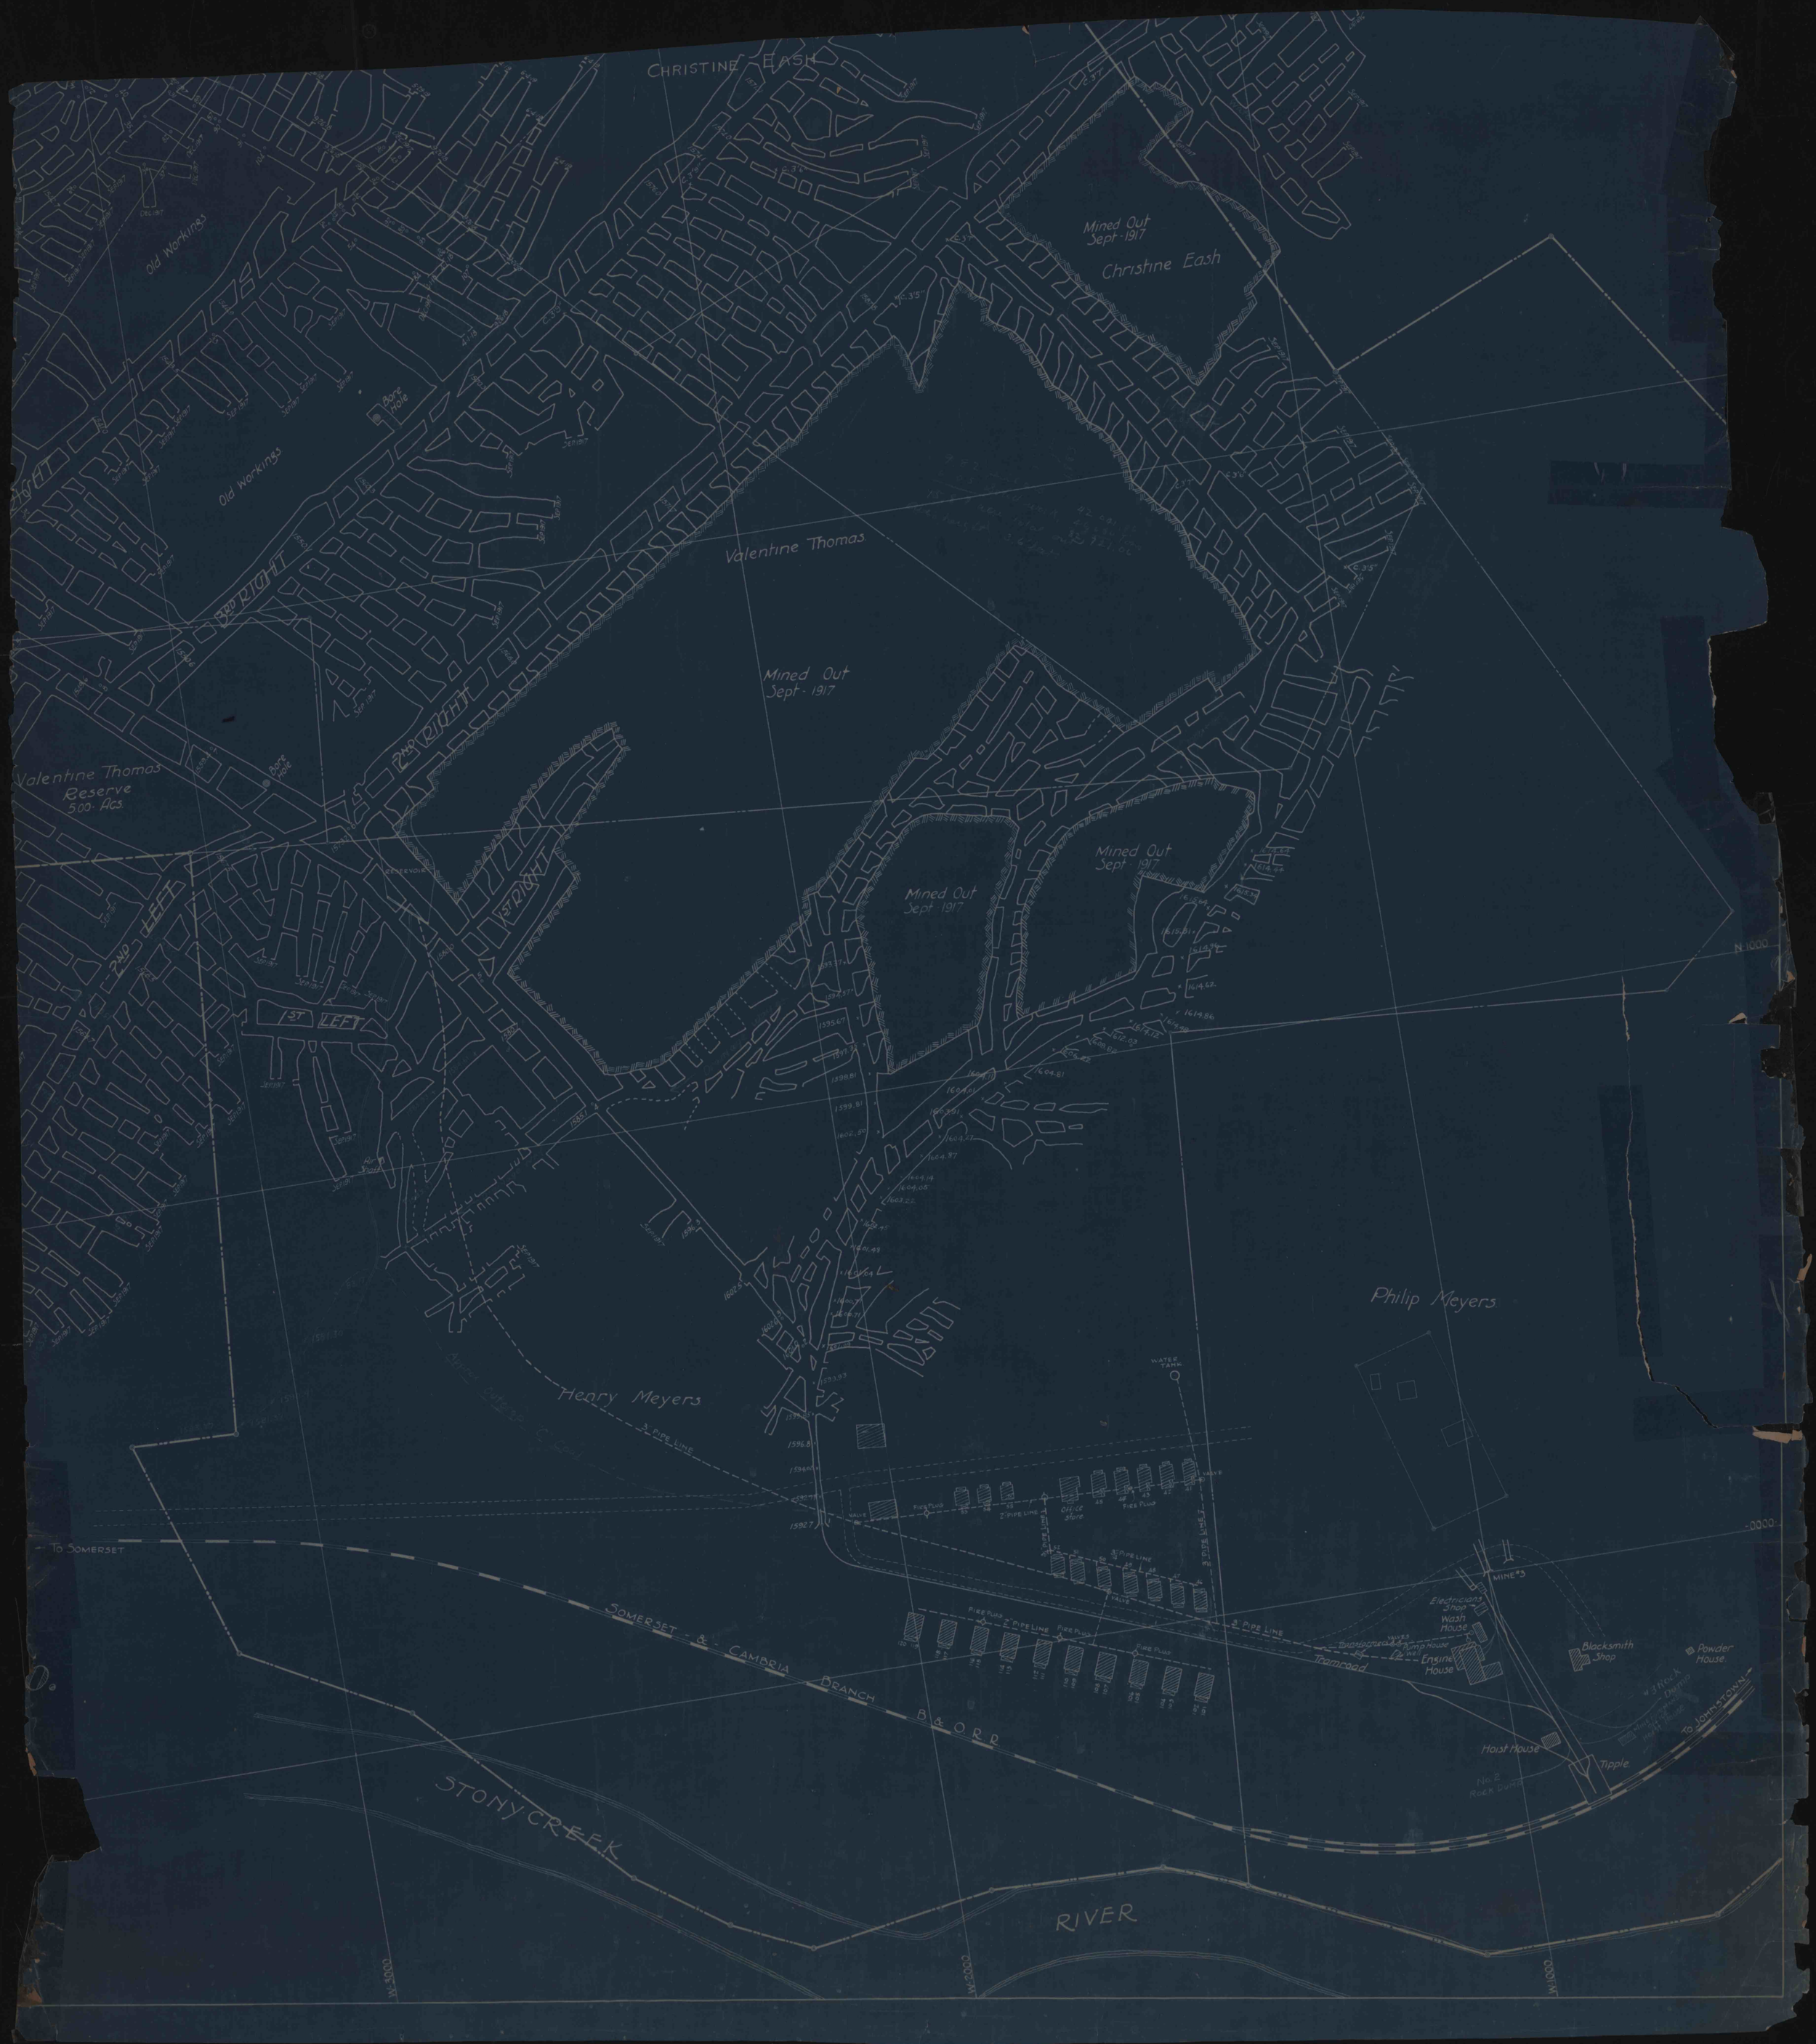
CHRISTINE EASH
Mined Out
Sept - 1917
Christine Eash
Old Workings
Old Workings
Bore Hole
Valentine Thomas
Mined Out
Sept - 1917
Valentine Thomas
Reserve
500 Acs.
Bore Hole
2ND RIGHT
1ST RIGHT
2ND LEFT
1ST LEFT
RESERVOIR
Mined Out
Sept - 1917
Mined Out
Sept - 1917
N-1000
Philip Meyers
Henry Meyers
3" PIPE LINE
WATER TANK
FIRE PLUG
VALVE
2" PIPE LINE
OFFICE
STORE
3" PIPE LINE
TO SOMERSET
SOMERSET & CAMBRIA BRANCH B & O R.R.
MINE #3
Electricians Shop
Wash House
Pump House
Ensine House
Tramroad
Blacksmith Shop
Powder House
Rock Dump
Hoist House
Tipple
No. 2 Rock Dump
TO JOHNSTOWN
STONY CREEK
RIVER
W-3000
W-2000
W-1000