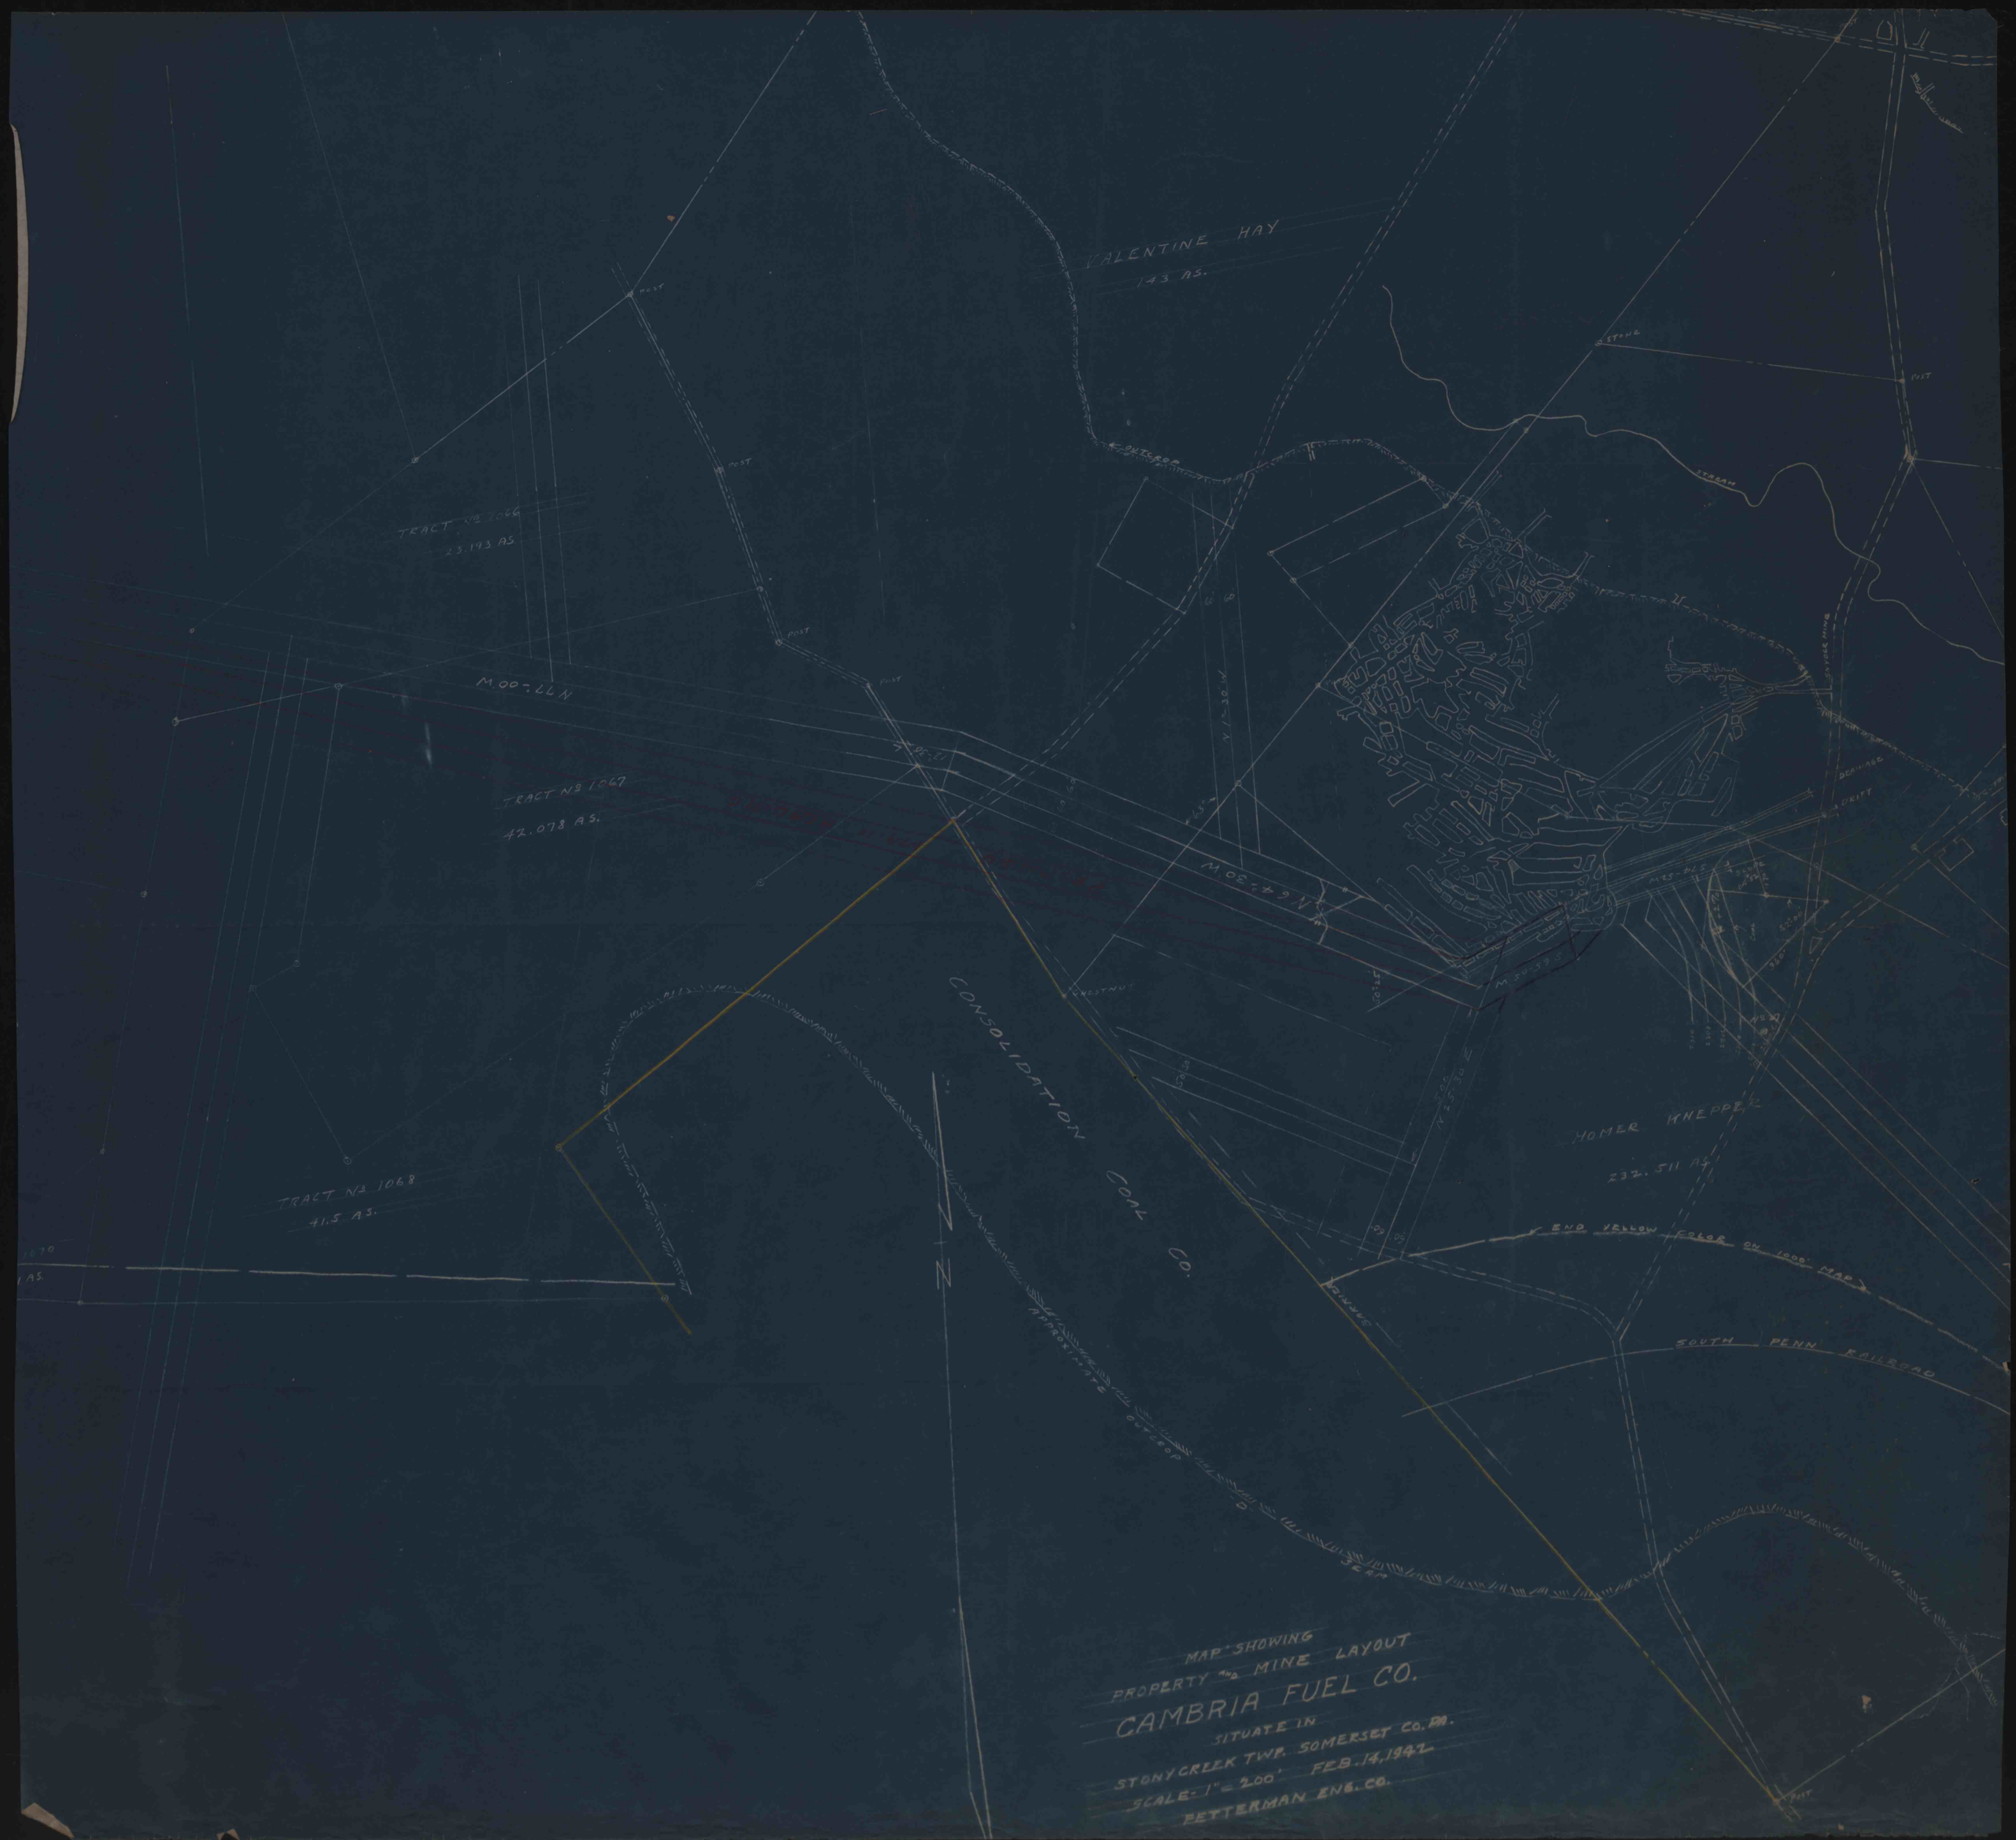
VALENTINE HAY
143 AS.
TRACT Nº 1066
23.193 AS.
TRACT Nº 1067
42.078 AS.
TRACT Nº 1068
41.5 AS.
CONSOLIDATION COAL CO.
HOMER KNEPPER
232.511 AS.
END YELLOW COLOR ON 1000' MAP
SOUTH PENN RAILROAD
STONY CREEK
STONE
POST
CHESTNUT
DERRICK
DRIFT
MAP SHOWING
PROPERTY AND MINE LAYOUT
CAMBRIA FUEL CO.
SITUATE IN
STONYCREEK TWP. SOMERSET CO. PA.
SCALE-1" = 200' FEB. 14, 1942
PETTERMAN ENG. CO.