


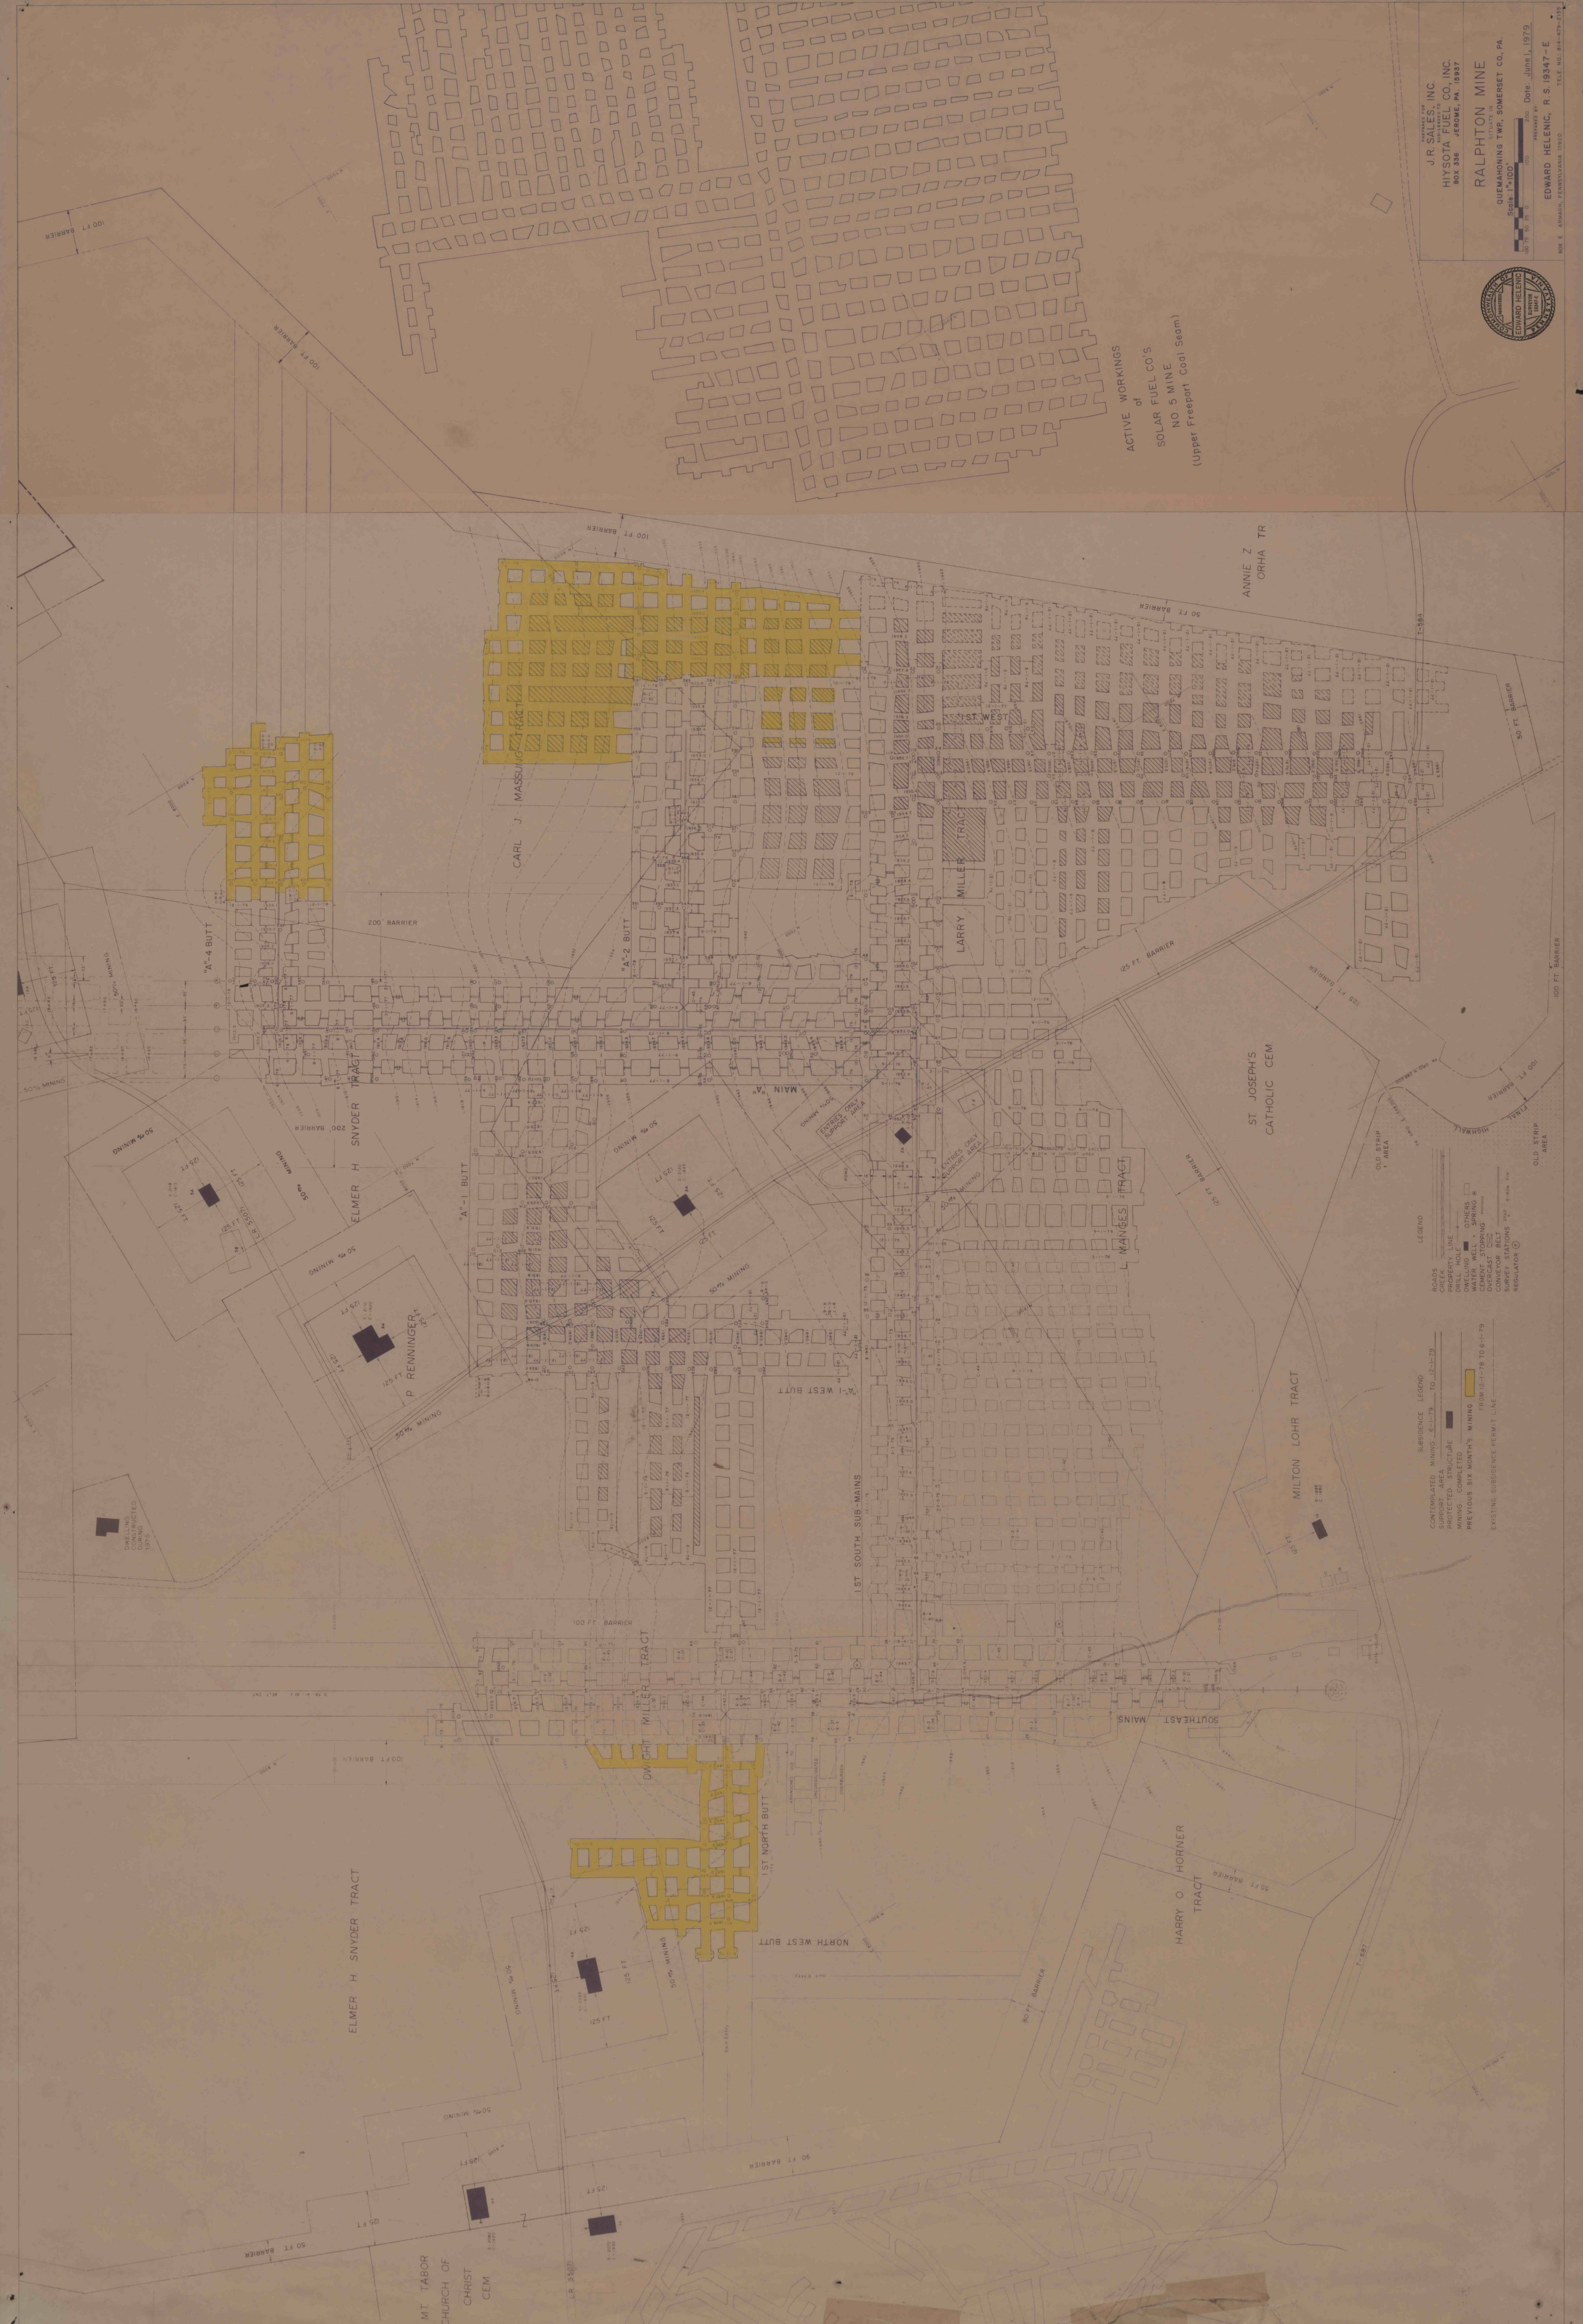

ACTIVE WORKINGS
of
SOLAR FUEL CO.'S
NO. 5 MINE
(Upper Freeport Coal Seam)

ANNIE Z
ORHA TR

ST. JOSEPH'S
CATHOLIC CEM

MILTON LOHR TRACT

HARRY O. HORNER
TRACT

ELMER H. SNYDER TRACT

MT. TABOR
CHURCH OF
CHRIST
CEM

DWIGHT MILLER TRACT

CARL J. MASSUNG TRACT

1ST SOUTH SUB-MAINS

NORTH WEST BUTT

1ST NORTH BUTT

50% MINING

50% MINING

50% MINING

50% MINING

50% MINING

50% MINING

50% MINING

50% MINING

50% MINING

50% MINING

50% MINING

50% MINING

PREPARED BY
JR SALES, INC.
HIYOTA FUEL CO., INC.
BOX 338
JEROME, PA. 16937

DATE: June 1, 1979
SCALE: 1"=100'

EDWARD HELENIC, R. S. 9347-E
BOE E. ANNAH, FERRYMAN 1980

RALPHTON MINE
QUEMANONG TWP., SOMERSET CO., PA.

LEGEND

ROADS
CREEK
PROPERTY LINE
DRILL HOLE
WATER
CEMENT STOPPING
CONVEYOR BELT
SURVEY STATIONS
REGULATOR

SUBSISTENCE LEGEND

CONTINGENT MINING 6-1-79 TO 12-31-79
MINING COMPLETED
PREVIOUS SIX MONTHS MINING
EXISTING SUBSISTENCE PERMIT LINE