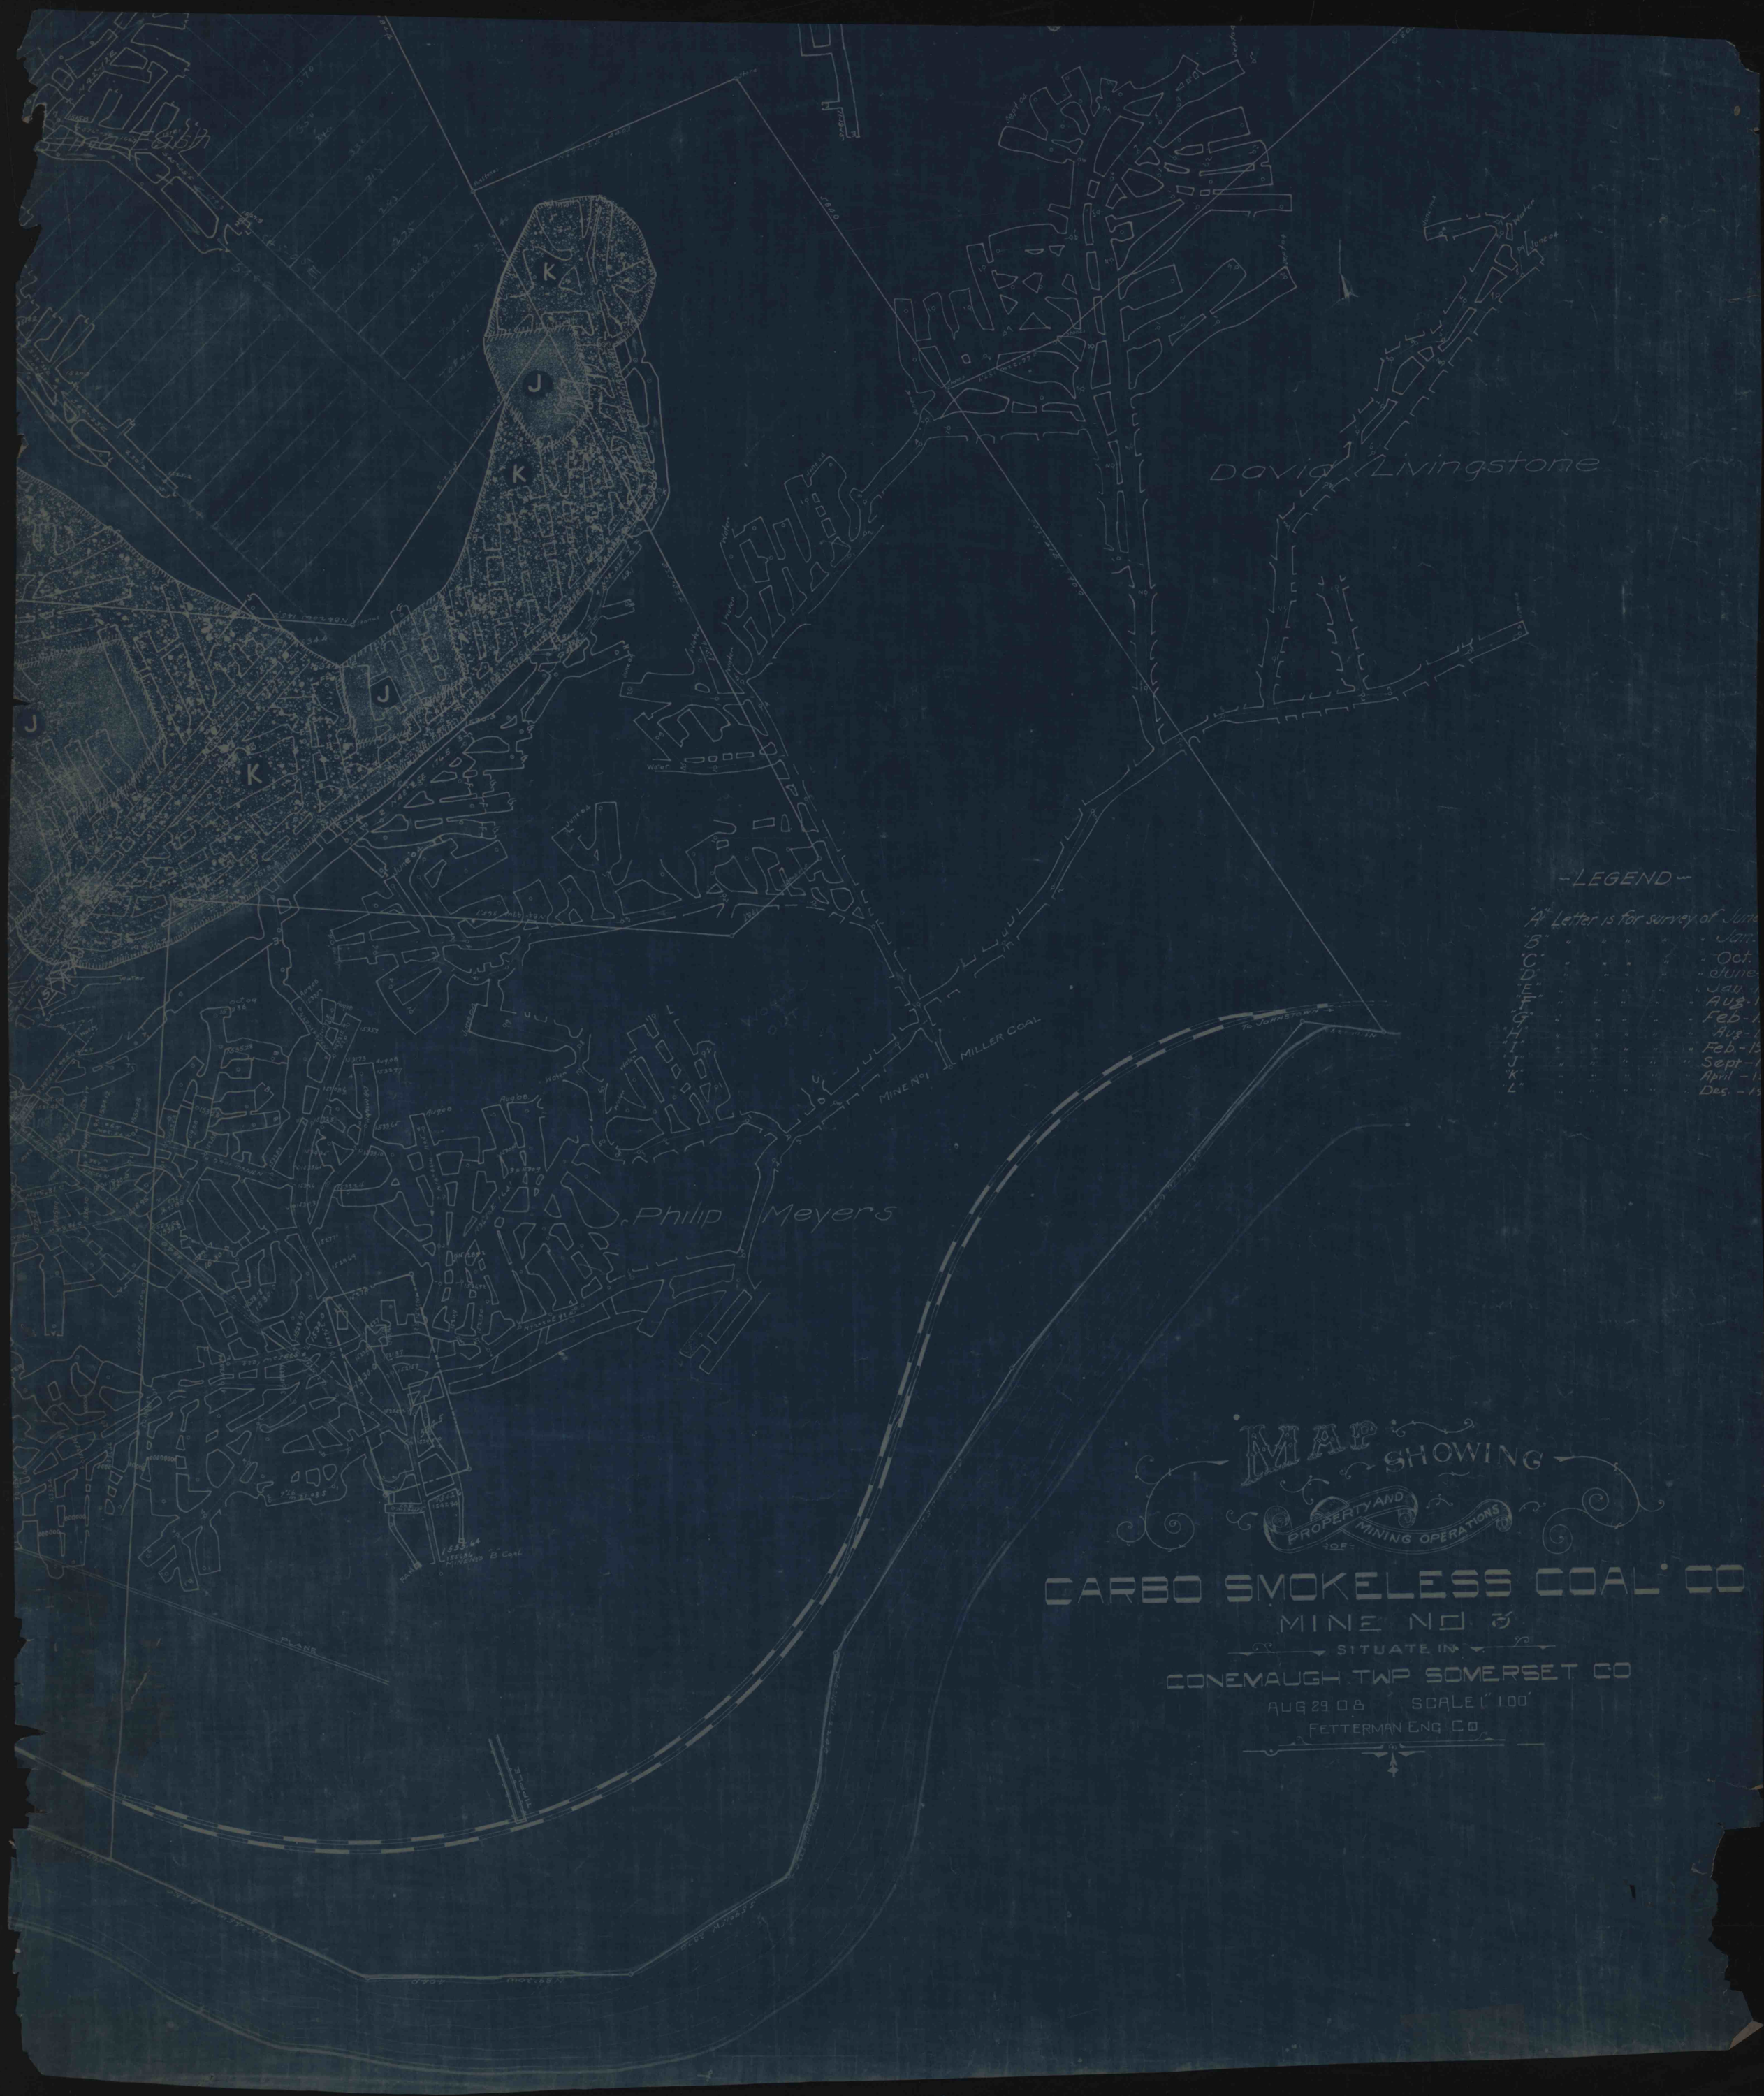
K
J
K
J
K
David Livingstone
Philip Meyers
MILLER COAL
MINE No 1
TO JOHNSTOWN
PLANE
TIPPLE
-LEGEND-
"A" Letter is for survey of June
"B" " " " " Jan.
"C" " " " " Oct.
"D" " " " " June
"E" " " " " Jan.
"F" " " " " Aug.
"G" " " " " Feb.
"H" " " " " Aug.
"I" " " " " Feb.-15
"J" " " " " Sept.-
"K" " " " " April -1
"L" " " " " Des. -15
MAP SHOWING
PROPERTY AND MINING OPERATIONS OF
CARBO SMOKELESS COAL CO
MINE No 3
SITUATE IN
CONEMAUGH TWP SOMERSET CO
AUG 29 08 SCALE 1" 100'
FETTERMAN ENG CO