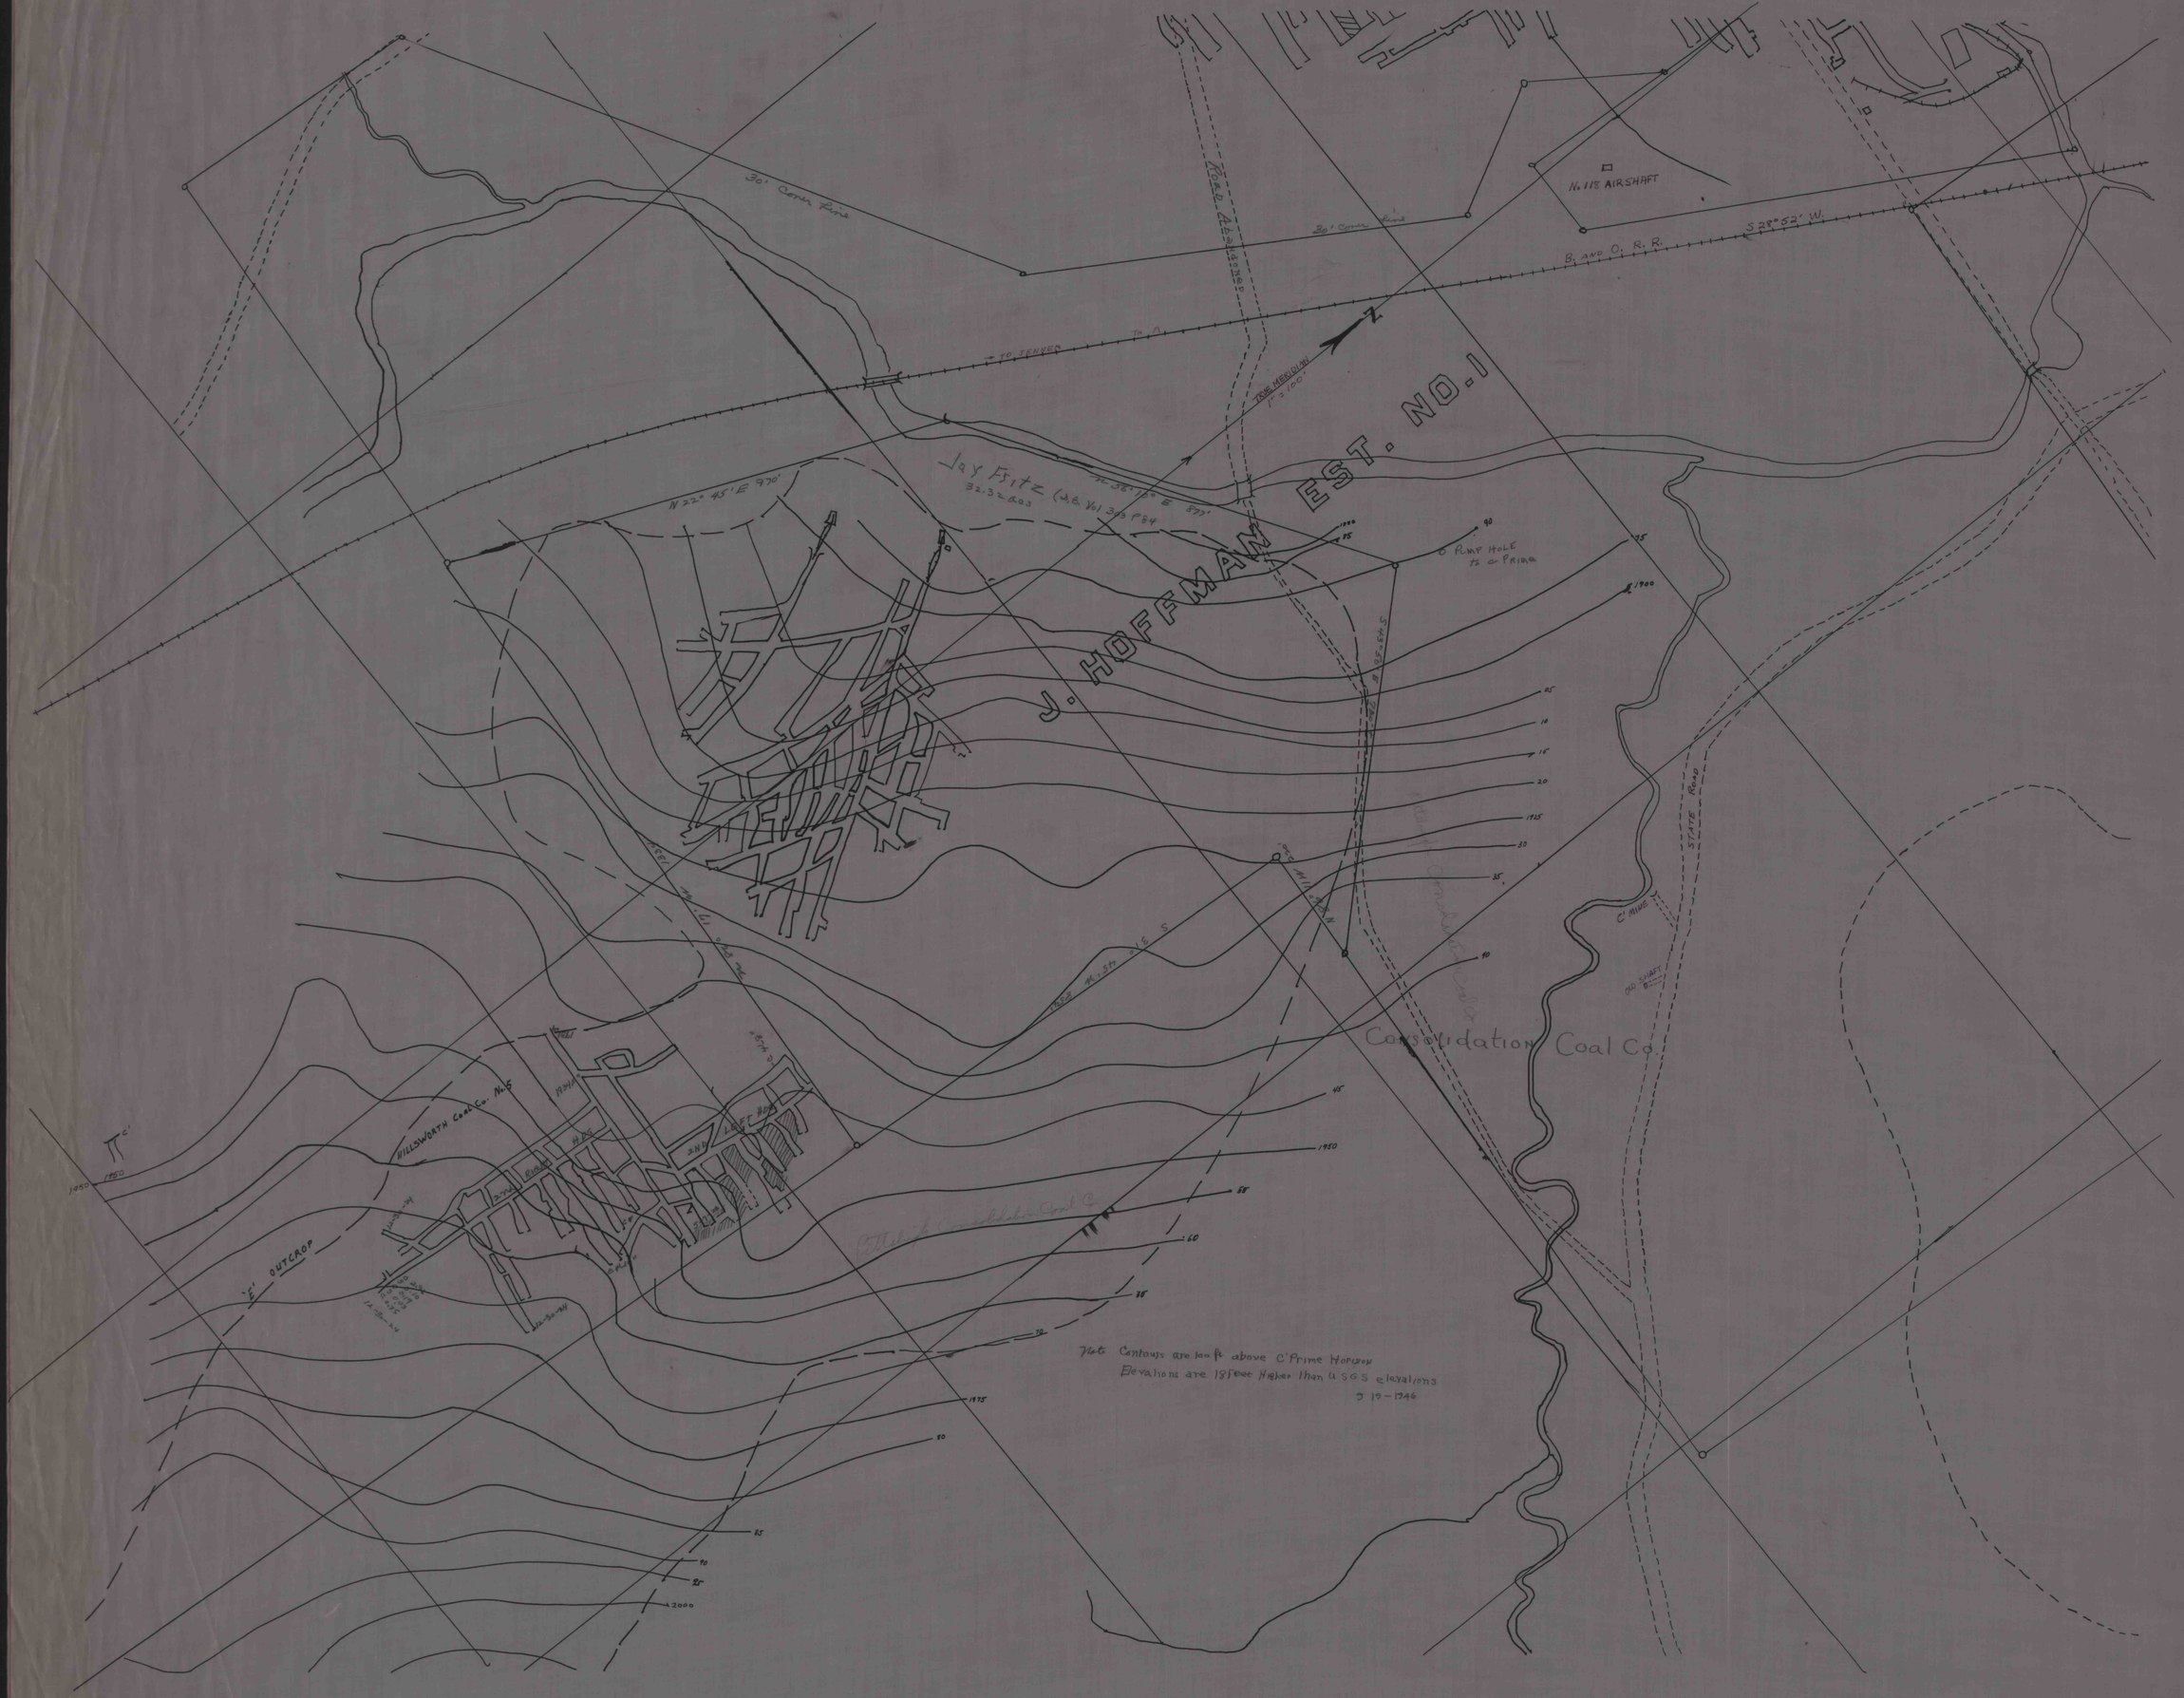
J. HOFFMAN EST. NO. 1
Jay Fritz (D.B. Vol 3 P.64 32.32 acs
N 22° 45' E 970'
N 38° 10' E 673'
30' Open Line
30' Open Line
Road Allegheny
B. and O. R. R.
S 28° 52' W.
N. 118 AIR SHAFT
TO JENKER
TO N.
TRUE MERIDIAN
1" = 100'
O Ramp Hole to C Prime
S 85° 50' E
Consolidation Coal Co.
STATE ROAD
C MINE
OLD SHAFT
HILLSWORTH Coal Co. No. 5
"E" OUTCROP
"C"
1950
1925
1900
1975
2000
Note Contours are 100 ft above C Prime Horizon
Elevations are 185 feet Higher than U.S.G.S elevations
7-19-1946