


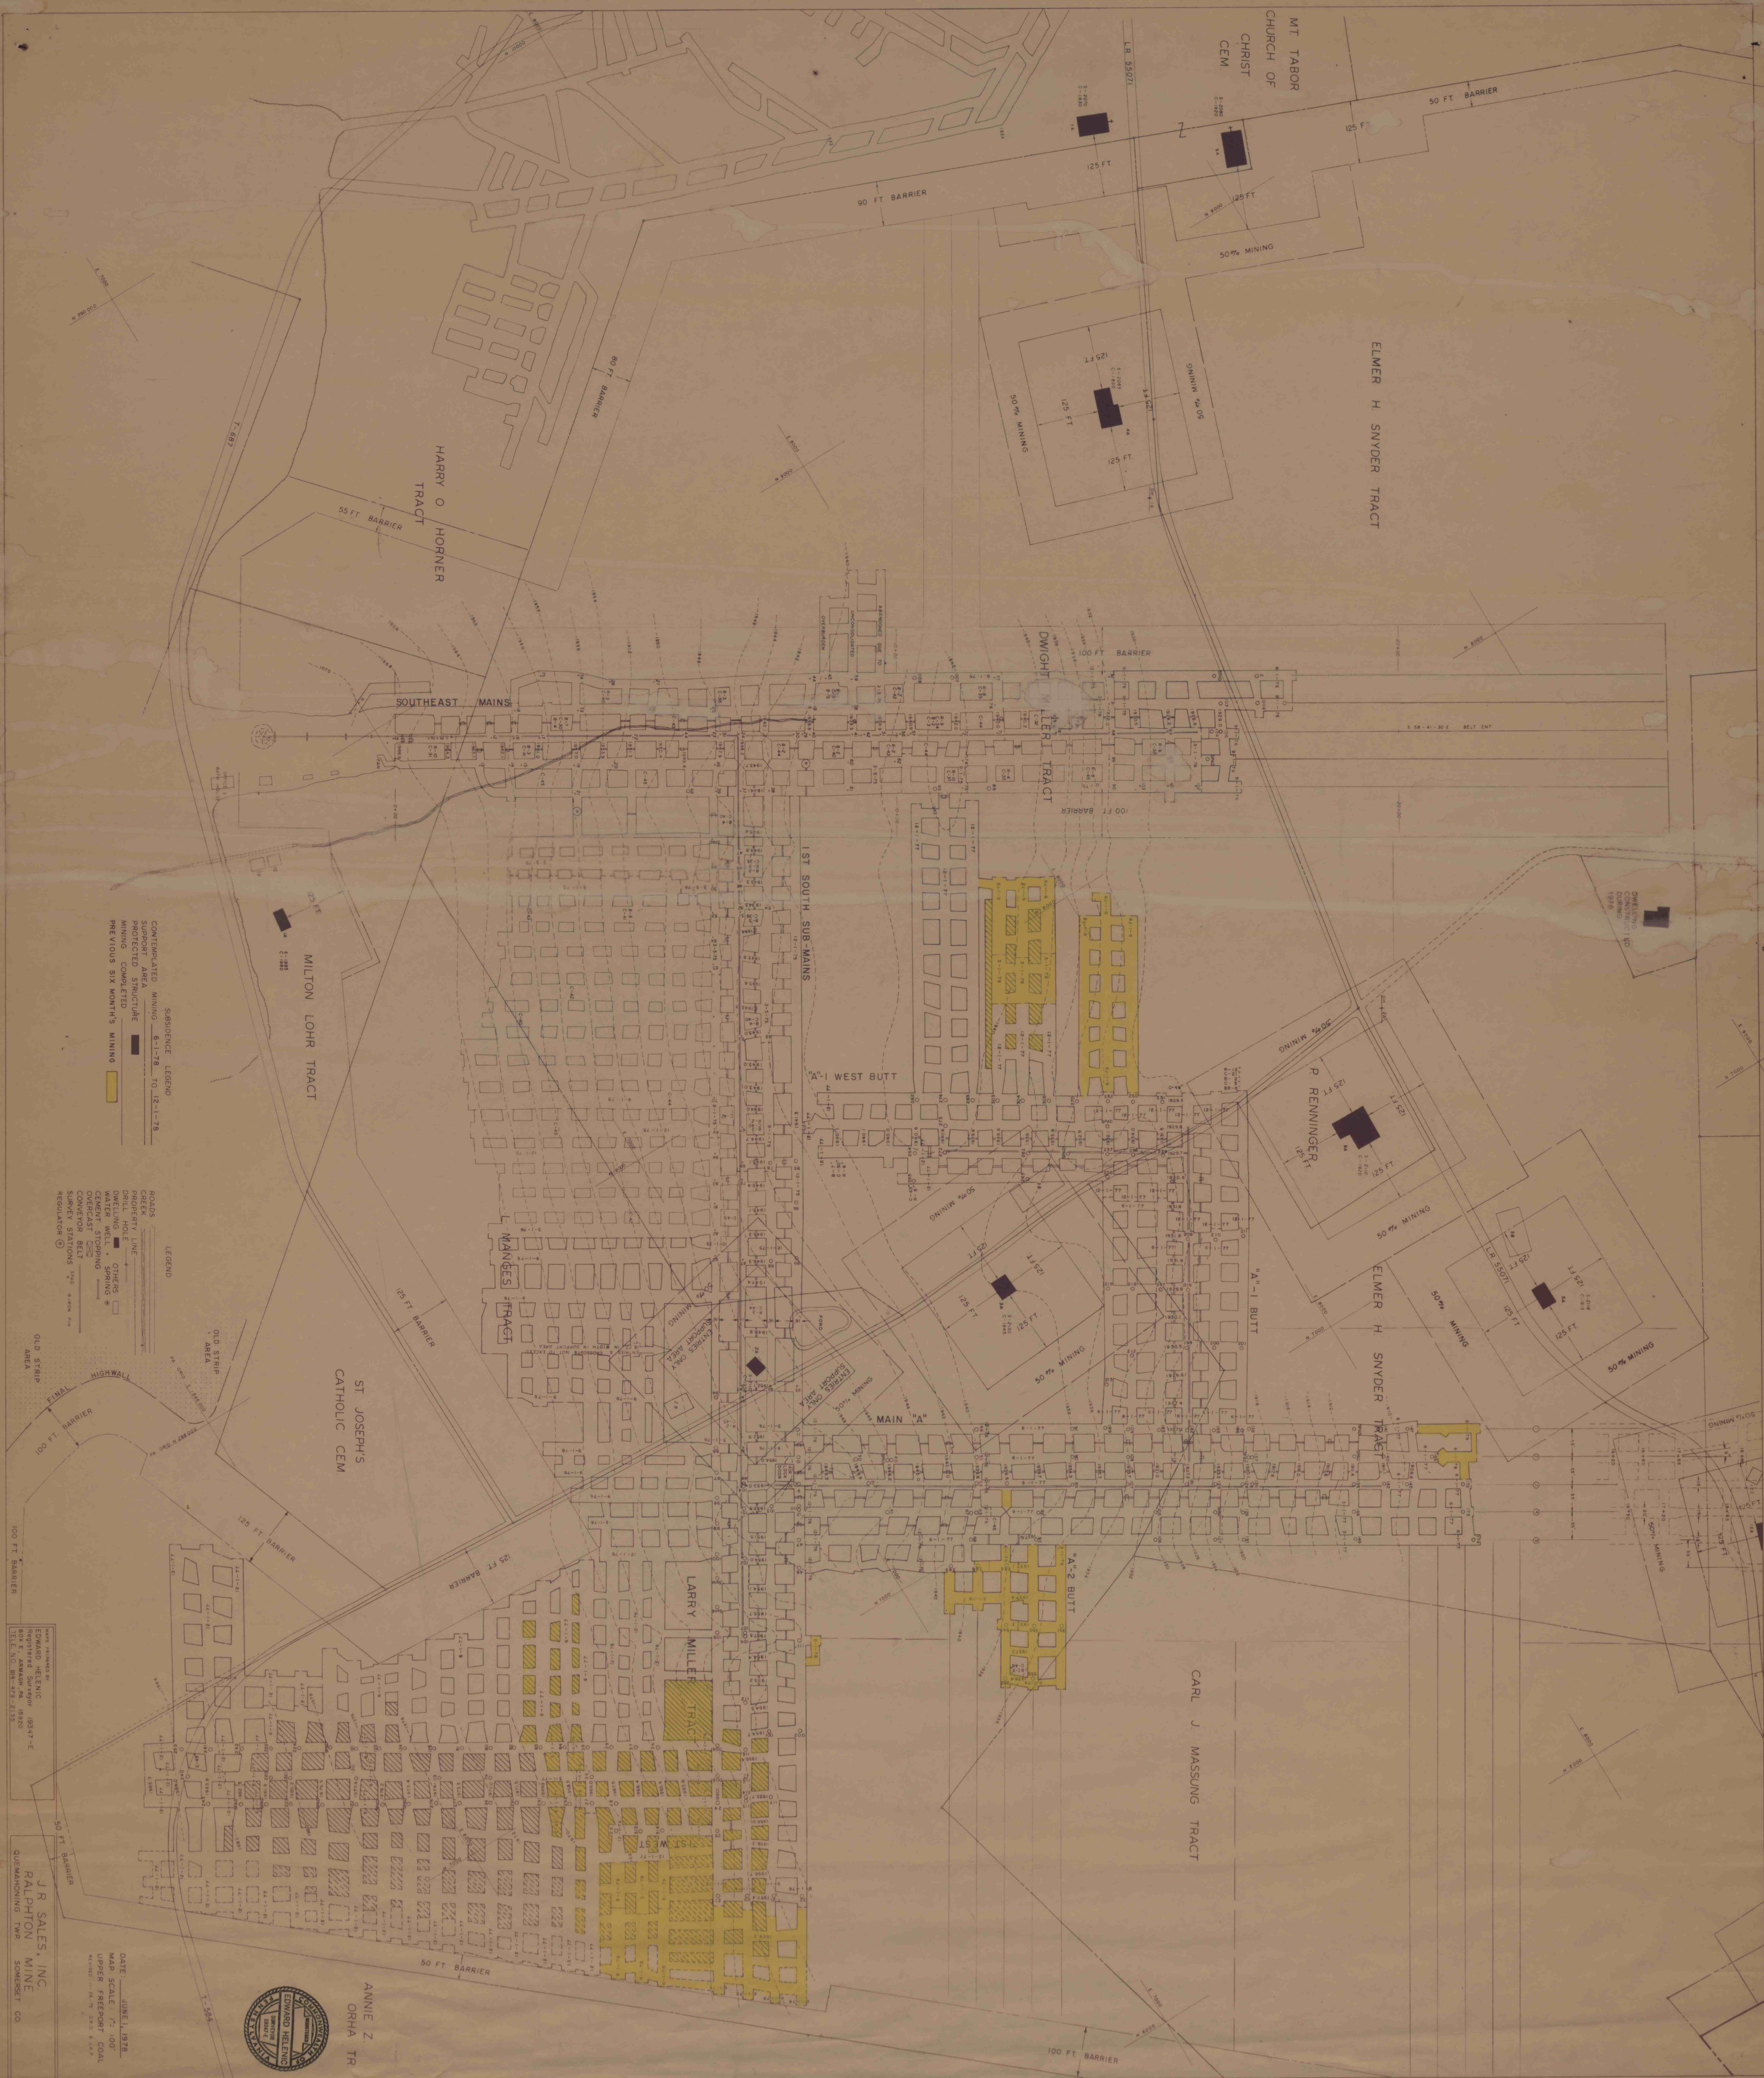


J.R. SALES, INC.

ANNE Z
ORHA TR

DATE: JUNE 1, 1978
MAP SCALE: 1" = 100'
UPPER FREEPORT COAL