


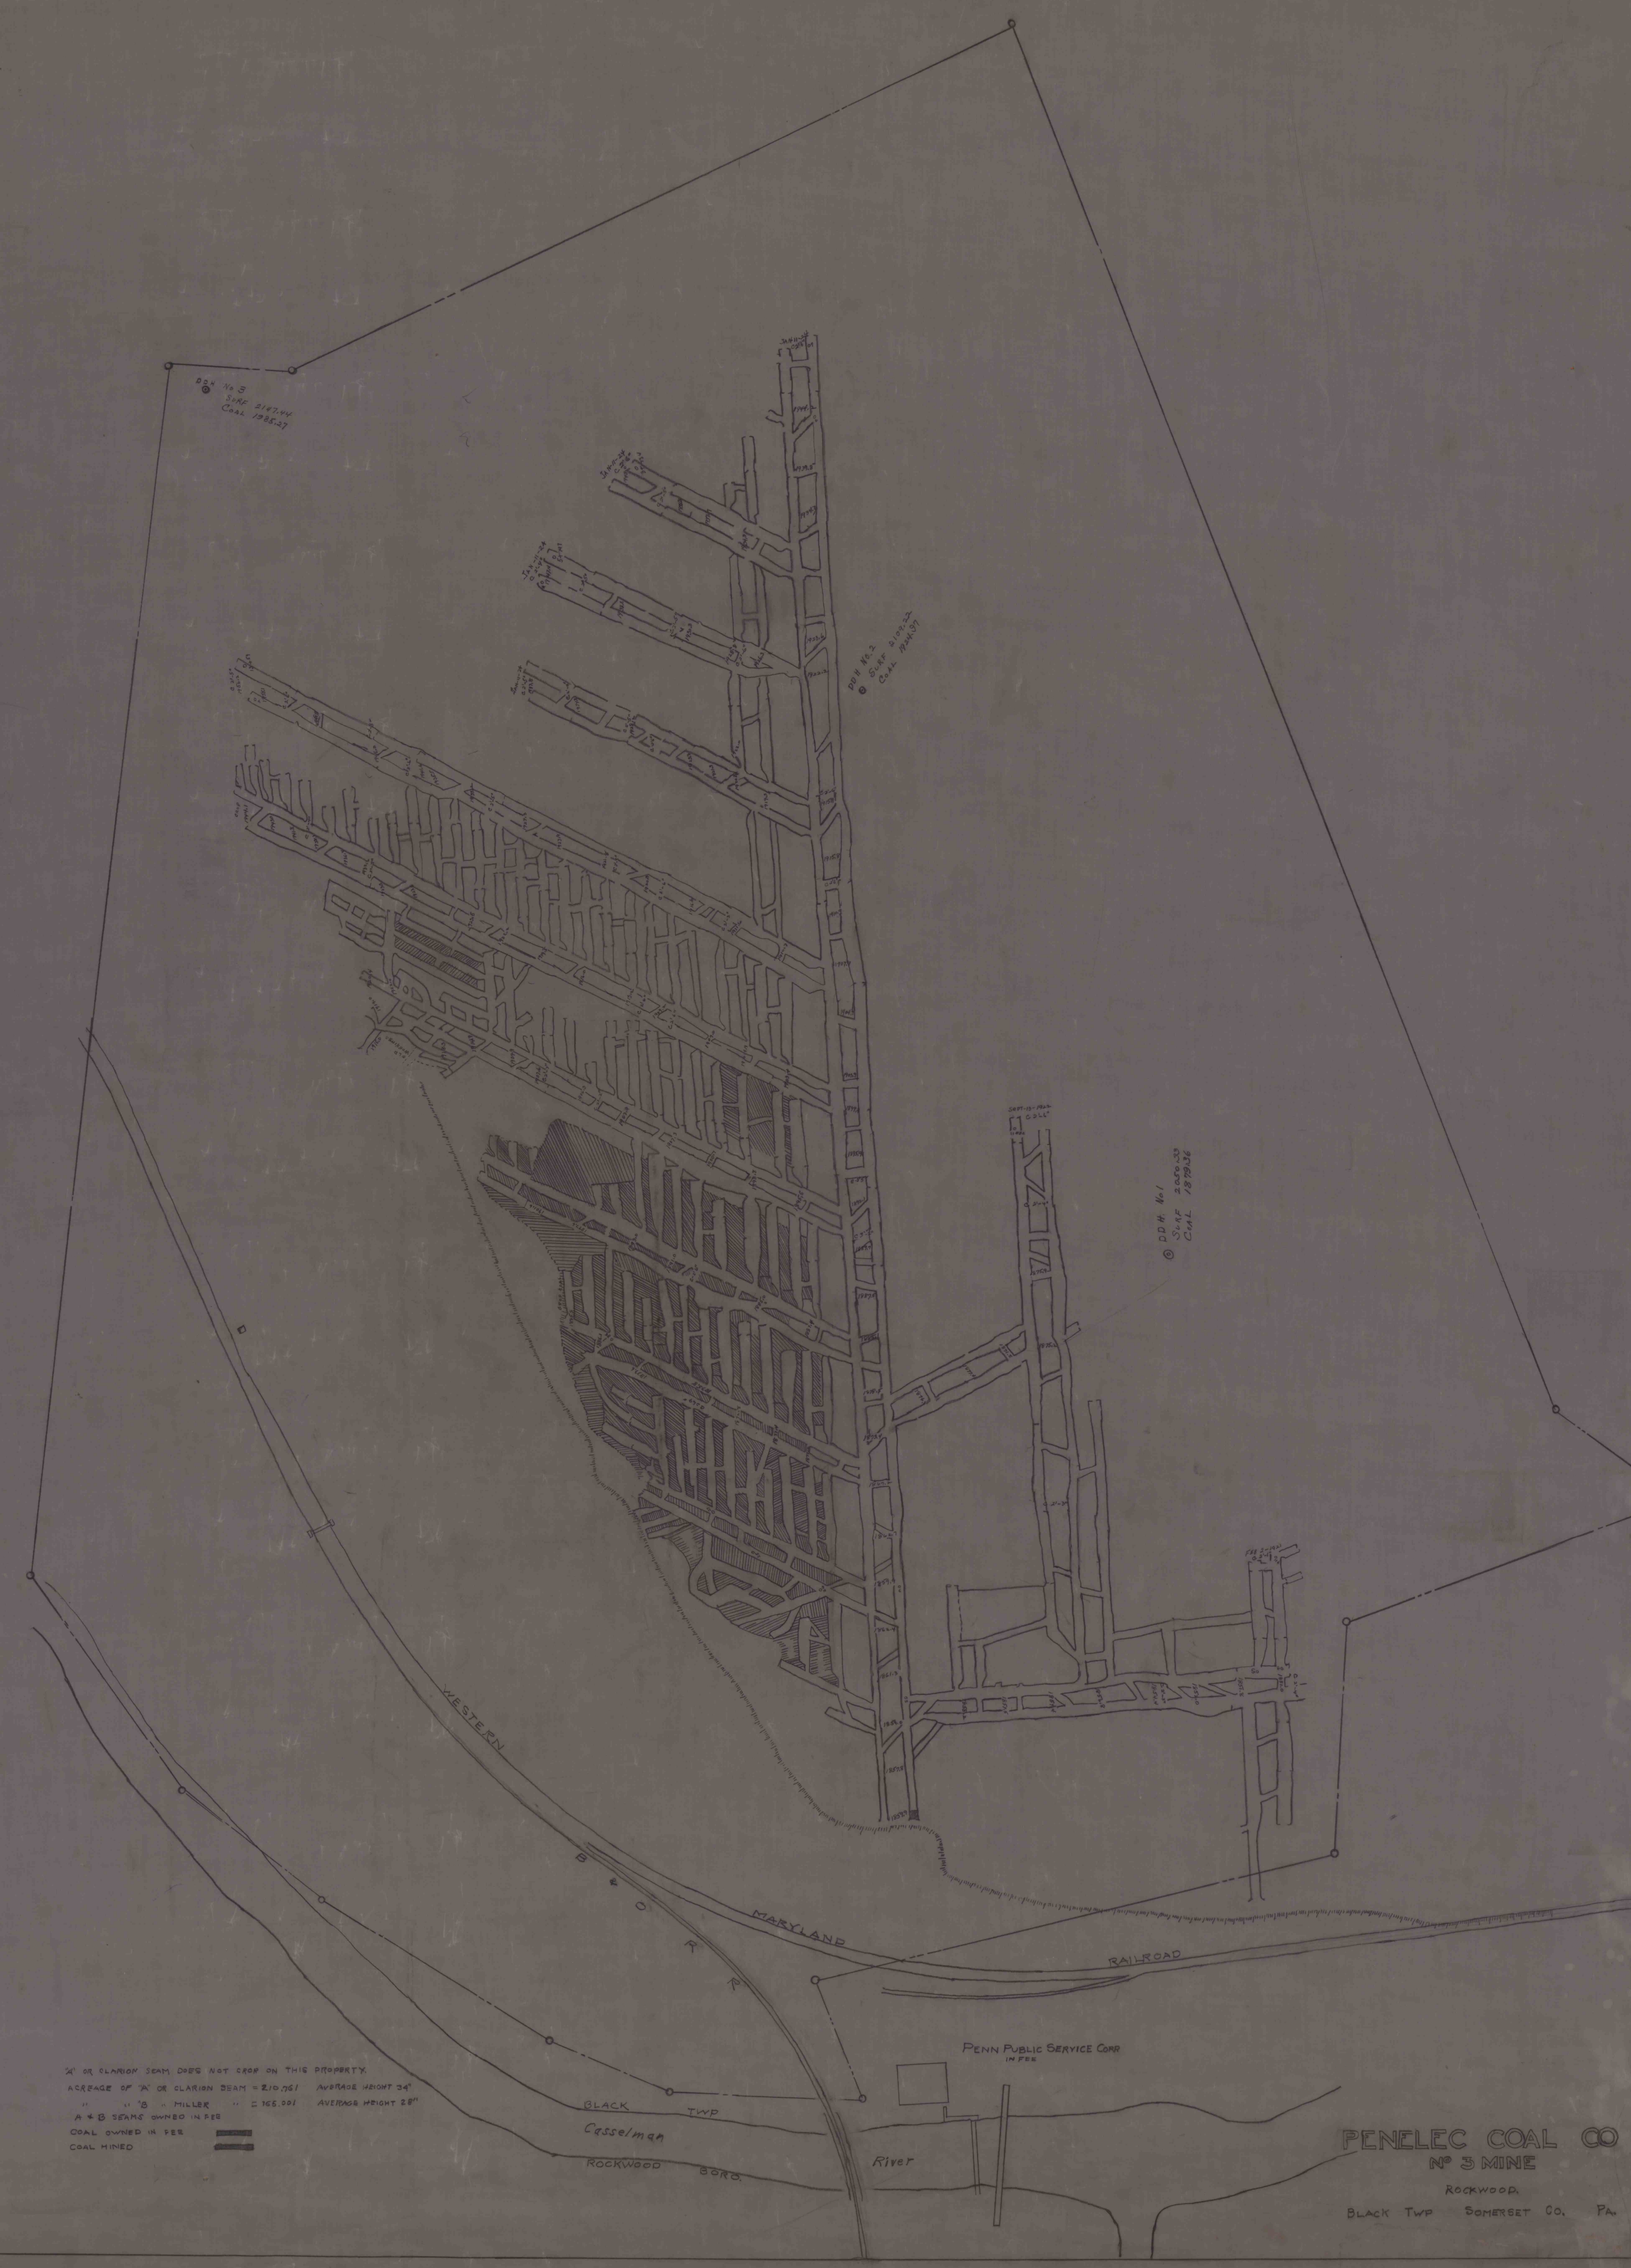

A' OR CLARION SEAM DOES NOT CROP ON THIS PROPERTY.
 AVERAGE OF 'A' OR CLARION SEAM = 210.761 AVERAGE HEIGHT 34"
 " " 'B' " MILLER " = 165.501 AVERAGE HEIGHT 28"
 A + B SEAMS OWNED IN FEE
 COAL OWNED IN FEE
 COAL MINED

PENELEC COAL CO
N° 3 MINE
 ROCKWOOD,
 BLACK TWP SOMERSET CO. PA.