

WILMORE
TR 1044
1380 AC

36.00 AC

TRACT NO. 1043
THOMAS' LANDS
THE WILMORE COAL CO. MINERAL 25.5 AC


48.00

30.60

61 AC


RUSSEL
TYLE
COAL

SEE
400' PRINT
FOR B.B. THE
PURCHASE

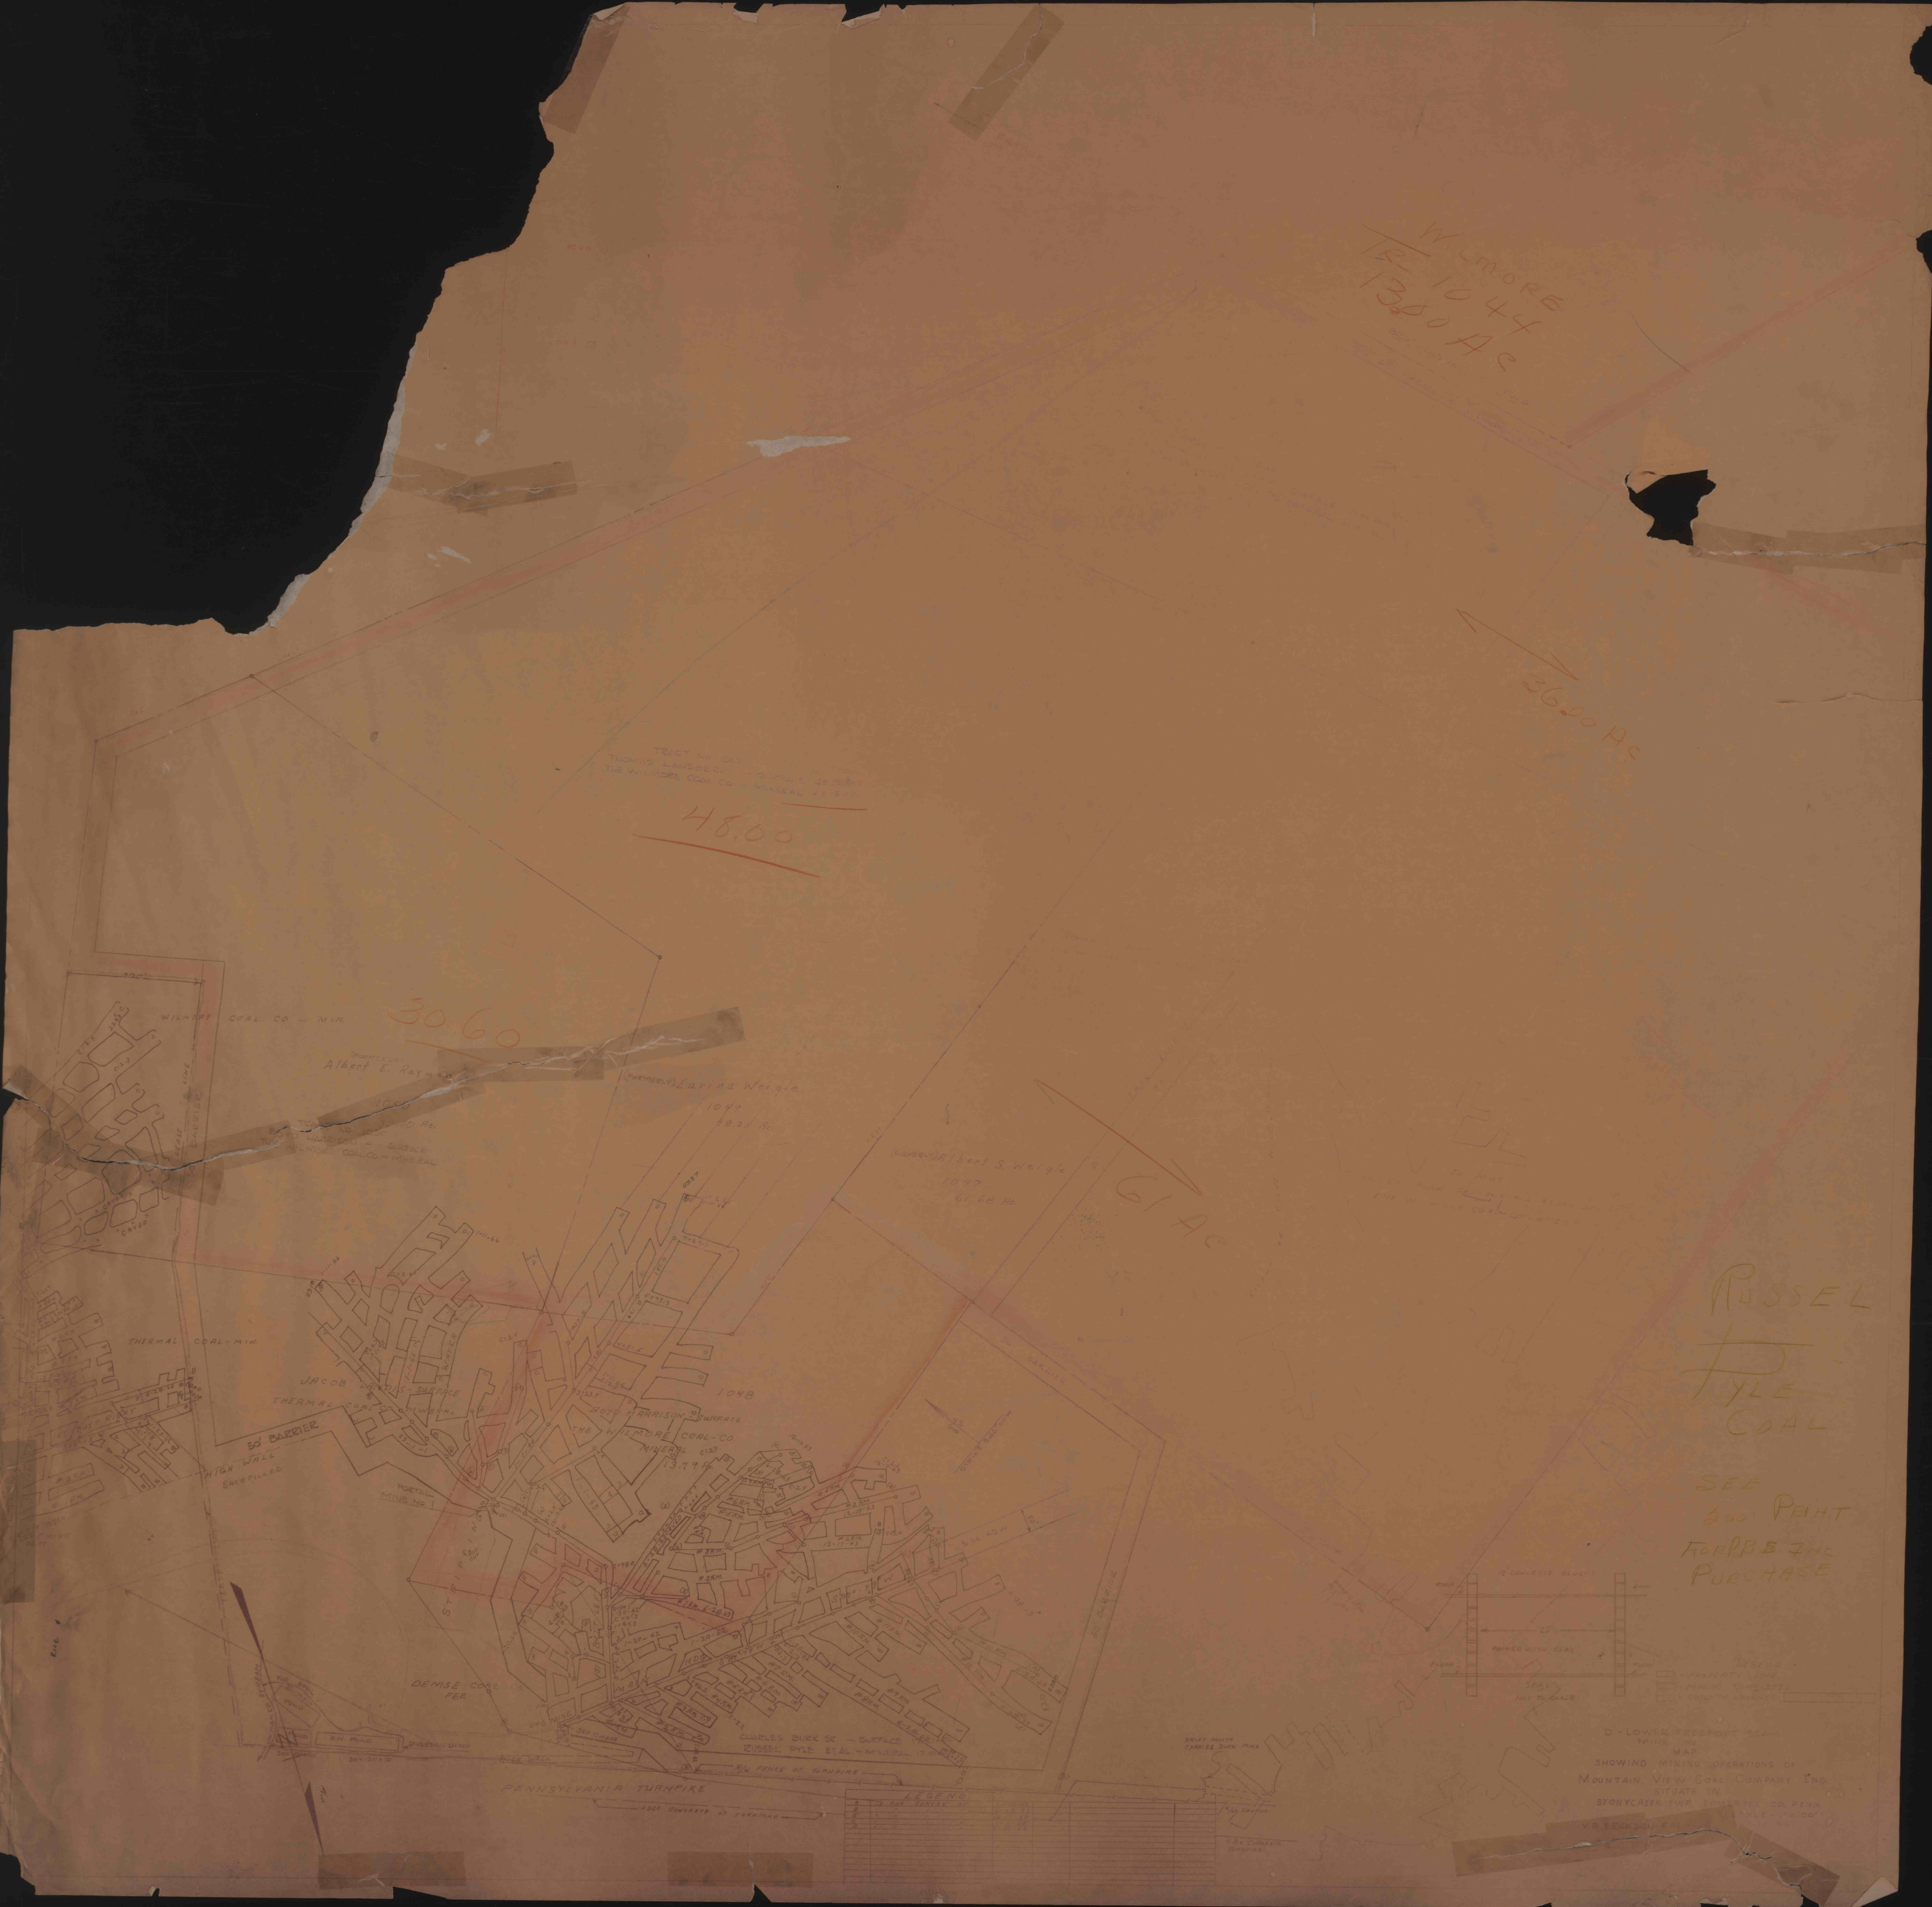

LEGEND


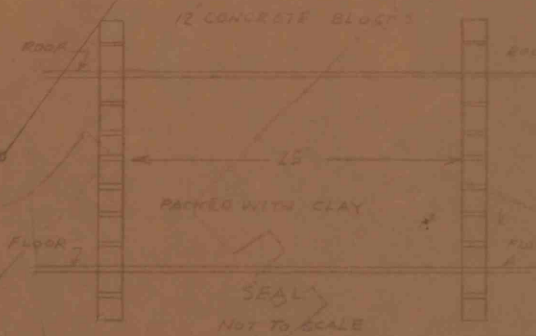

D - LOWER FREEPORT SEAM
MAP
SHOWING MINING OPERATIONS OF
MOUNTAIN VIEW COAL COMPANY INC.
SITUATE IN
U.S. GEOLOGICAL SURVEY