


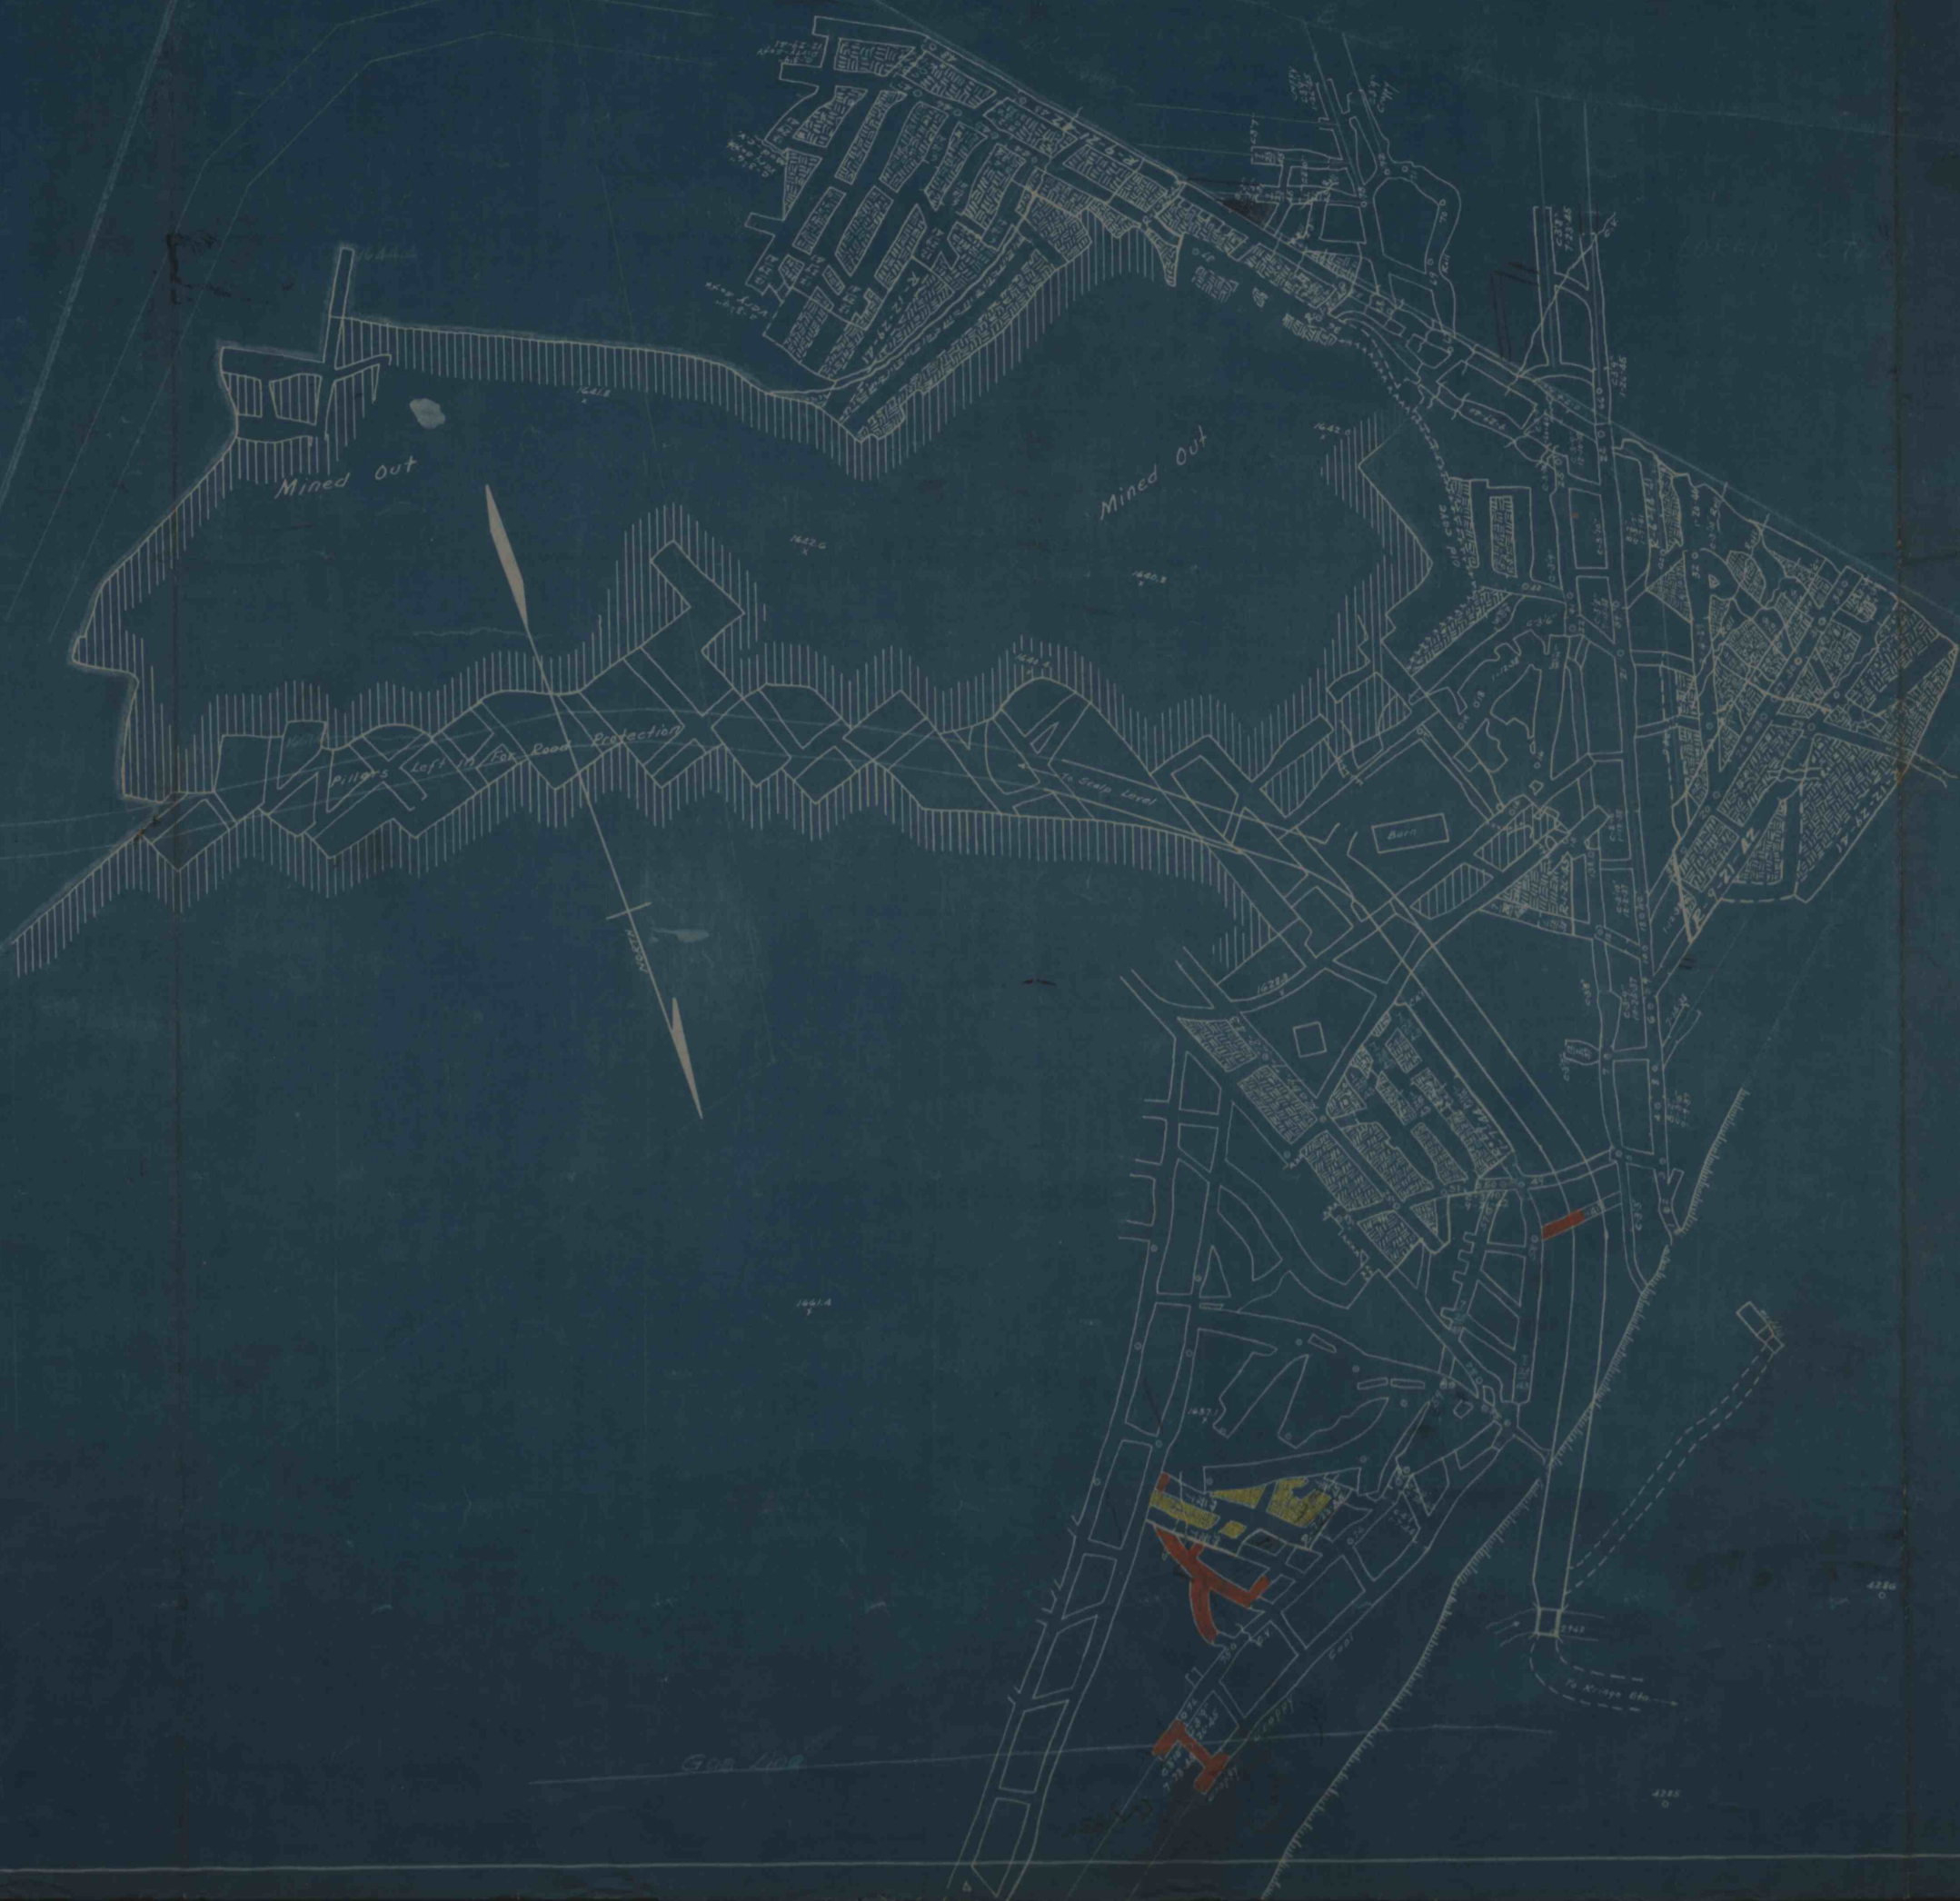

IRVIN SHAFFER MINE
ON THE
EMANUEL BLOUGH TRACT 454
SITUATE IN
RICHLAND TWP. CAMBRIA CO.
SCALE - 1" = 100' JUNE 22 1937
SURVEYED BY J. H. BROWN
MINING ENGINEER
ADVANCE - 0.17 A.C.
ROBBING - 0.00 A.C.