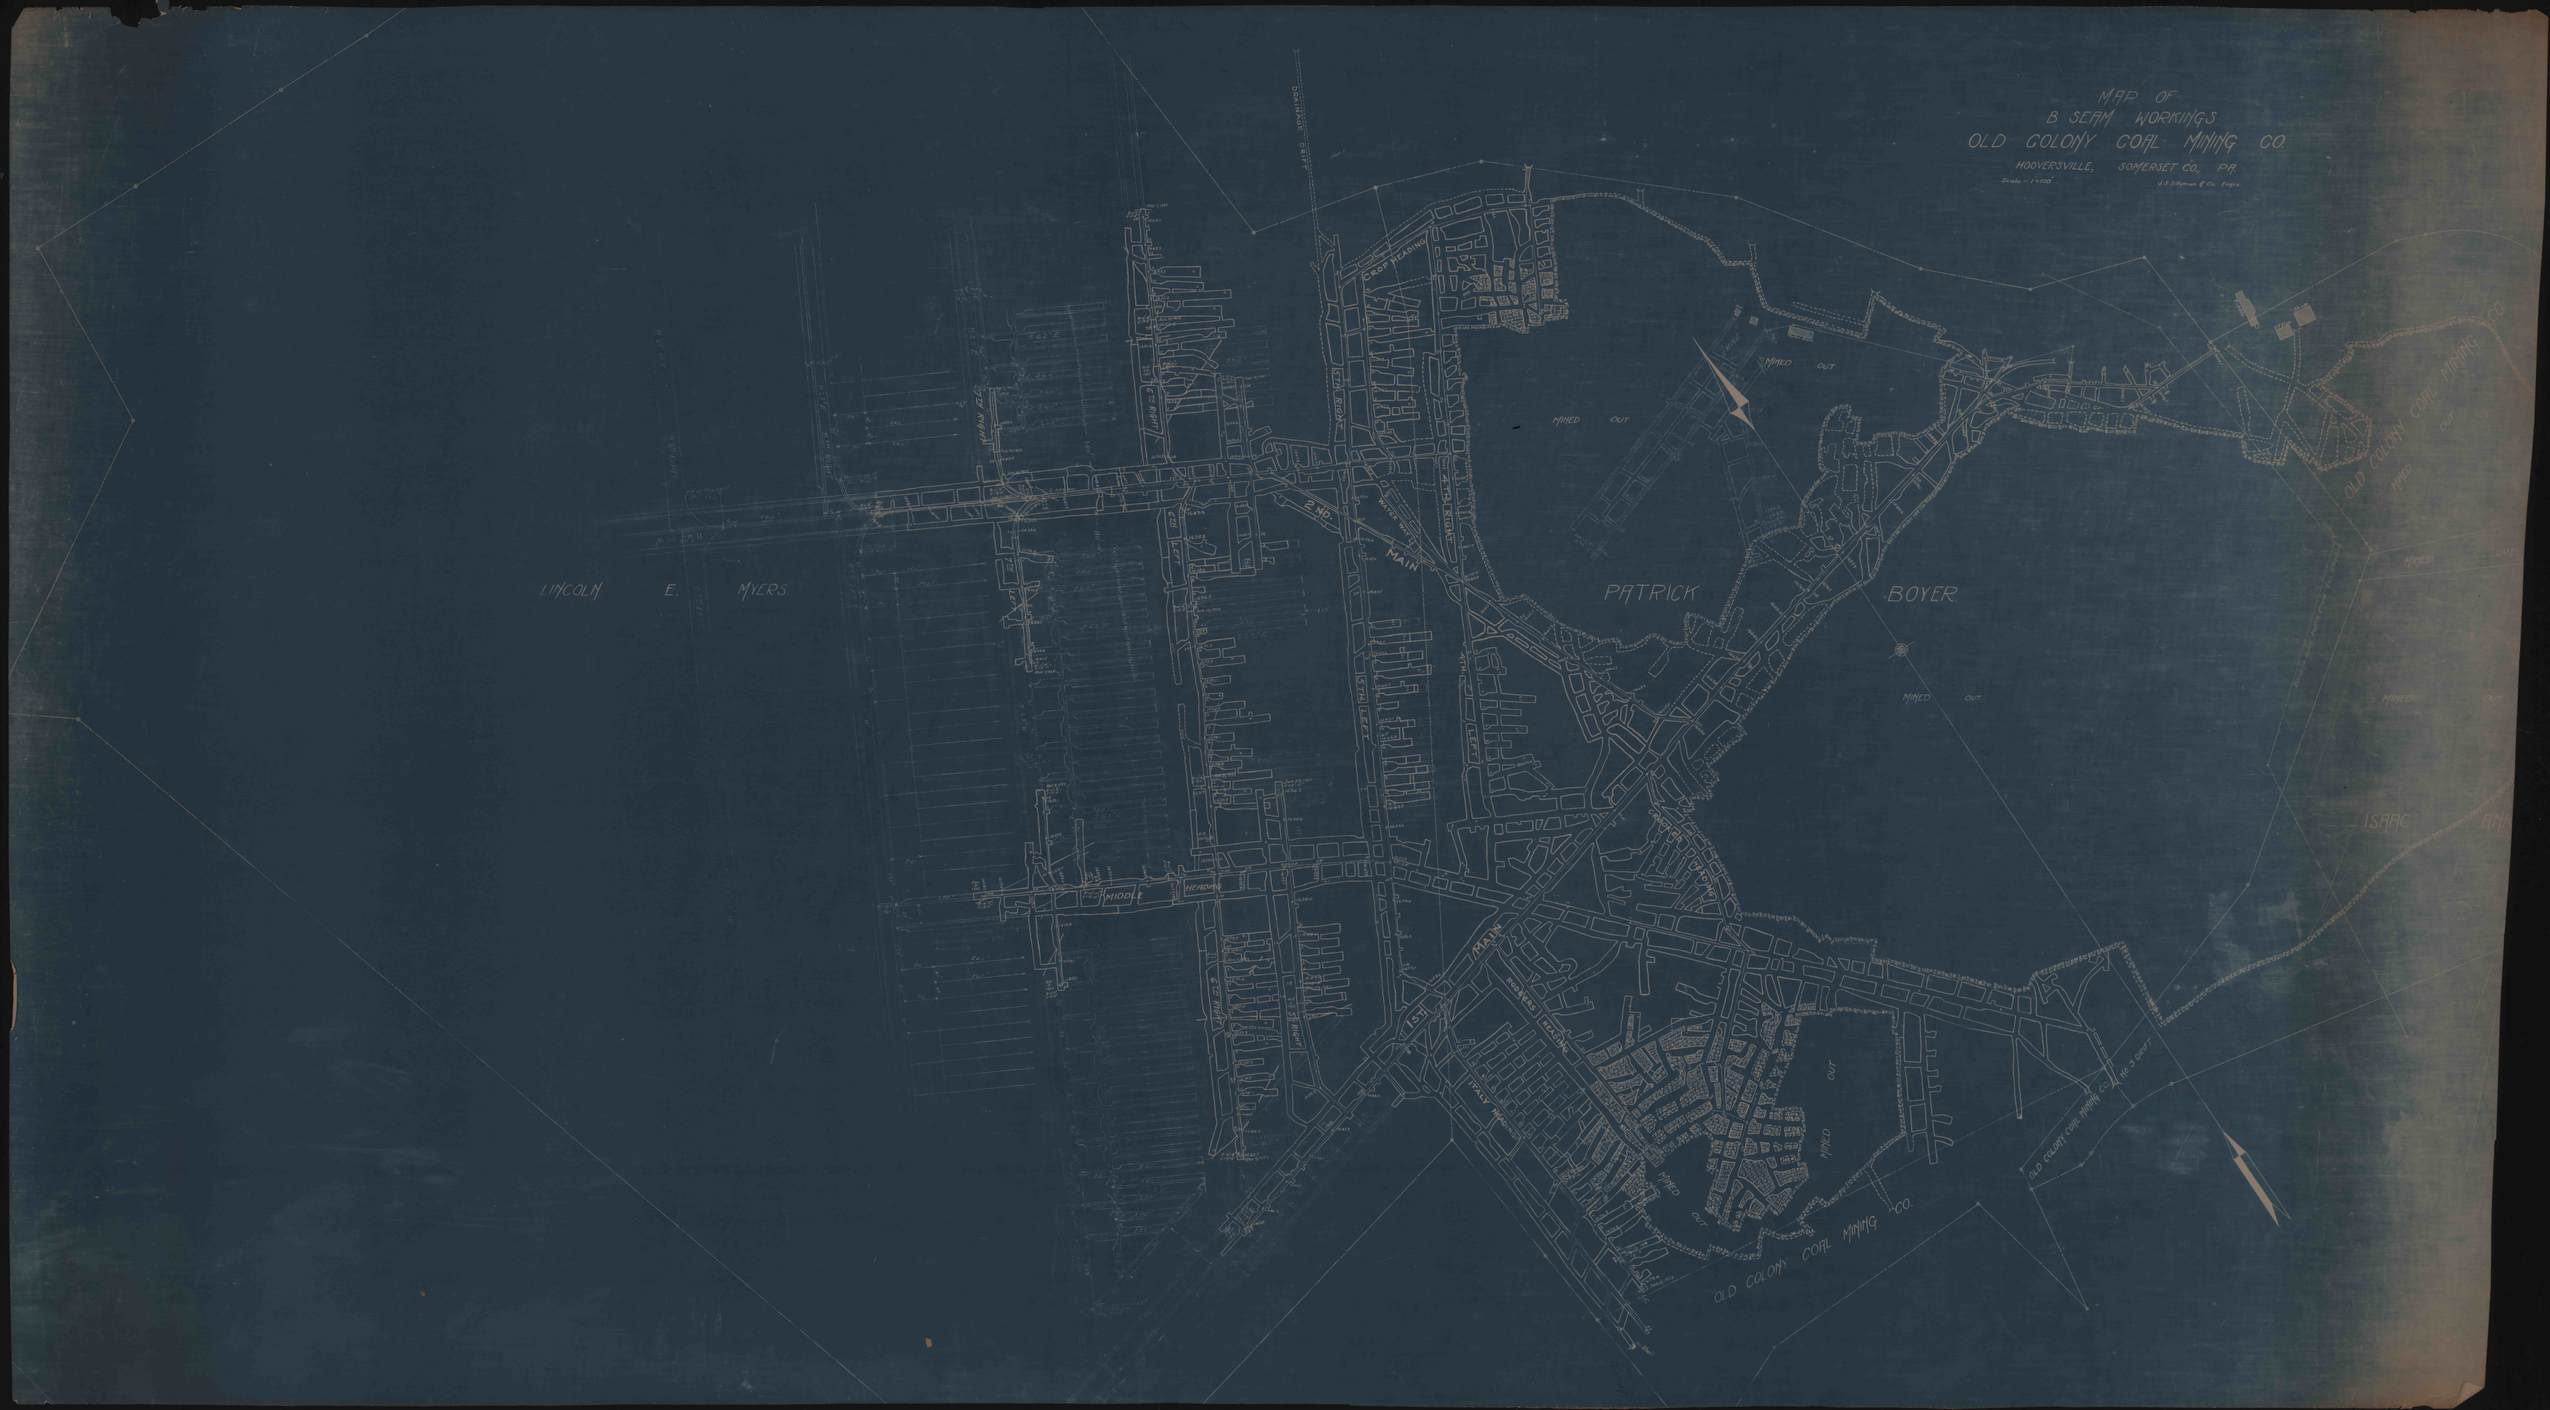
MAP OF
B SEAM WORKINGS
OLD COLONY COAL MINING CO
HOOVERSVILLE, SOMERSET CO. PA.
Scale - 1"=100'
J.S. Pillsman & Co. Engrs.
DRAINAGE DITCH
CROP HEADING
MINED OUT
MINED OUT
MINED OUT
2ND
MAIN
4TH RIGHT
4TH LEFT
5TH LEFT
5TH RIGHT
2ND RIGHT
2ND RIGHT
LINCOLN E. MYERS
PATRICK BOYER
MIDDLE HEADING
MAIN
ROADWAY HEADING
ITALY HEADING
1ST
MINED OUT
MINED OUT
OLD COLONY COAL MINING CO.
OLD COLONY COAL MINING CO.
OLD COLONY COAL MINING CO.
ISAAC