


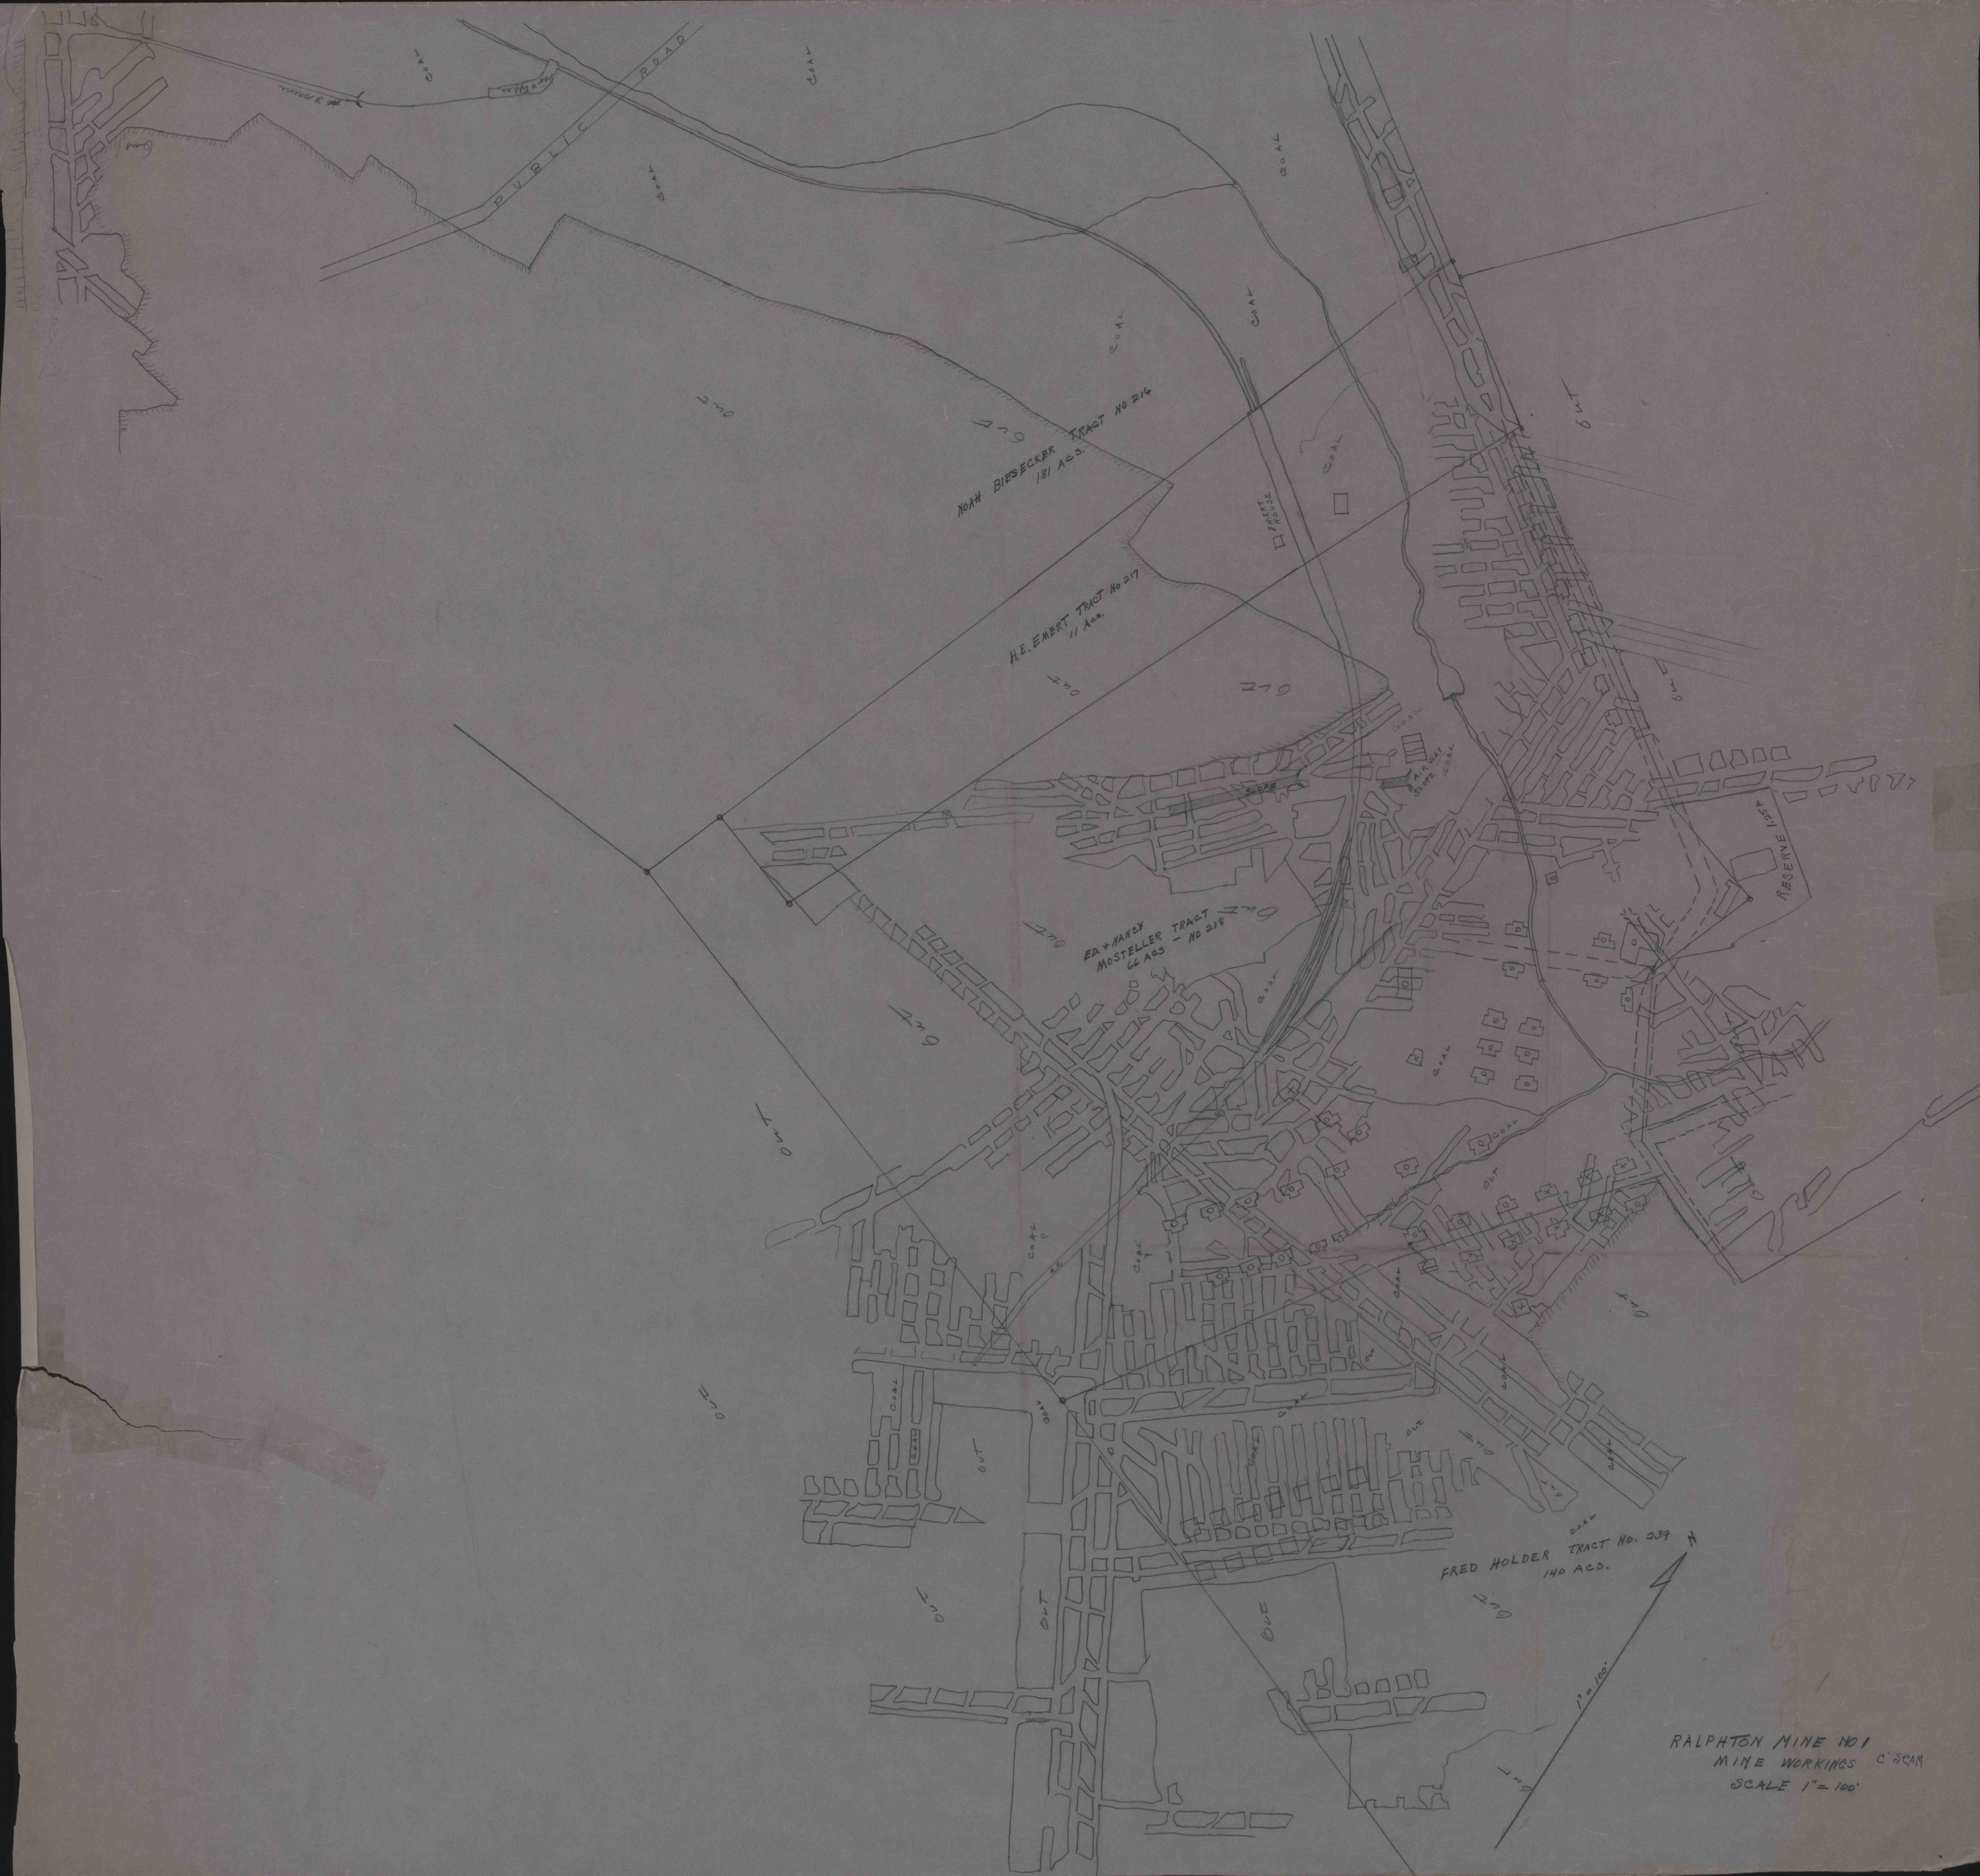

RALPHTON MINE NO 1  
MINE WORKINGS C. SCAM  
SCALE 1" = 100'