

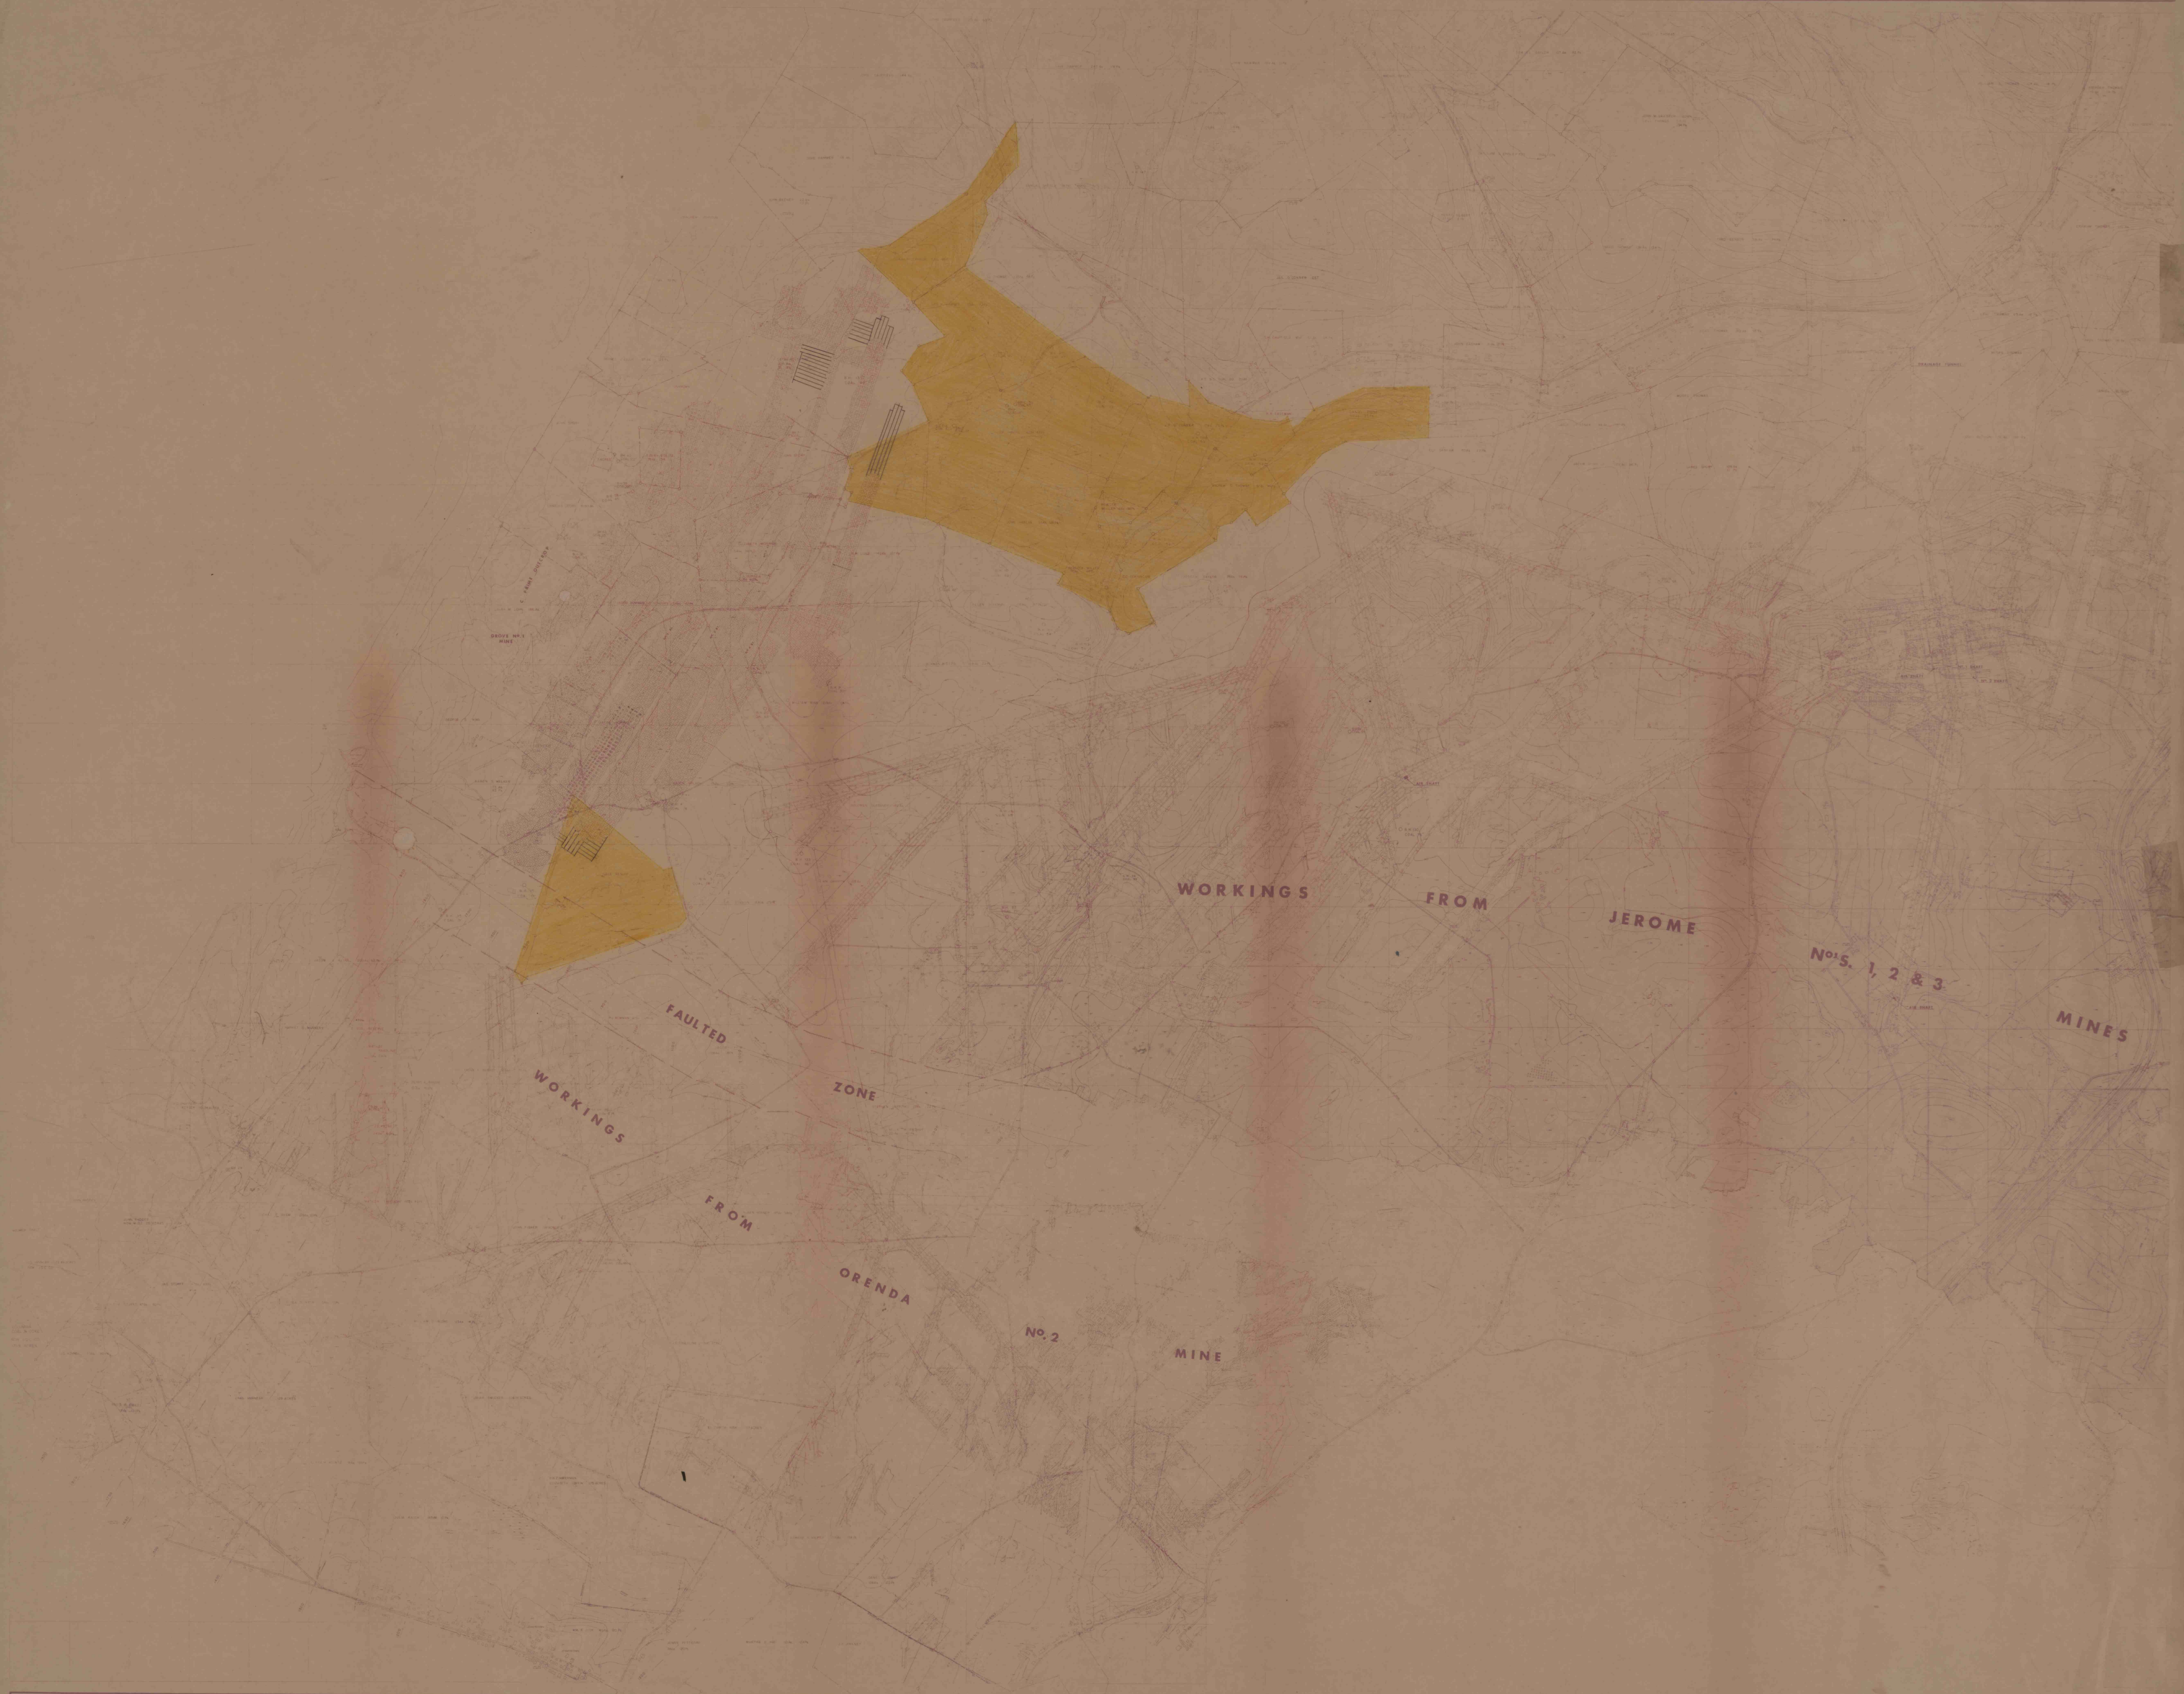


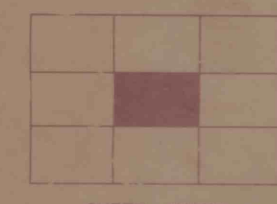

G. M. & W. COAL CO. INC.
"C PRIME SEAM" WORKINGS
GROVE NO. 1 MINE

CONEMAUGH & JENNER TOWNSHIPS
SOMERSET COUNTY
PENNSYLVANIA

LEGEND	
UNPAVED ROAD	RAILROAD
PAVED ROAD	LAKE, POND
U.S. ROUTE	FENCE
INTERSTATE	SWAMP
LEGISLATIVE ROUTE	WOODS LINE
TOWNSHIP ROUTE	
	WENCH MARK
	TRAVERSE STATION
	PHOTOGRAPHIC POINT
	CONTOUR
	PHOTO CENTER

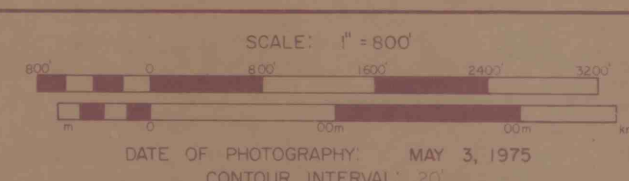

SHEET INDEX

1" = 800' SERIES
"C" SEAM
SHEET NO.