


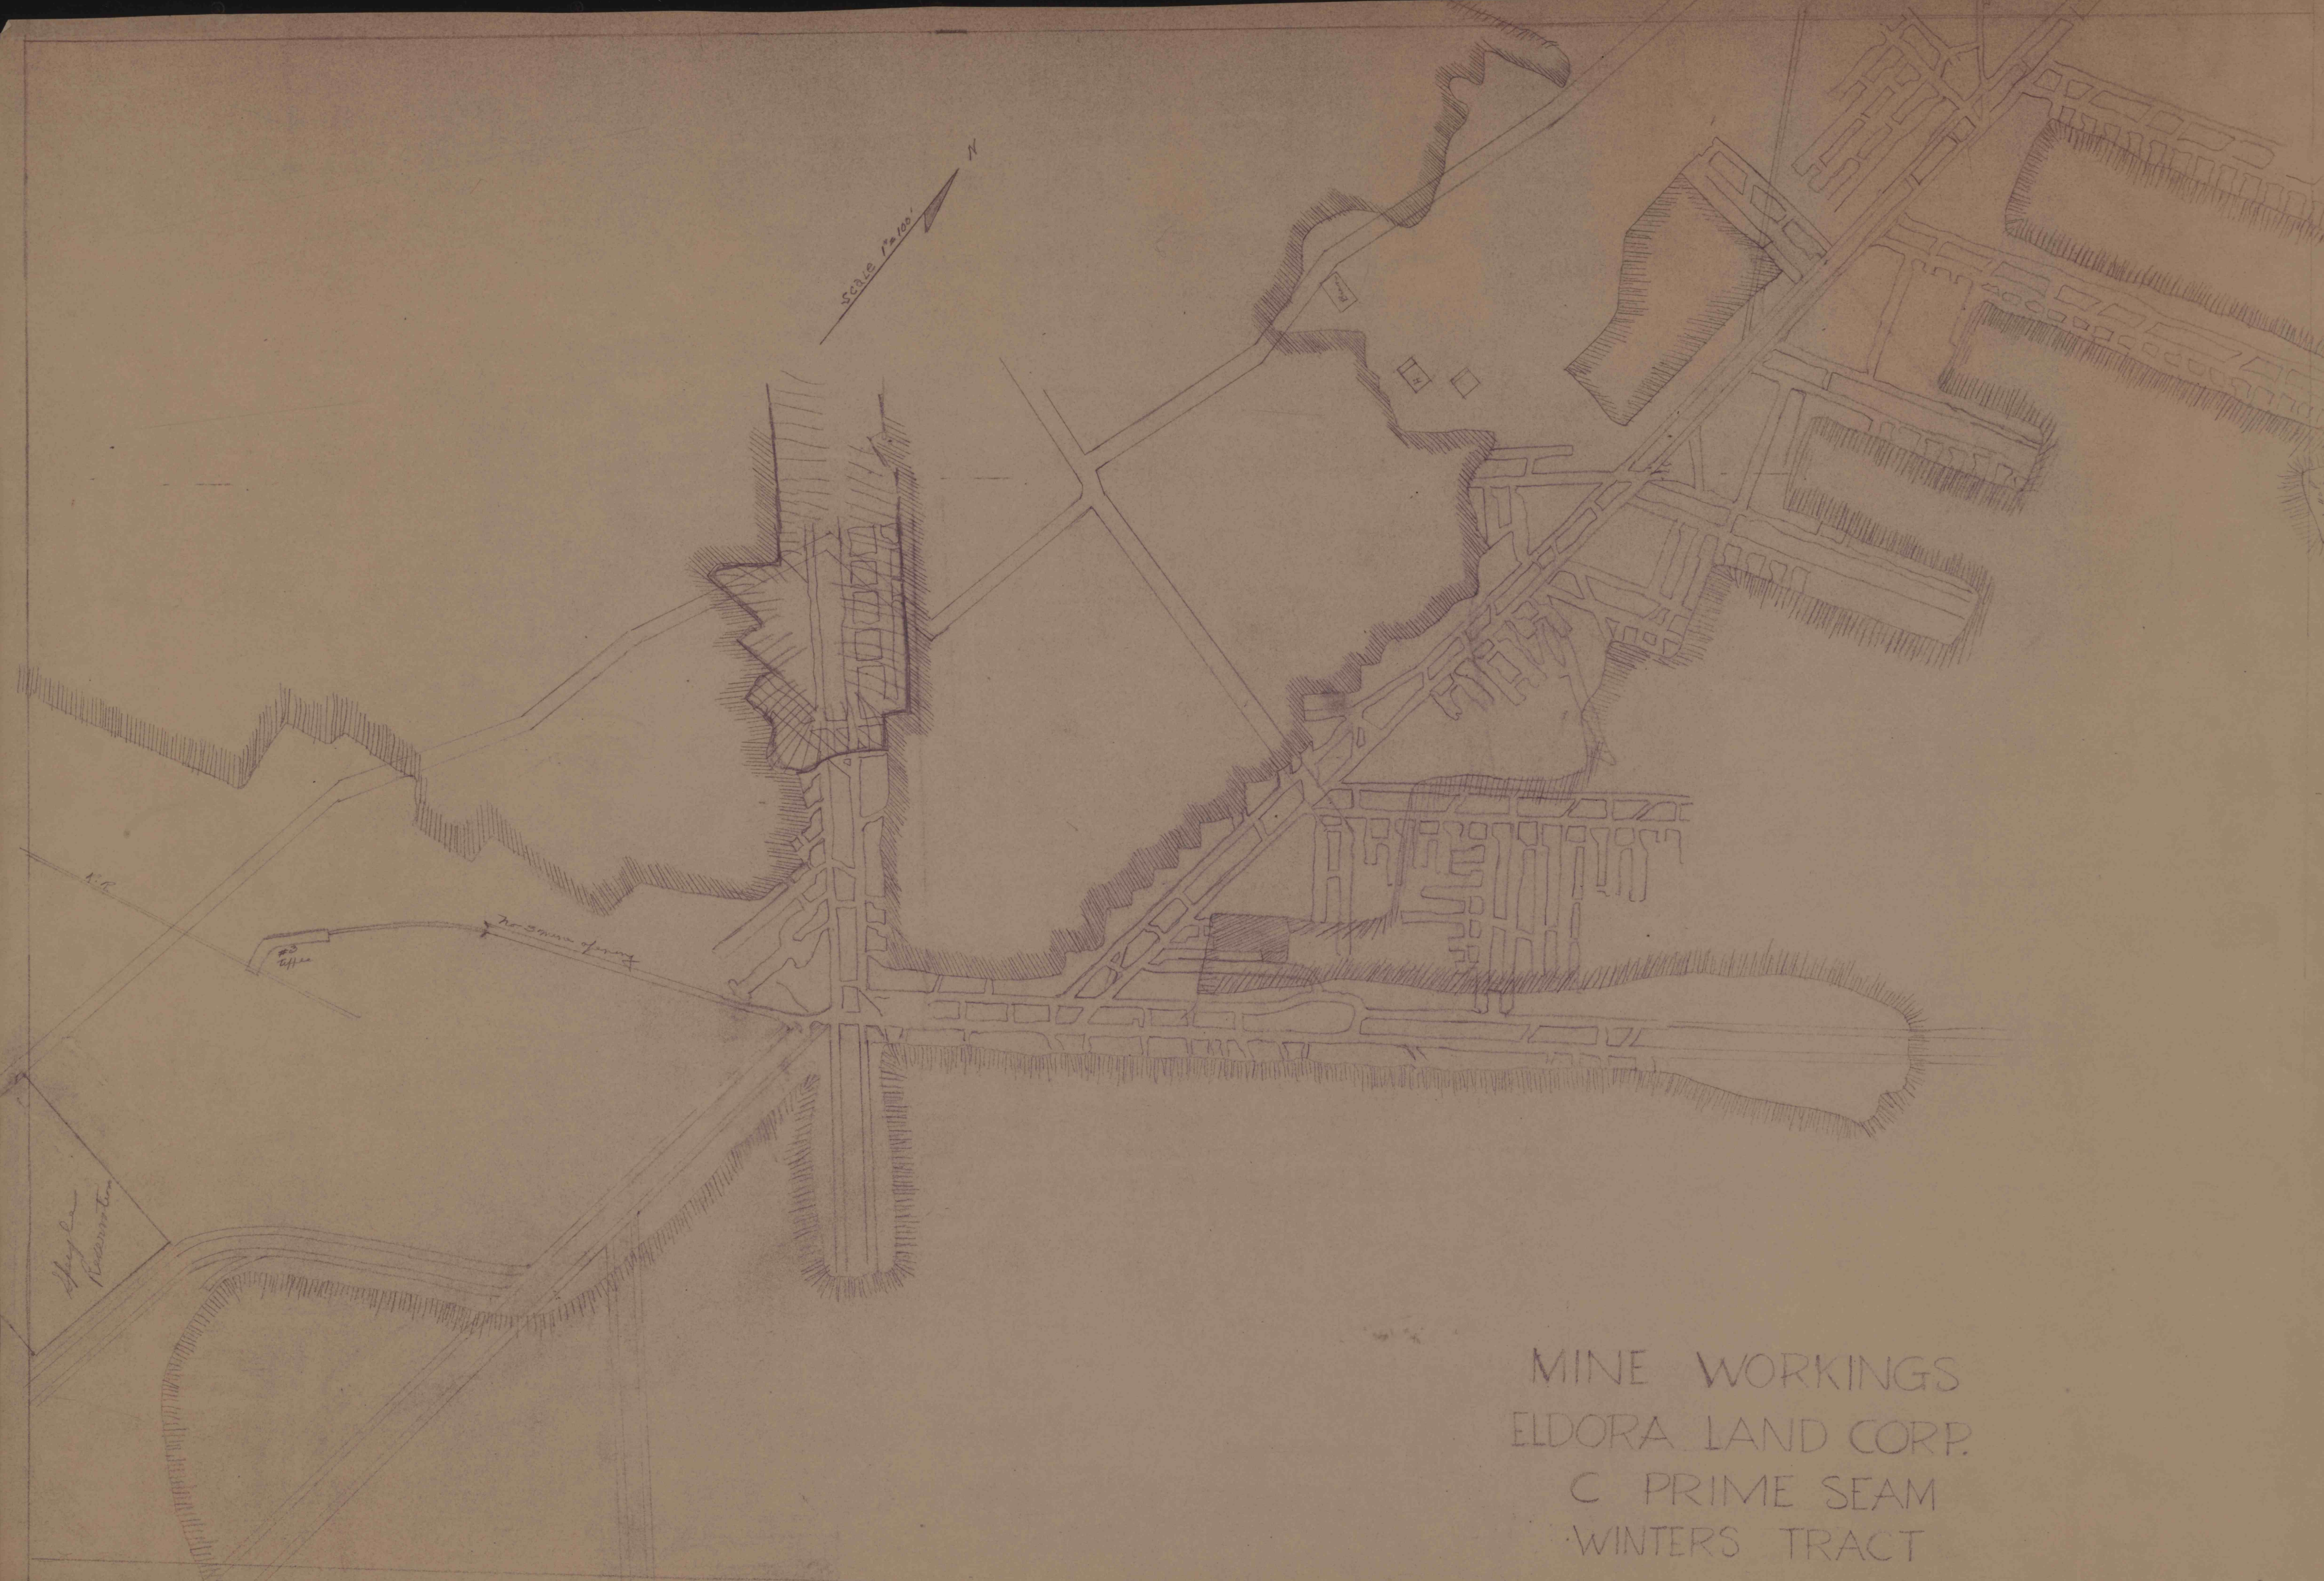

MINE WORKINGS
ELDORA LAND CORP.
C PRIME SEAM
WINTERS TRACT