


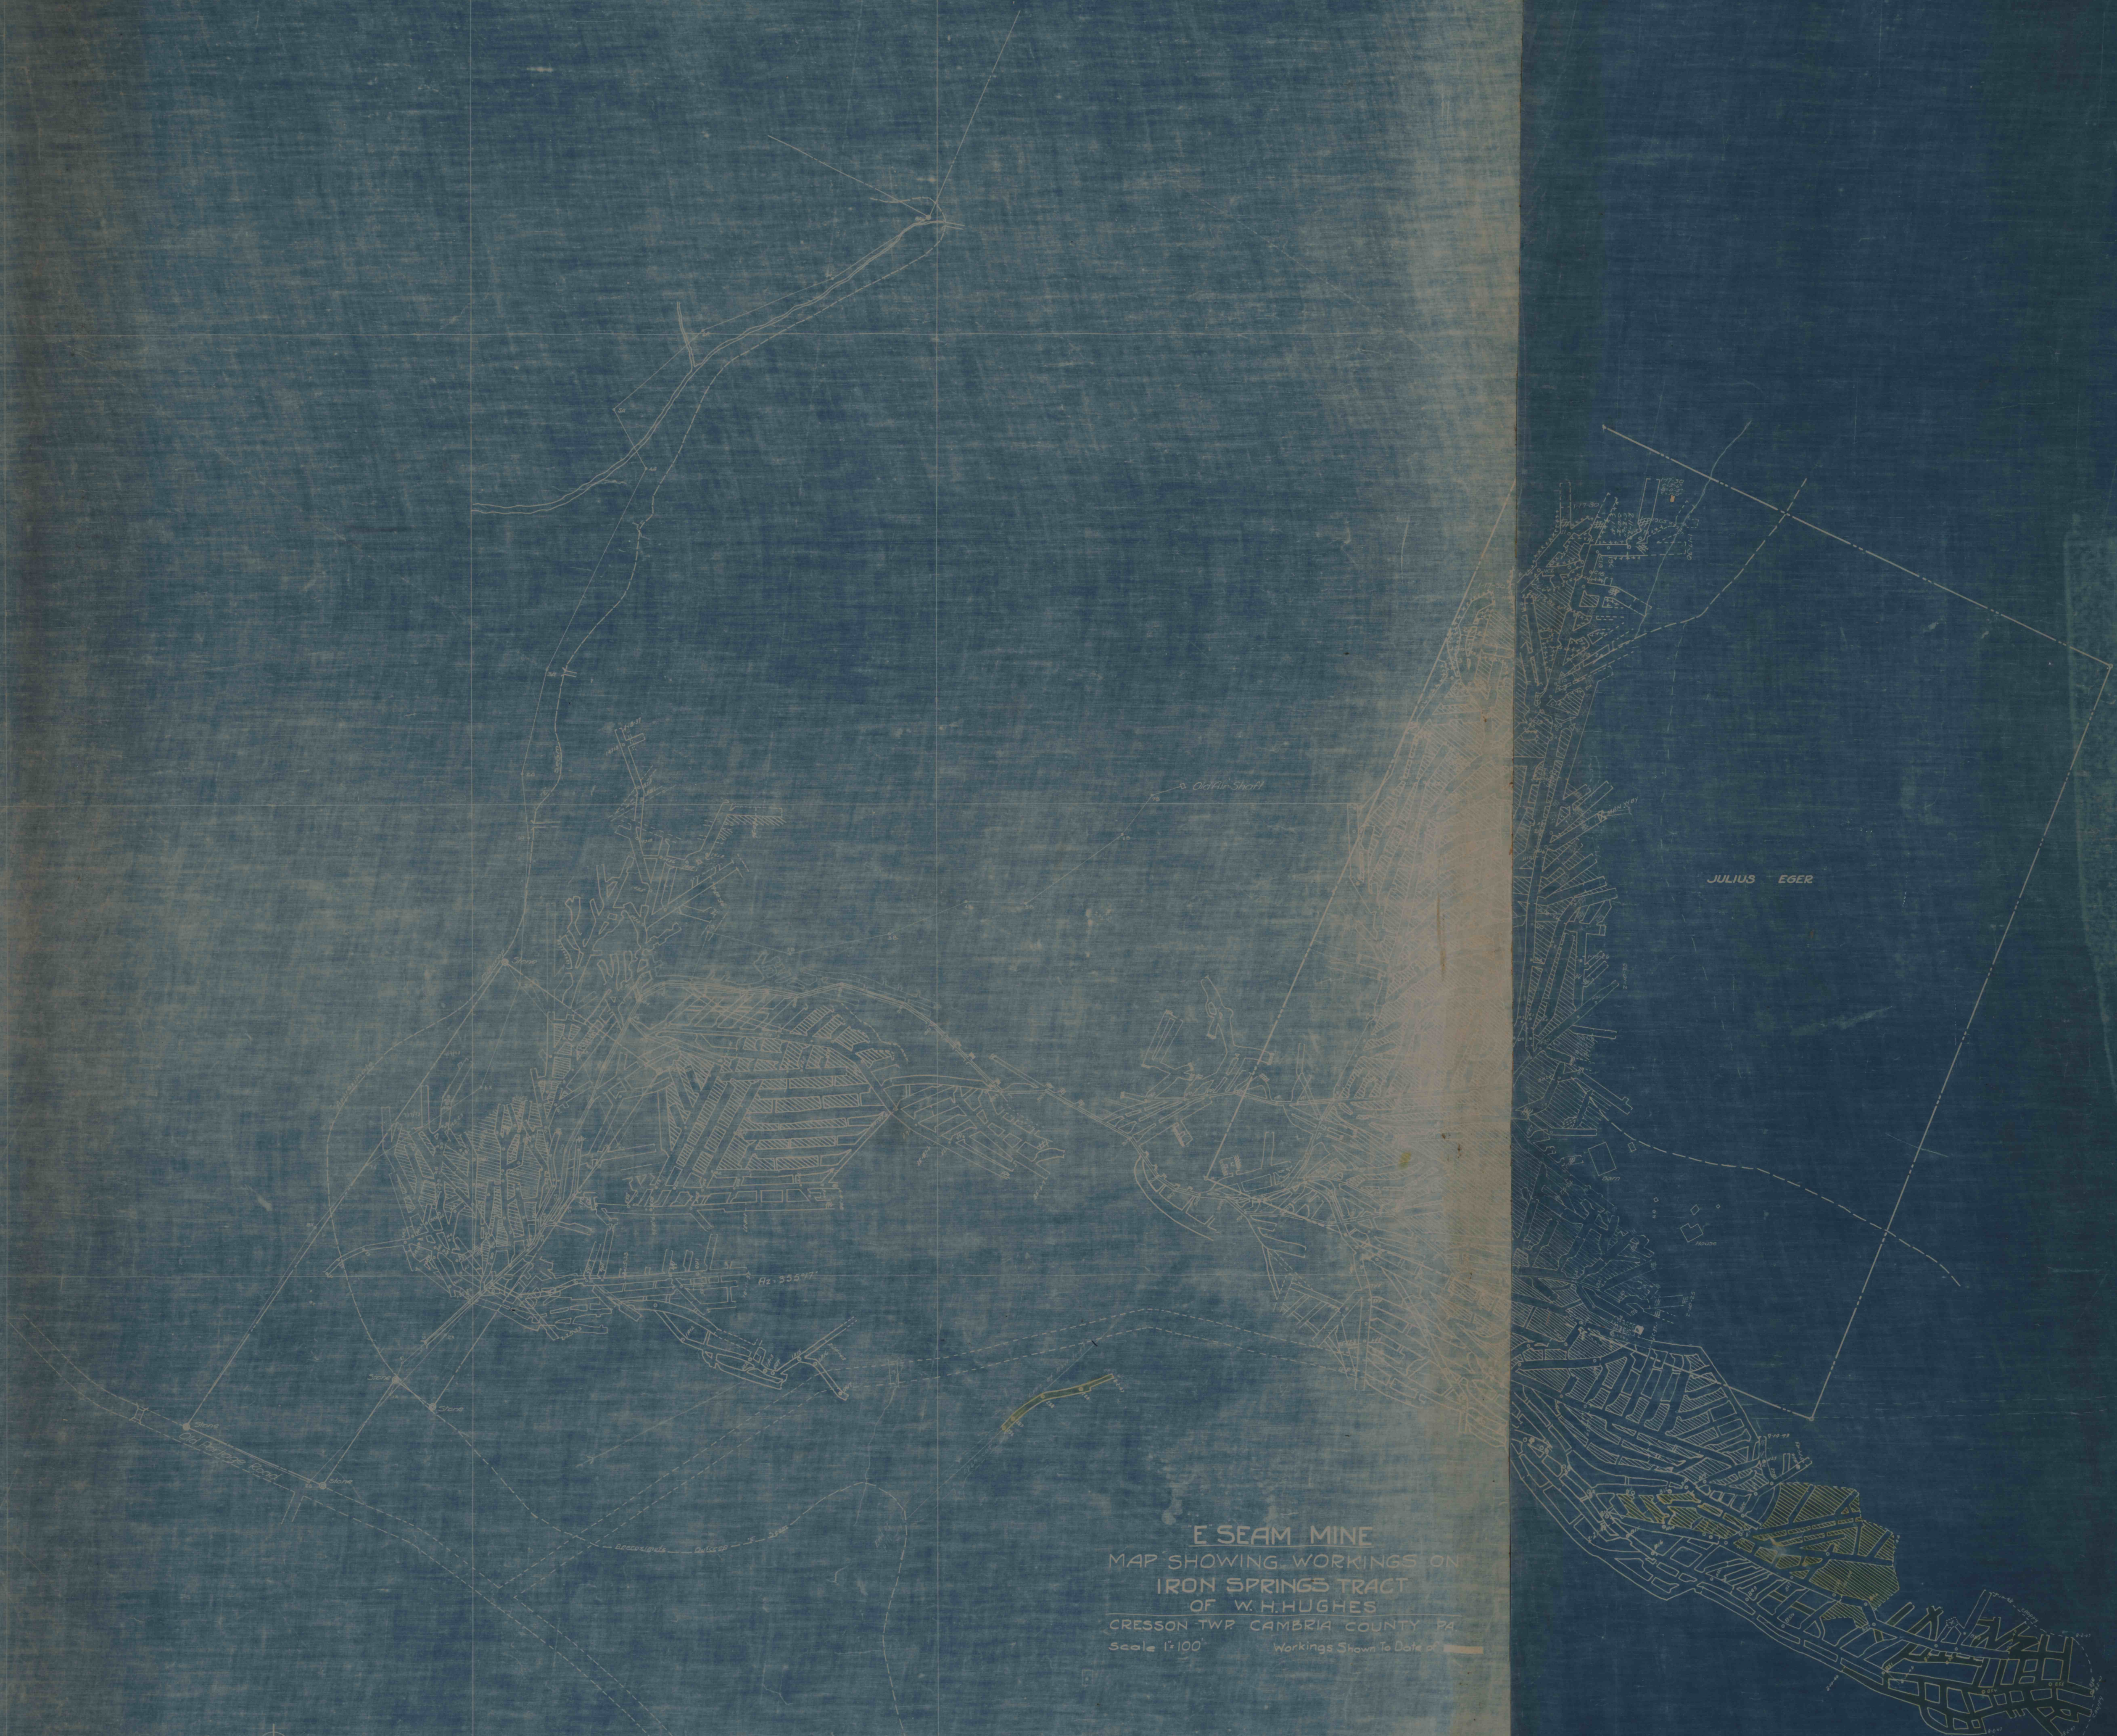

E SEAM MINE
MAP SHOWING WORKINGS ON
IRON SPRINGS TRACT
OF W. H. HUGHES
CRESSON TWP. CAMBRIA COUNTY PA.
Scale 1"=100' Workings Shown To Date of

JULIUS EGER