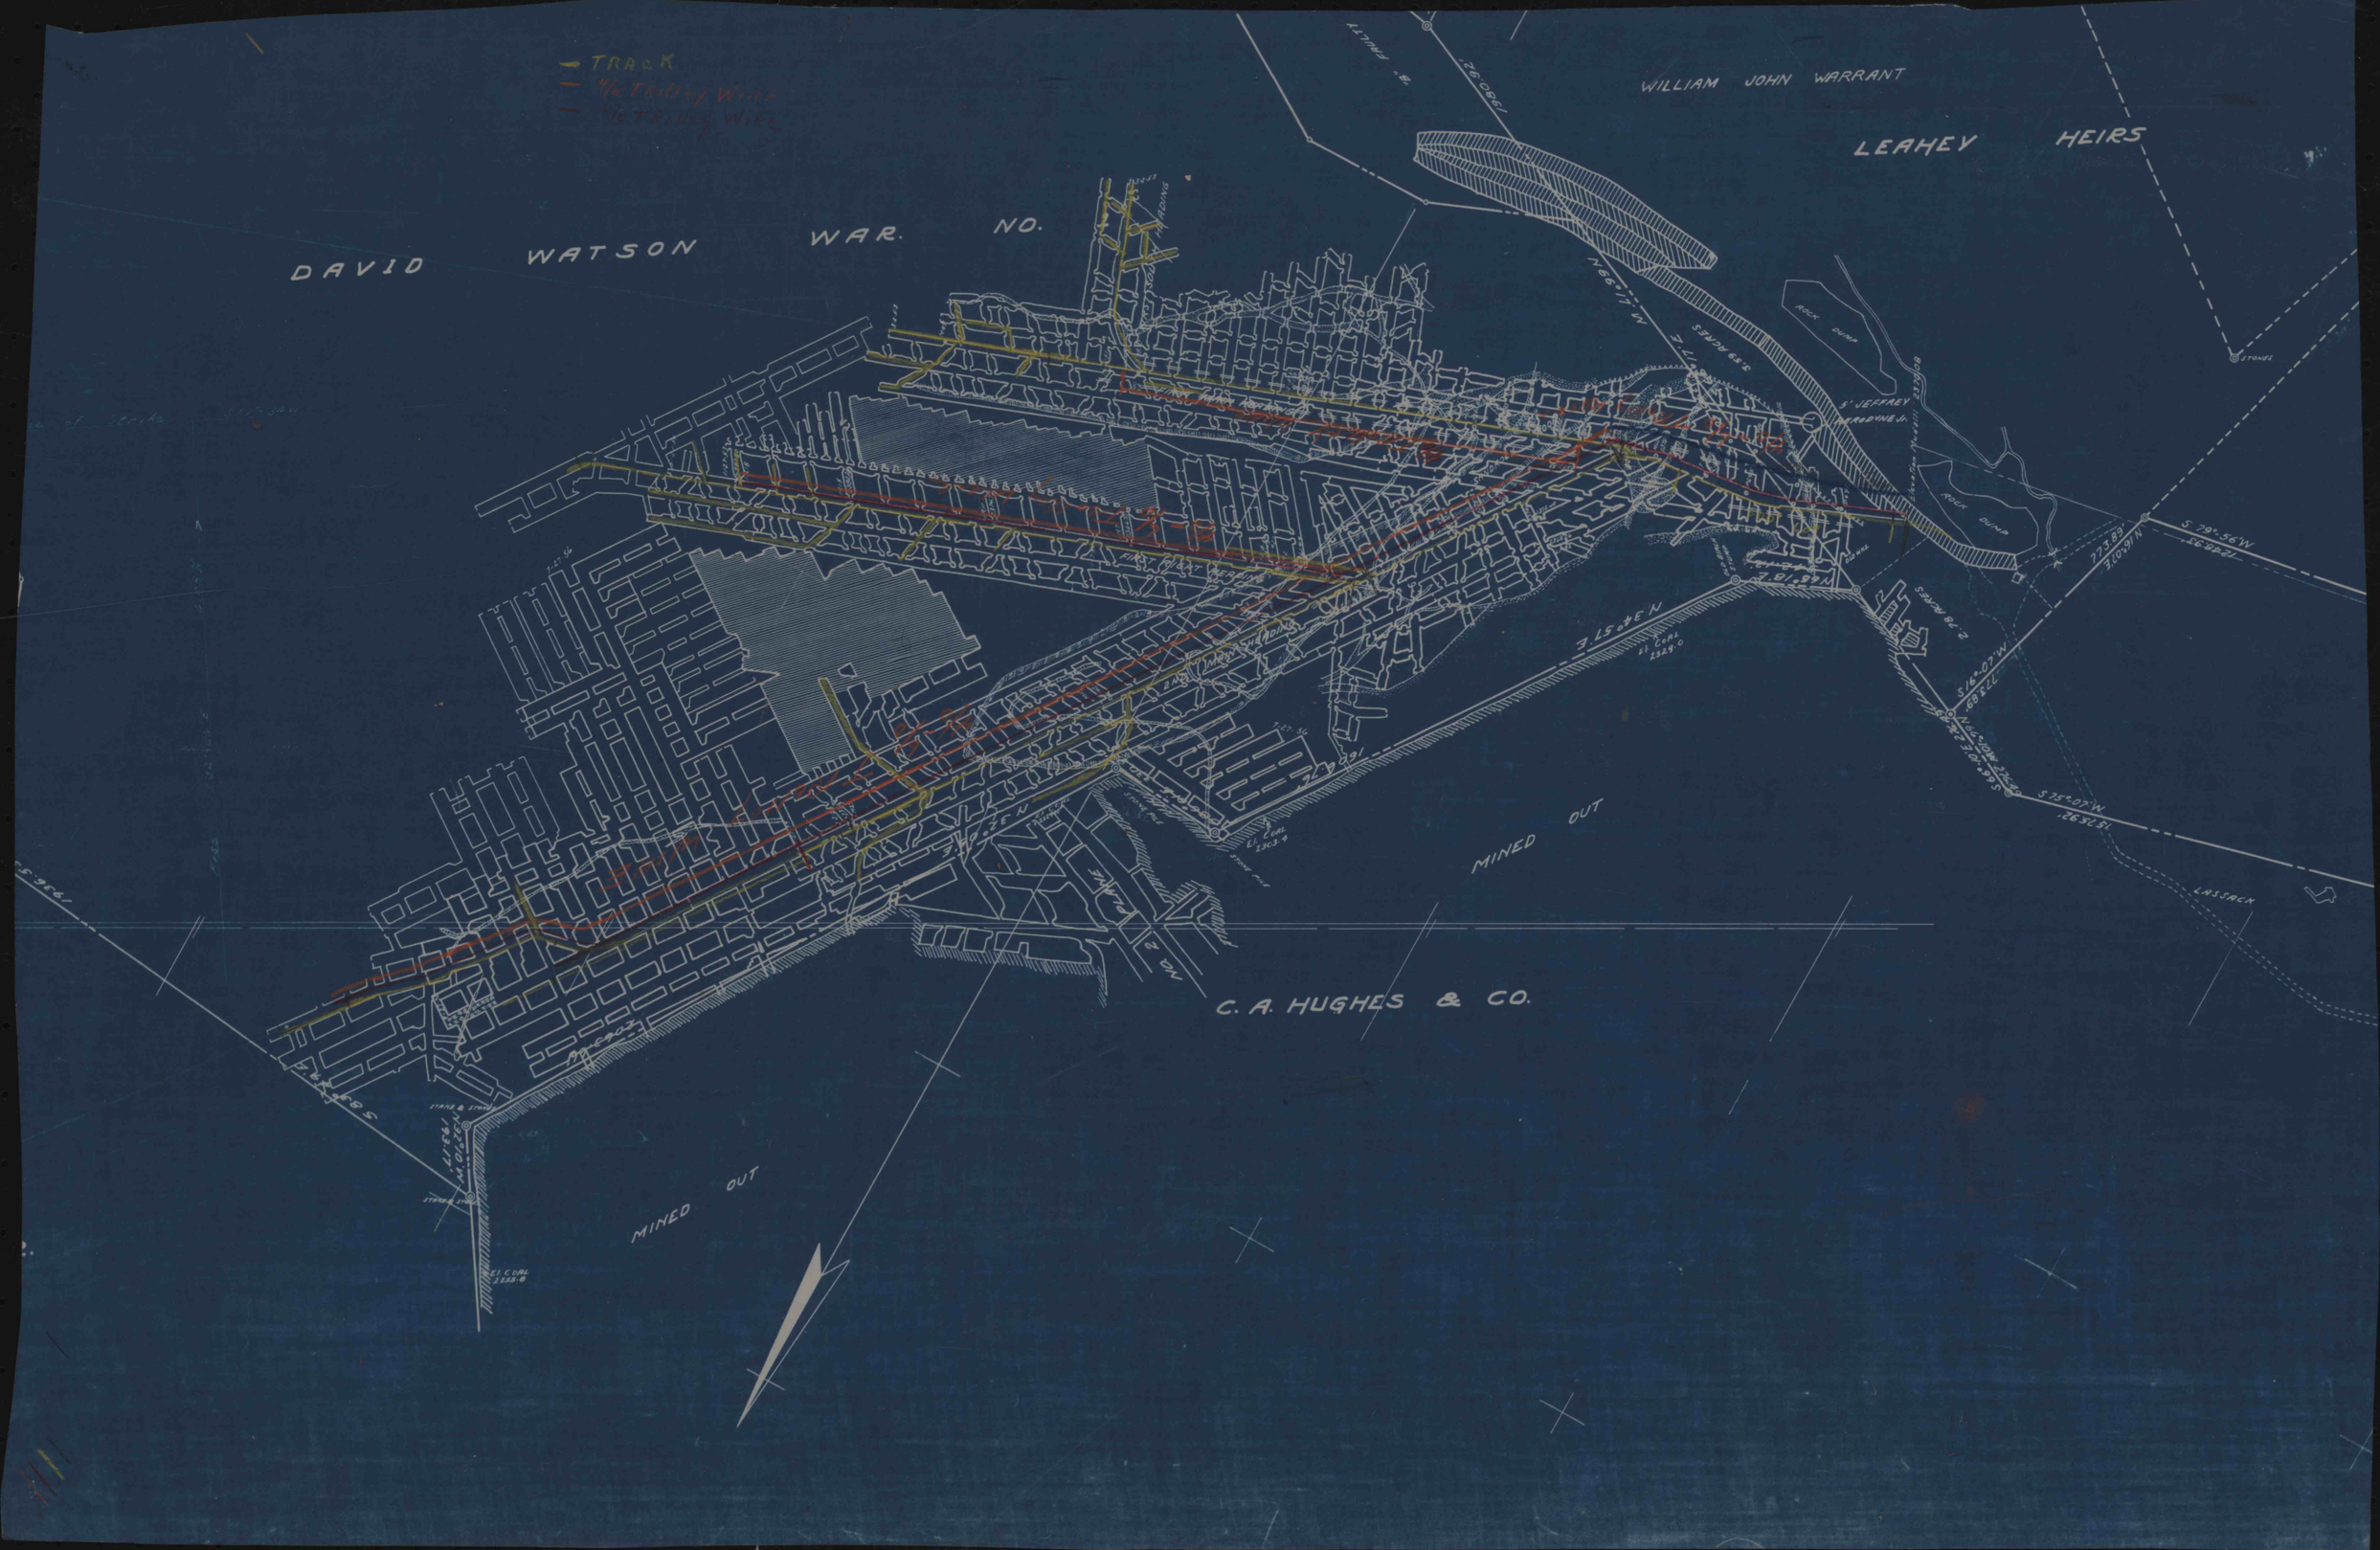
TRACK
WILLIAM JOHN WARRANT
LEAHEY HEIRS
DAVID WATSON WAR. NO.
MINED OUT
C. A. HUGHES & CO.
MINED OUT
LASSACK
ROCK DUMP
ROCK DUMP
S. JEFFREY
STONE
S 79°-56' W
N 66°-07' W
S 16°-07' W
S 35°-07' W
N 38°-57' E
S 38°-57' W
