No. 1 - F7

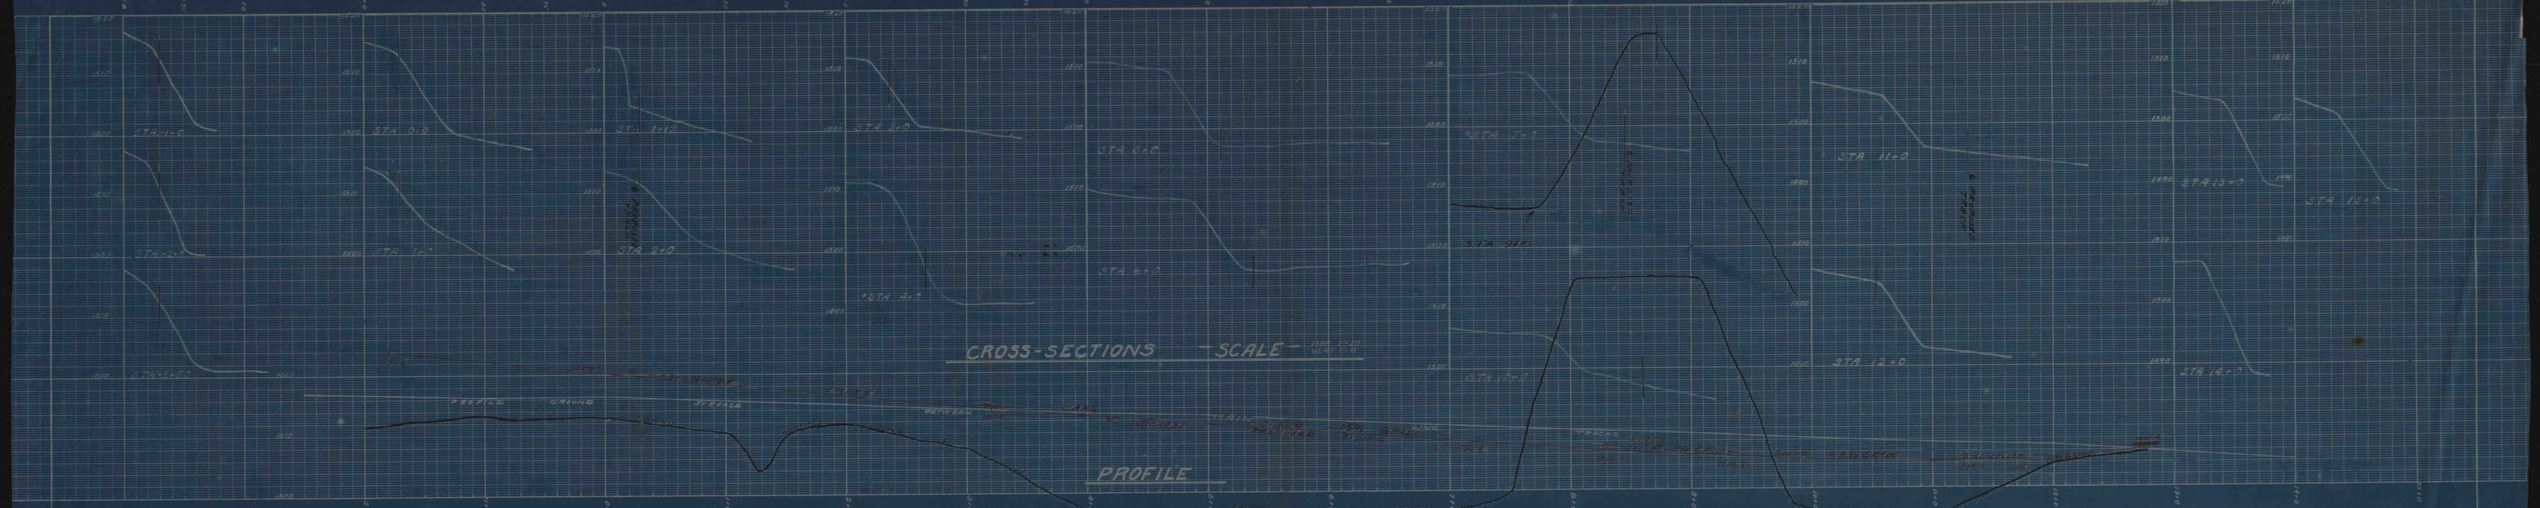

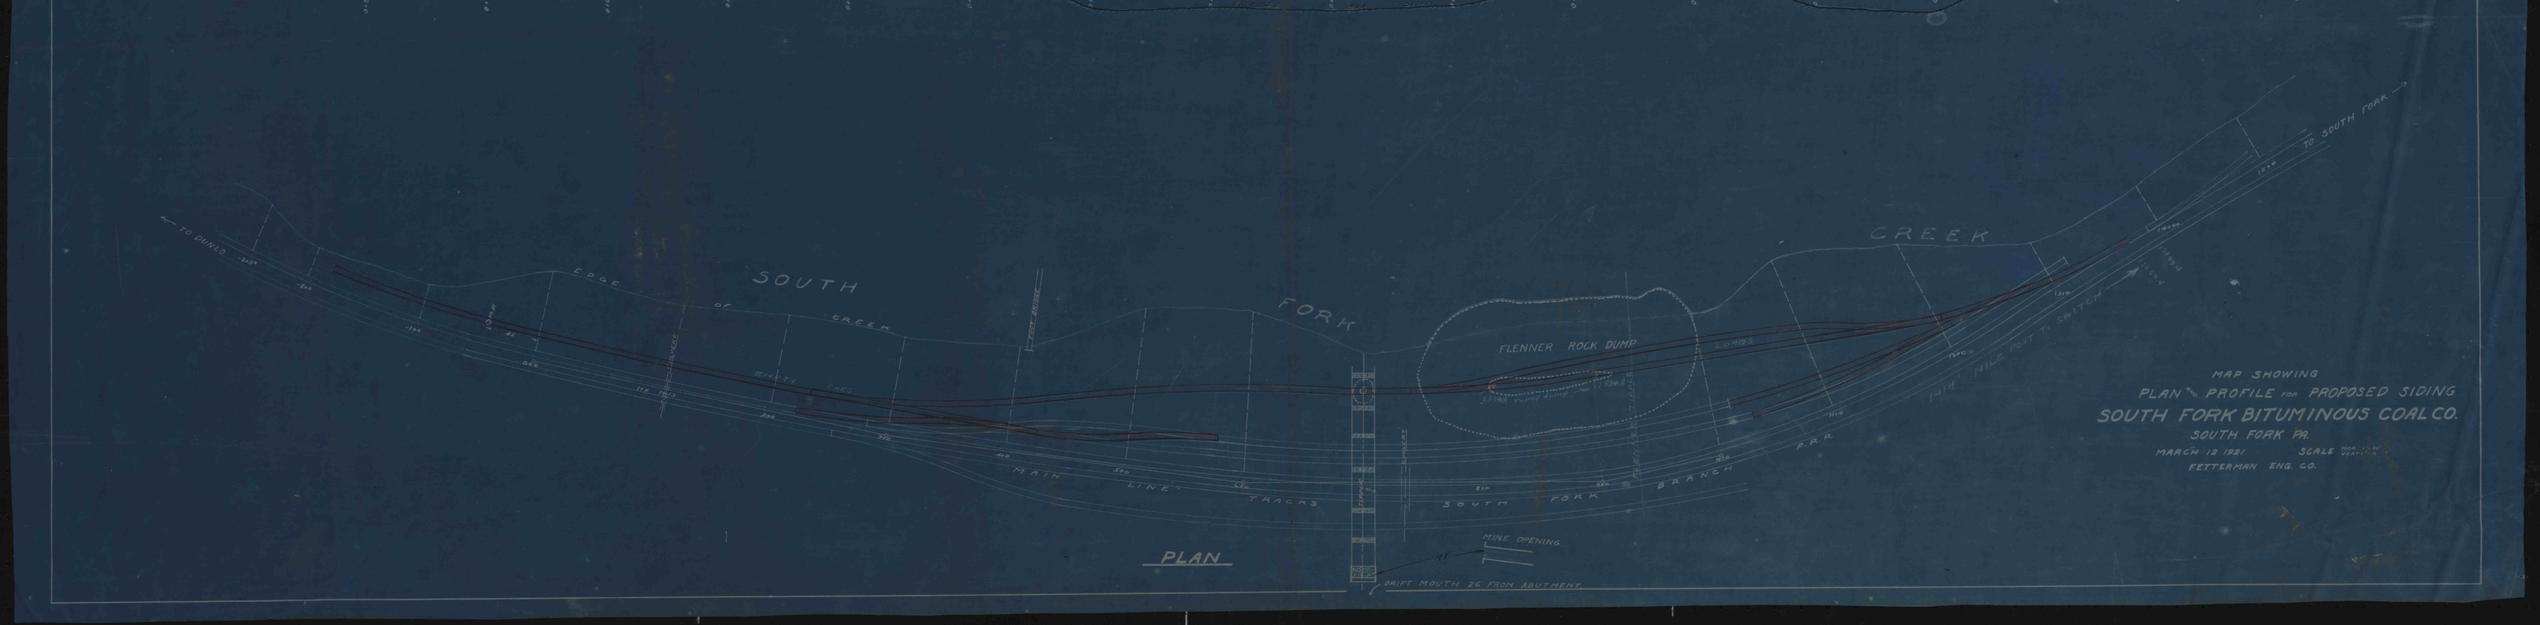

MAP SHOWING
PLAN & PROFILE FOR PROPOSED SIDING
SOUTH FORK BITUMINOUS COAL CO.
SOUTH FORK PA.
MARCH 12 1921 SCALE
FETTERMAN ENG. CO.