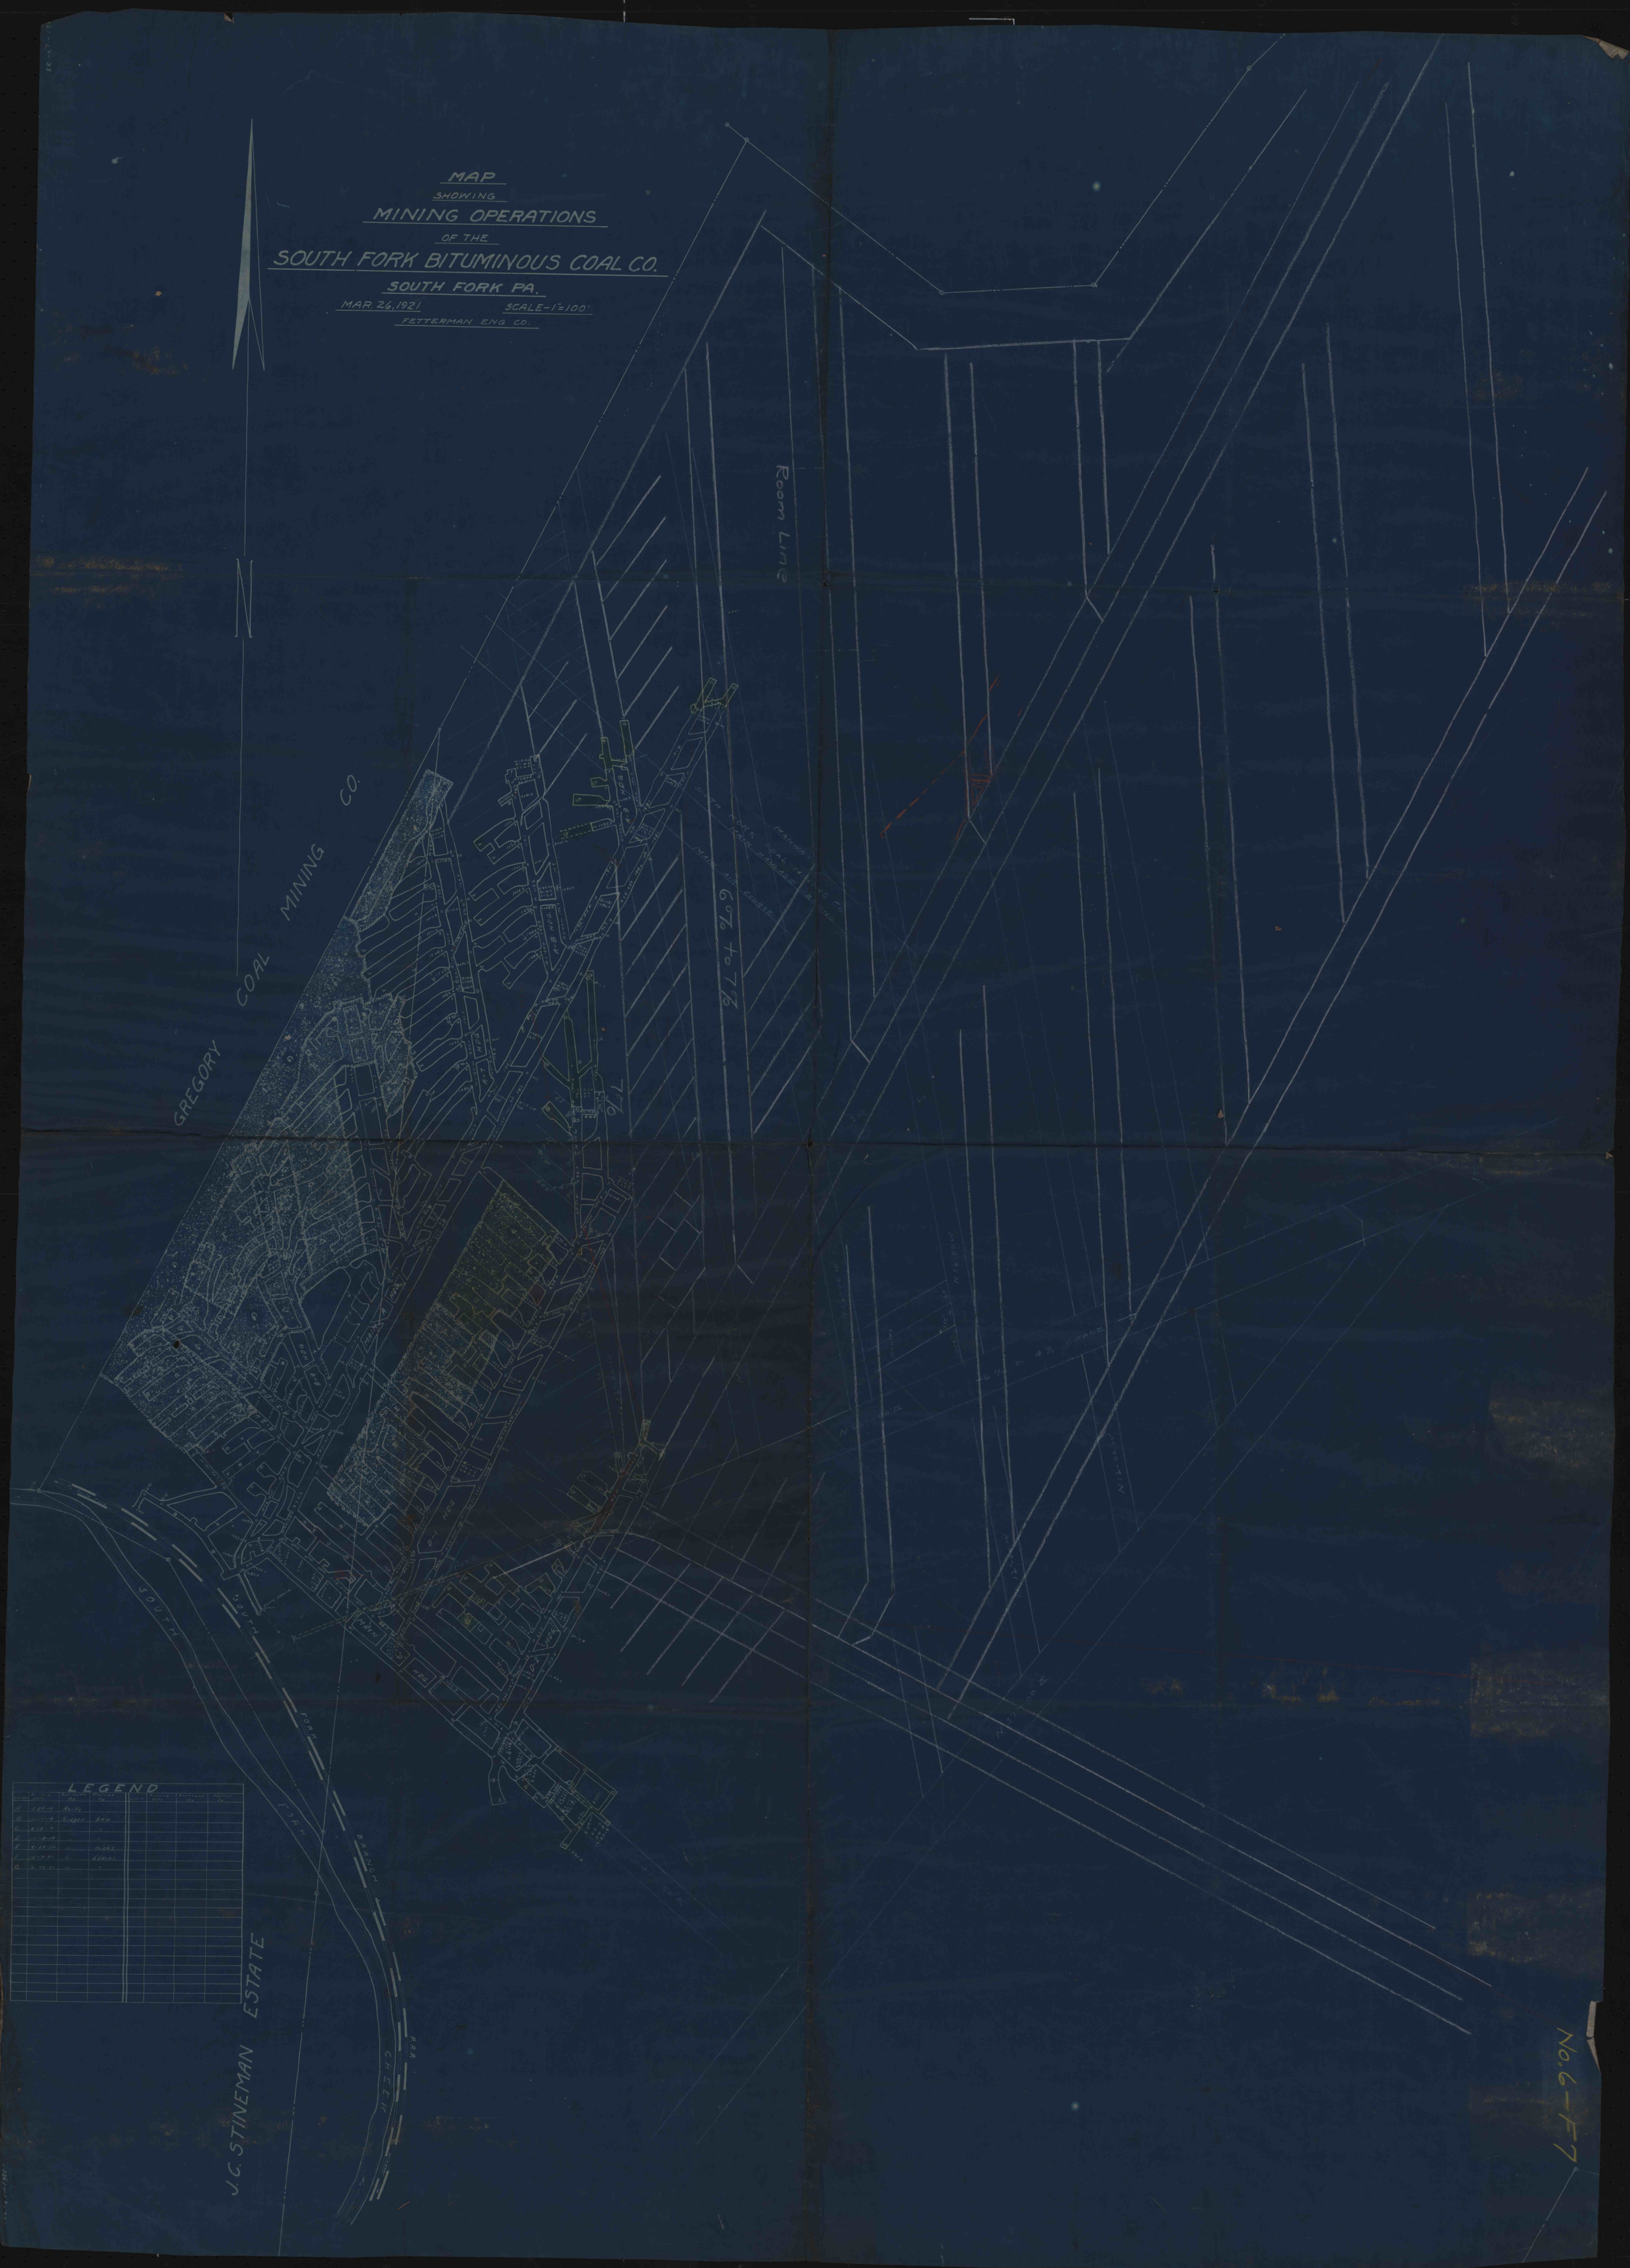
MAP
SHOWING
MINING OPERATIONS
OF THE
SOUTH FORK BITUMINOUS COAL CO.
SOUTH FORK PA.
MAR. 26, 1921
SCALE-1"=100'
FETTERMAN ENG CO.
GREGORY COAL MINING CO.
Room Line
676 to 678
J. C. STINEMAN ESTATE
SOUTH FORK BRANCH
P.R.R.
CHEST
LEGEND
No. 6-F7