


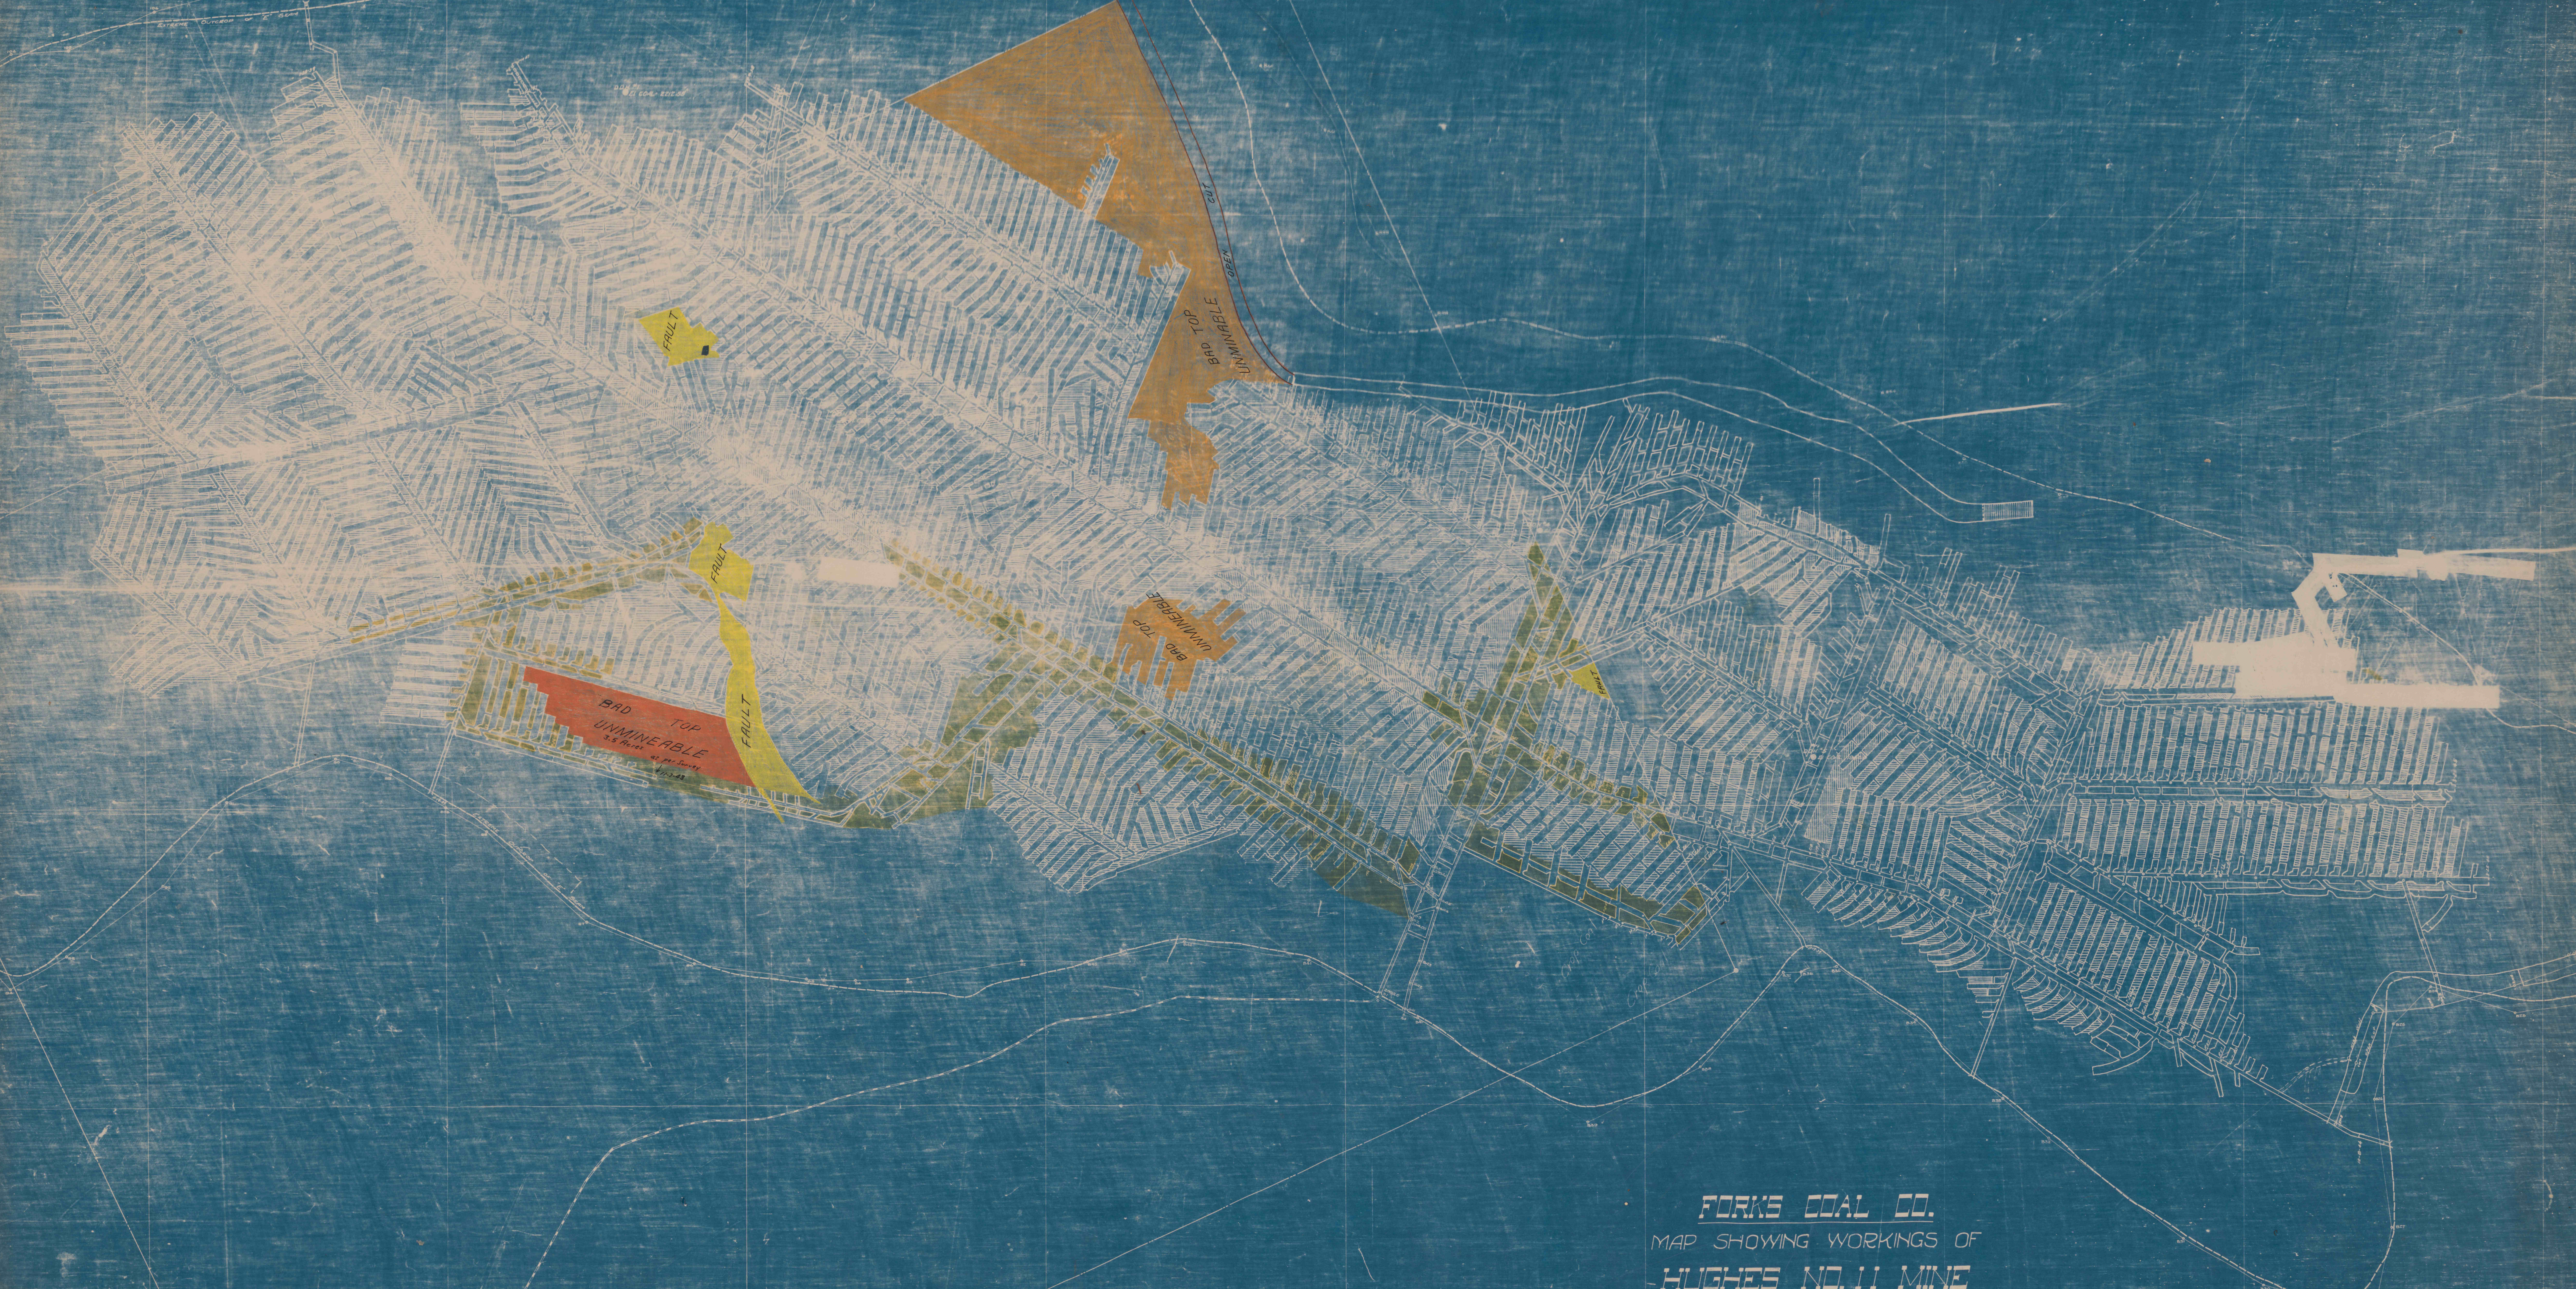

FORKS COAL CO.
MAP SHOWING WORKINGS OF
HUGHES NO. 11 MINE
READE TWP CAMBRIA COUNTY PENNA.
SCALE 1"=100' WORKINGS SHOWN TO DATE OF 1911