


F-19-10

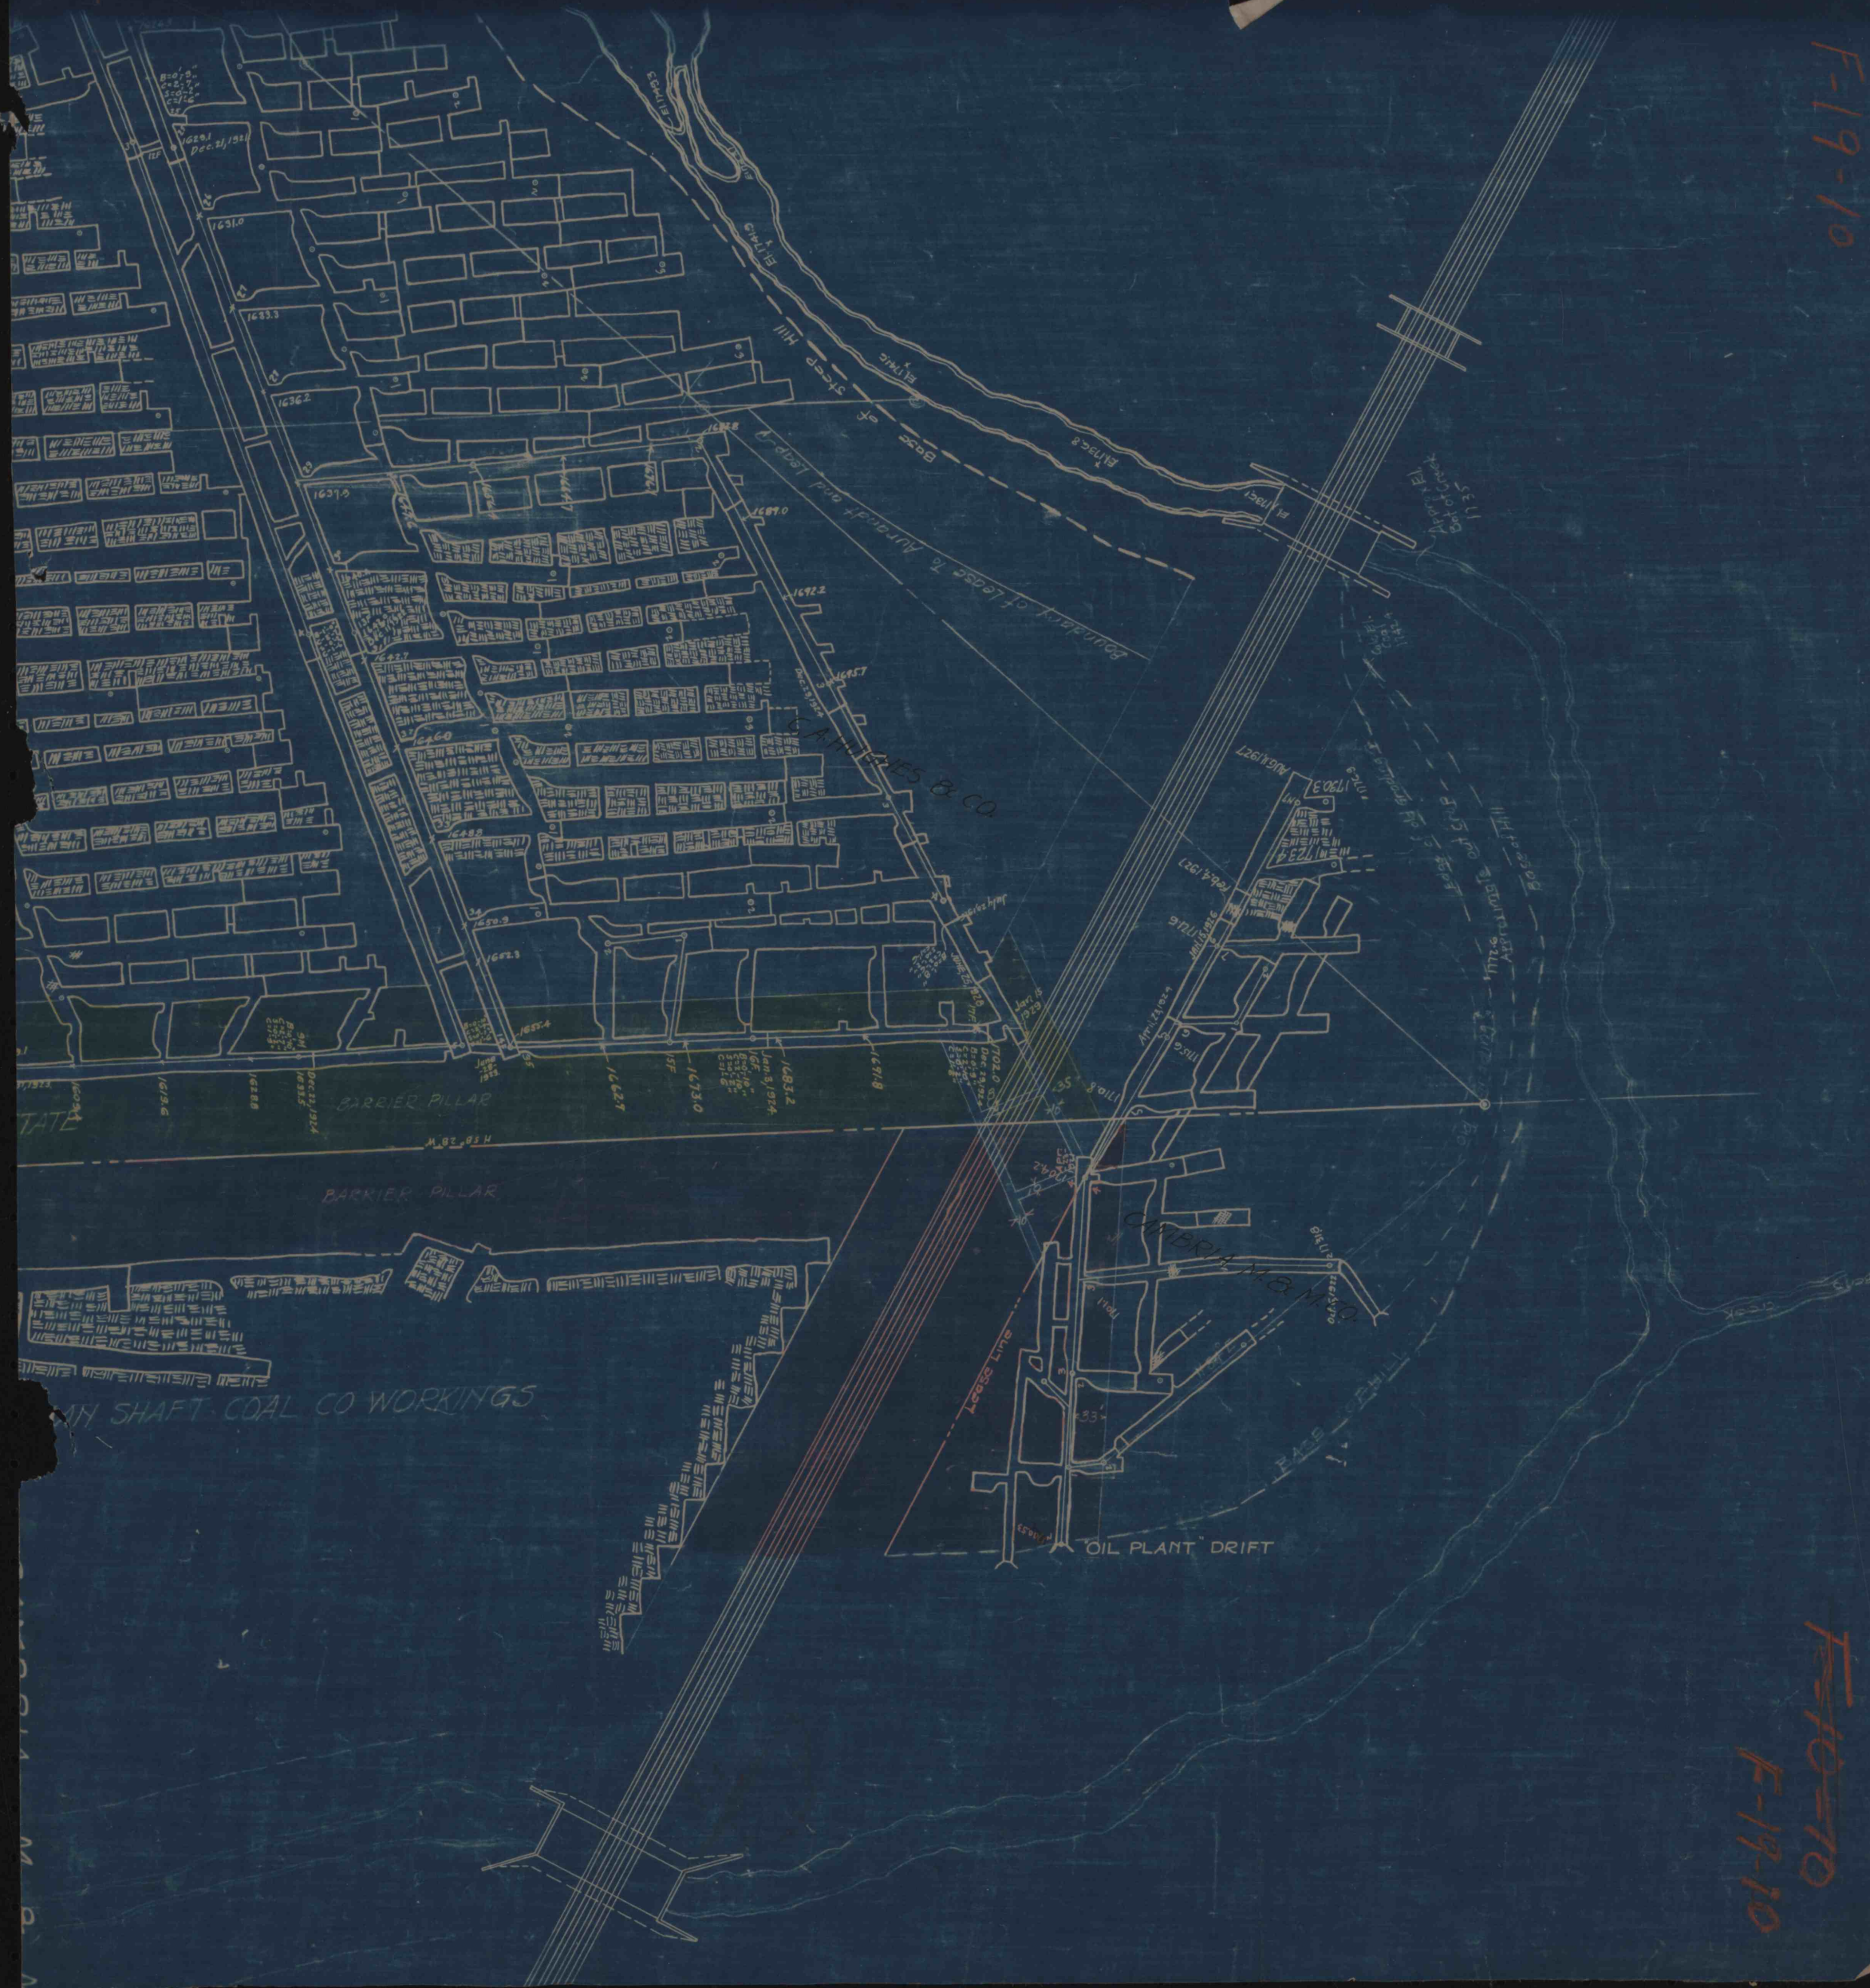

F-10-10

F-19-10