


F-19-7

F-10-7
F-19-7

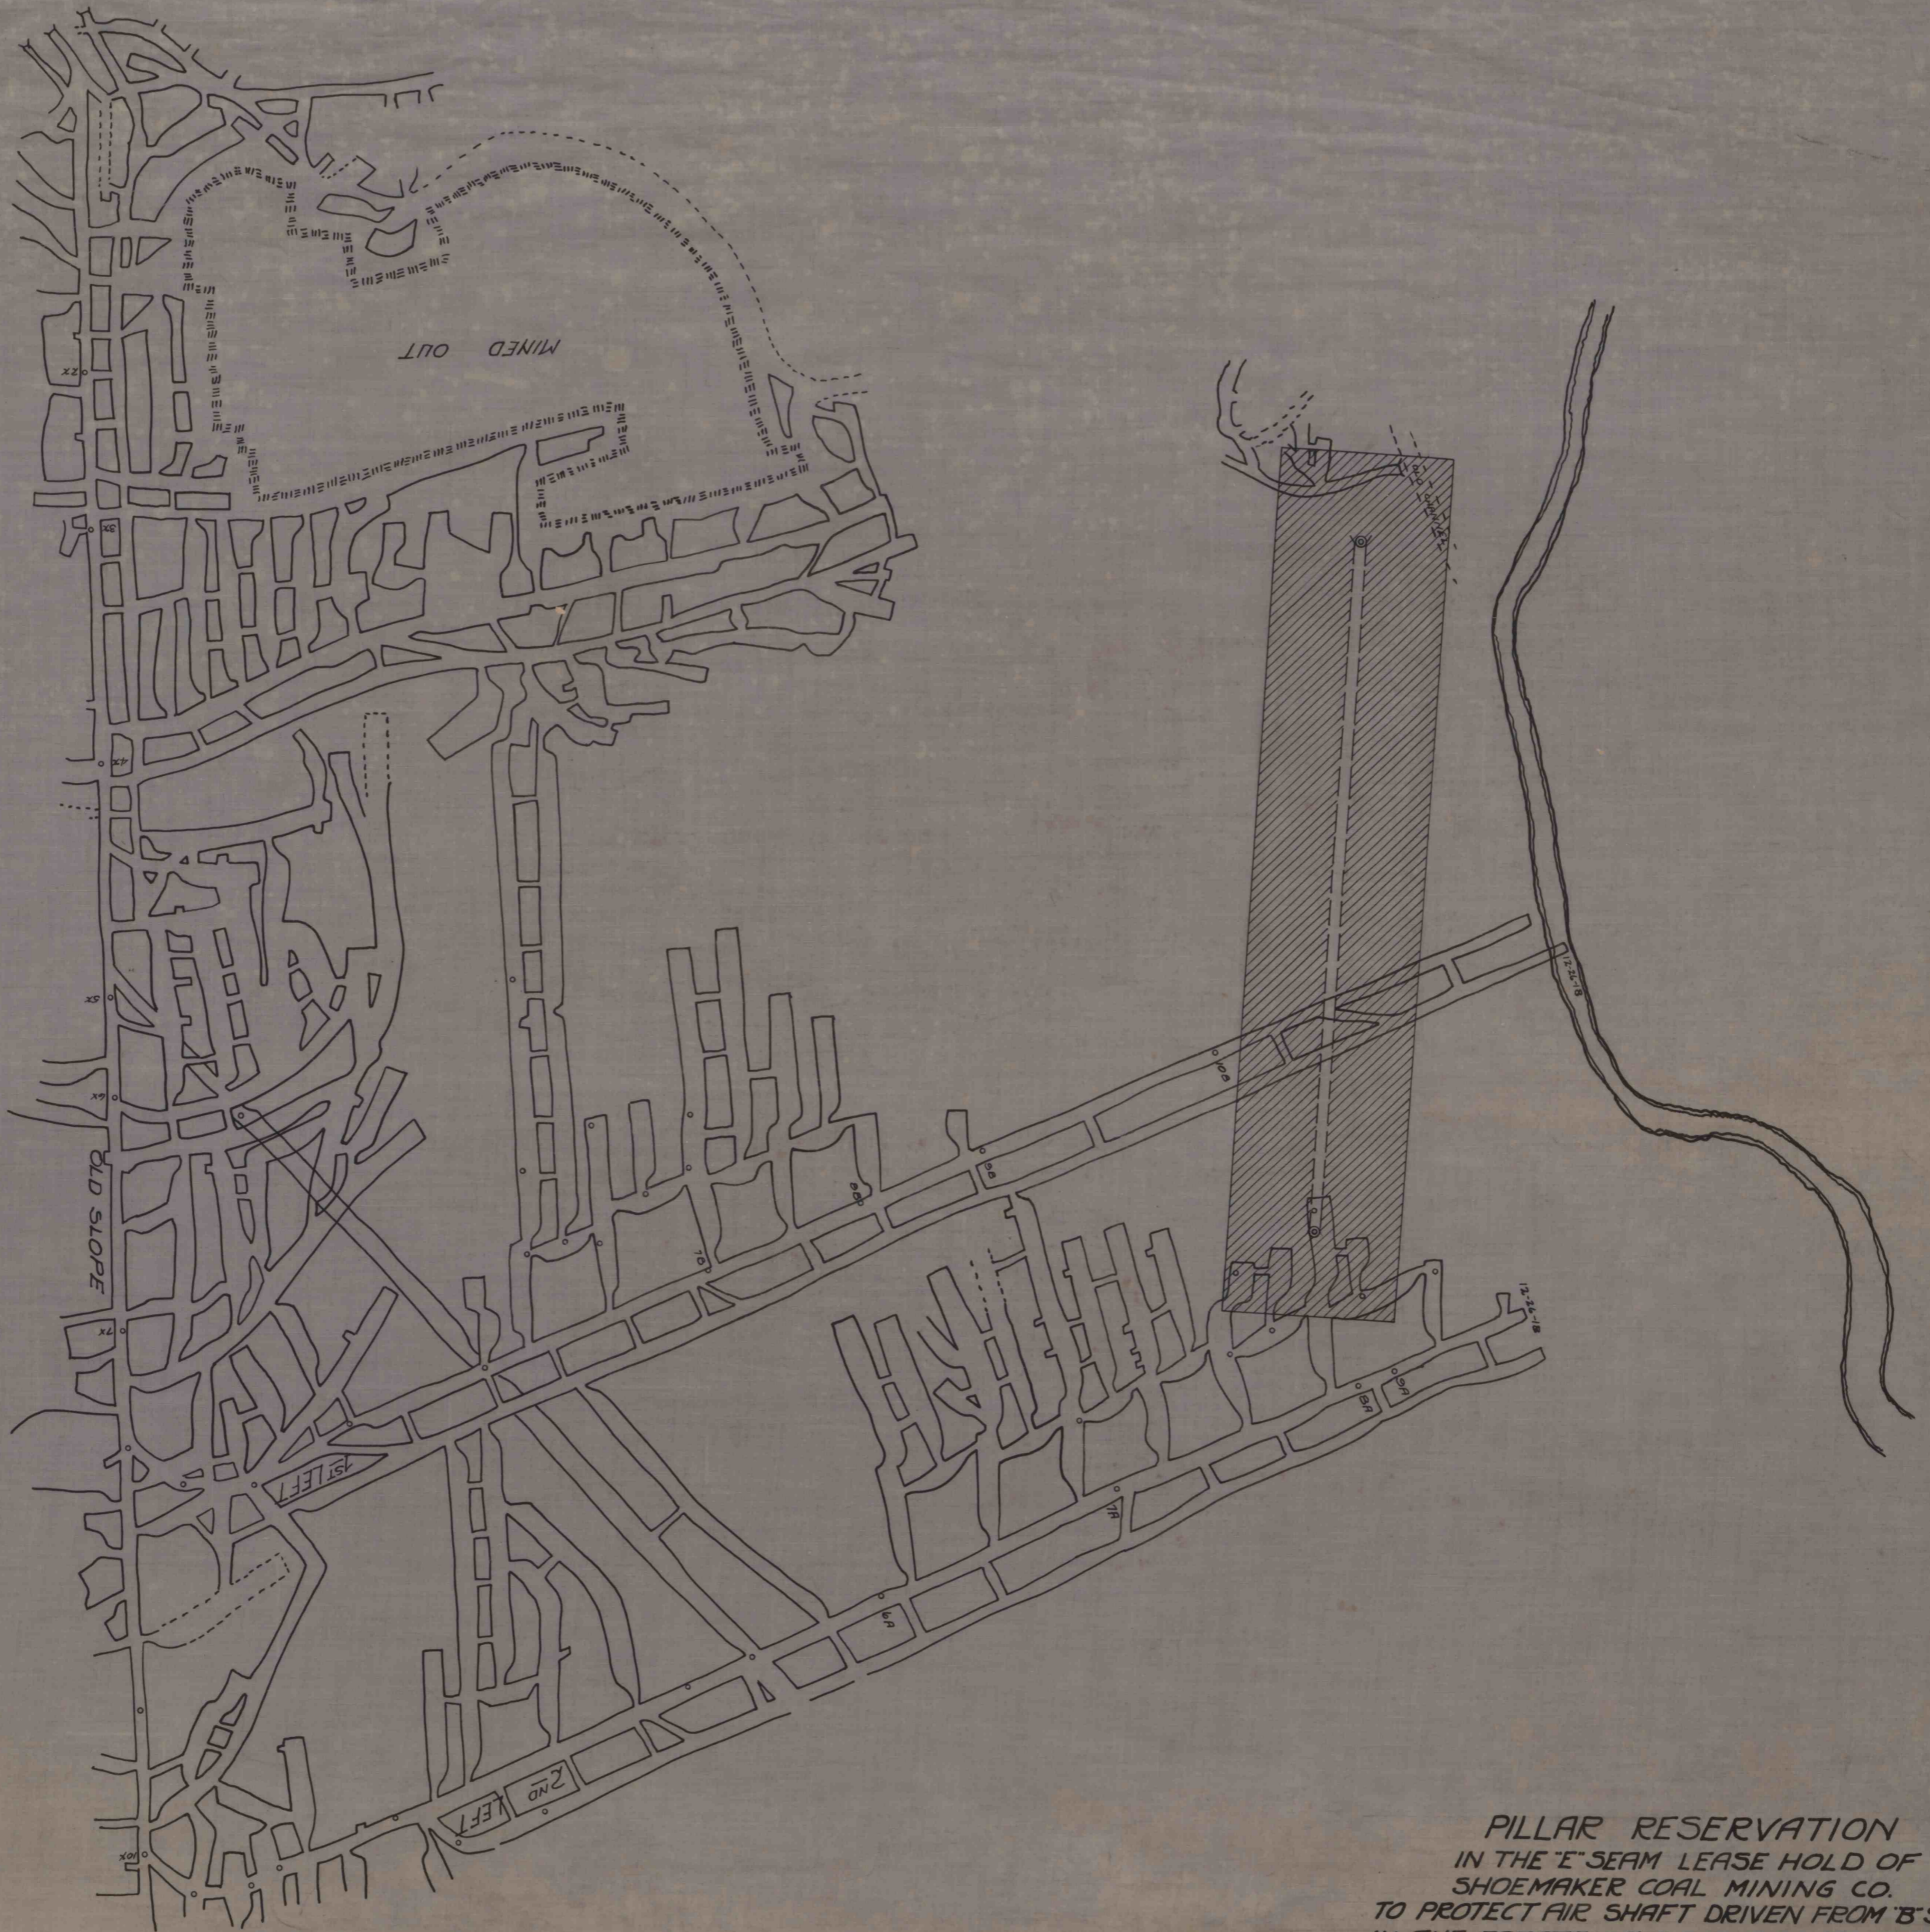

PILLAR RESERVATION
 IN THE 'E' SEAM LEASE HOLD OF
 SHOEMAKER COAL MINING CO.
 TO PROTECT AIR SHAFT DRIVEN FROM 'B' SEAM
 IN THE ESTATE OF C.A. HUGHES TO SURFACE
 DATE 10-30-29 HUGHES ENG. DEPT.

F-10-7