


F-19-8

F-10-8

F-19-8

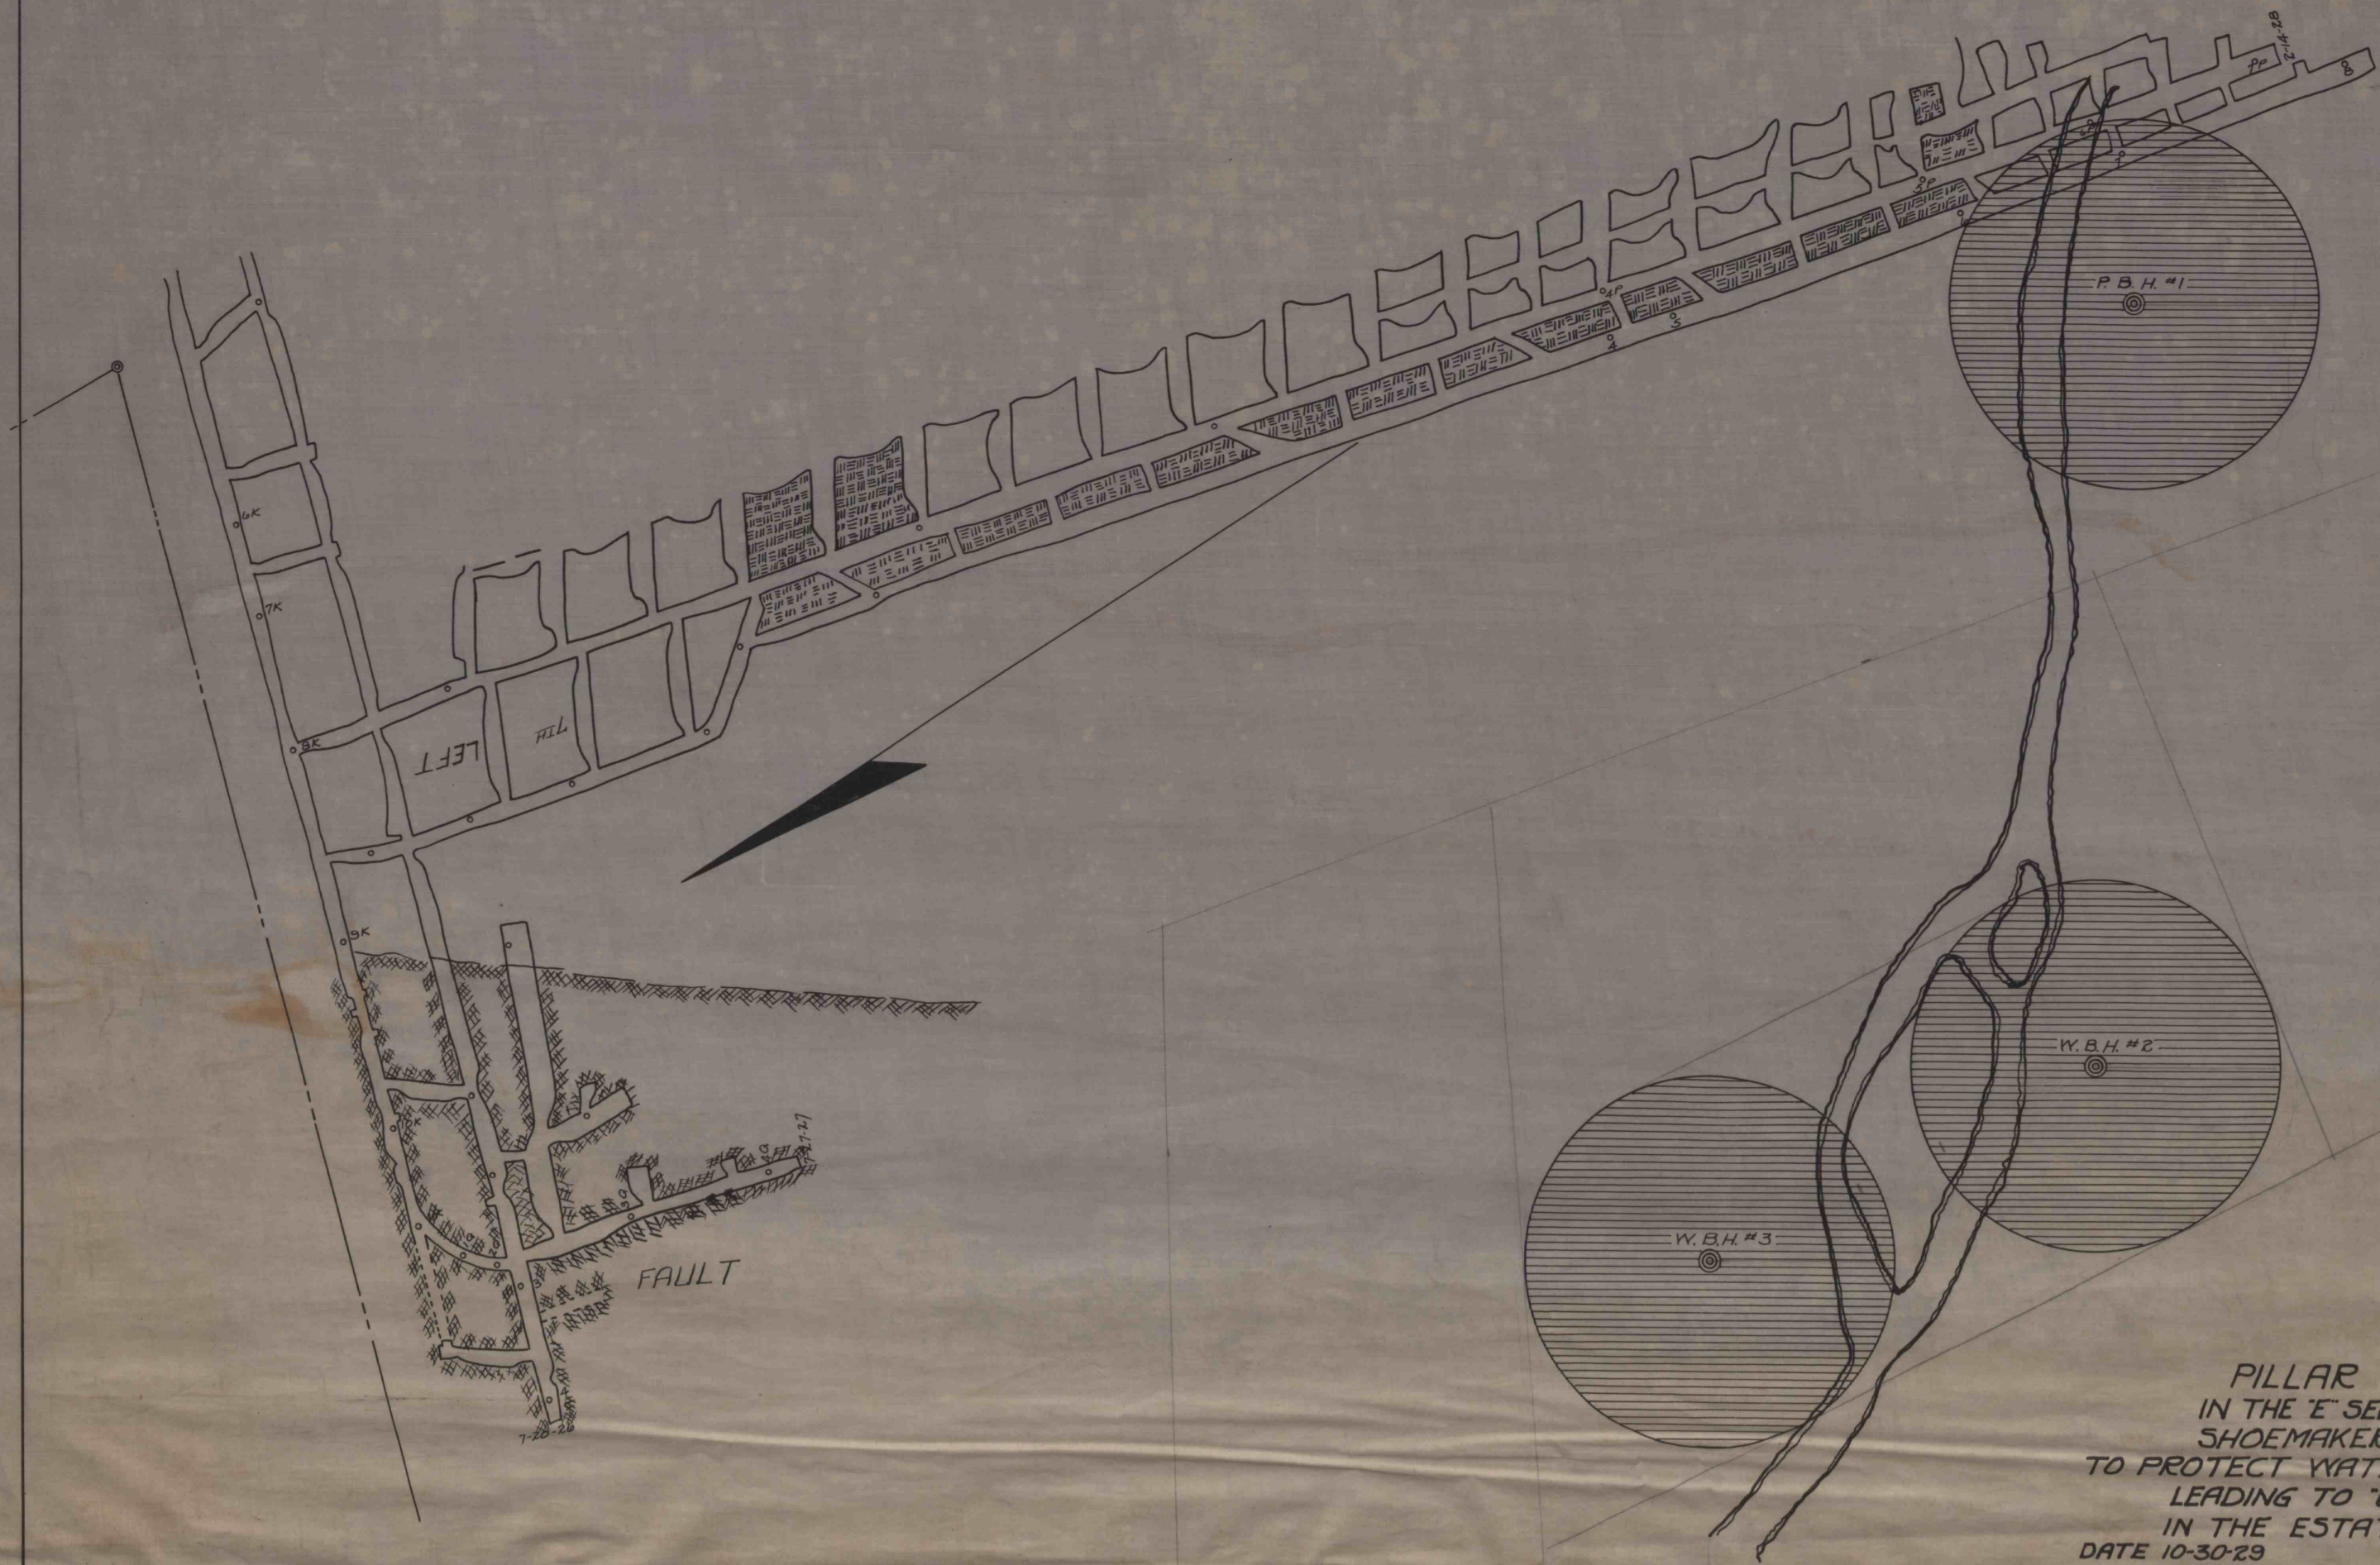

PILLAR RESERVATION
 IN THE 'E' SEAM LEASE HOLD OF
 SHOEMAKER COAL MINING CO.
 TO PROTECT WATER & POWER BORE HOLES
 LEADING TO 'B' SEAM WORKINGS
 IN THE ESTATE OF C. A. HUGHES
 DATE 10-30-29 HUGHES ENG. DEPT.

F-10-8