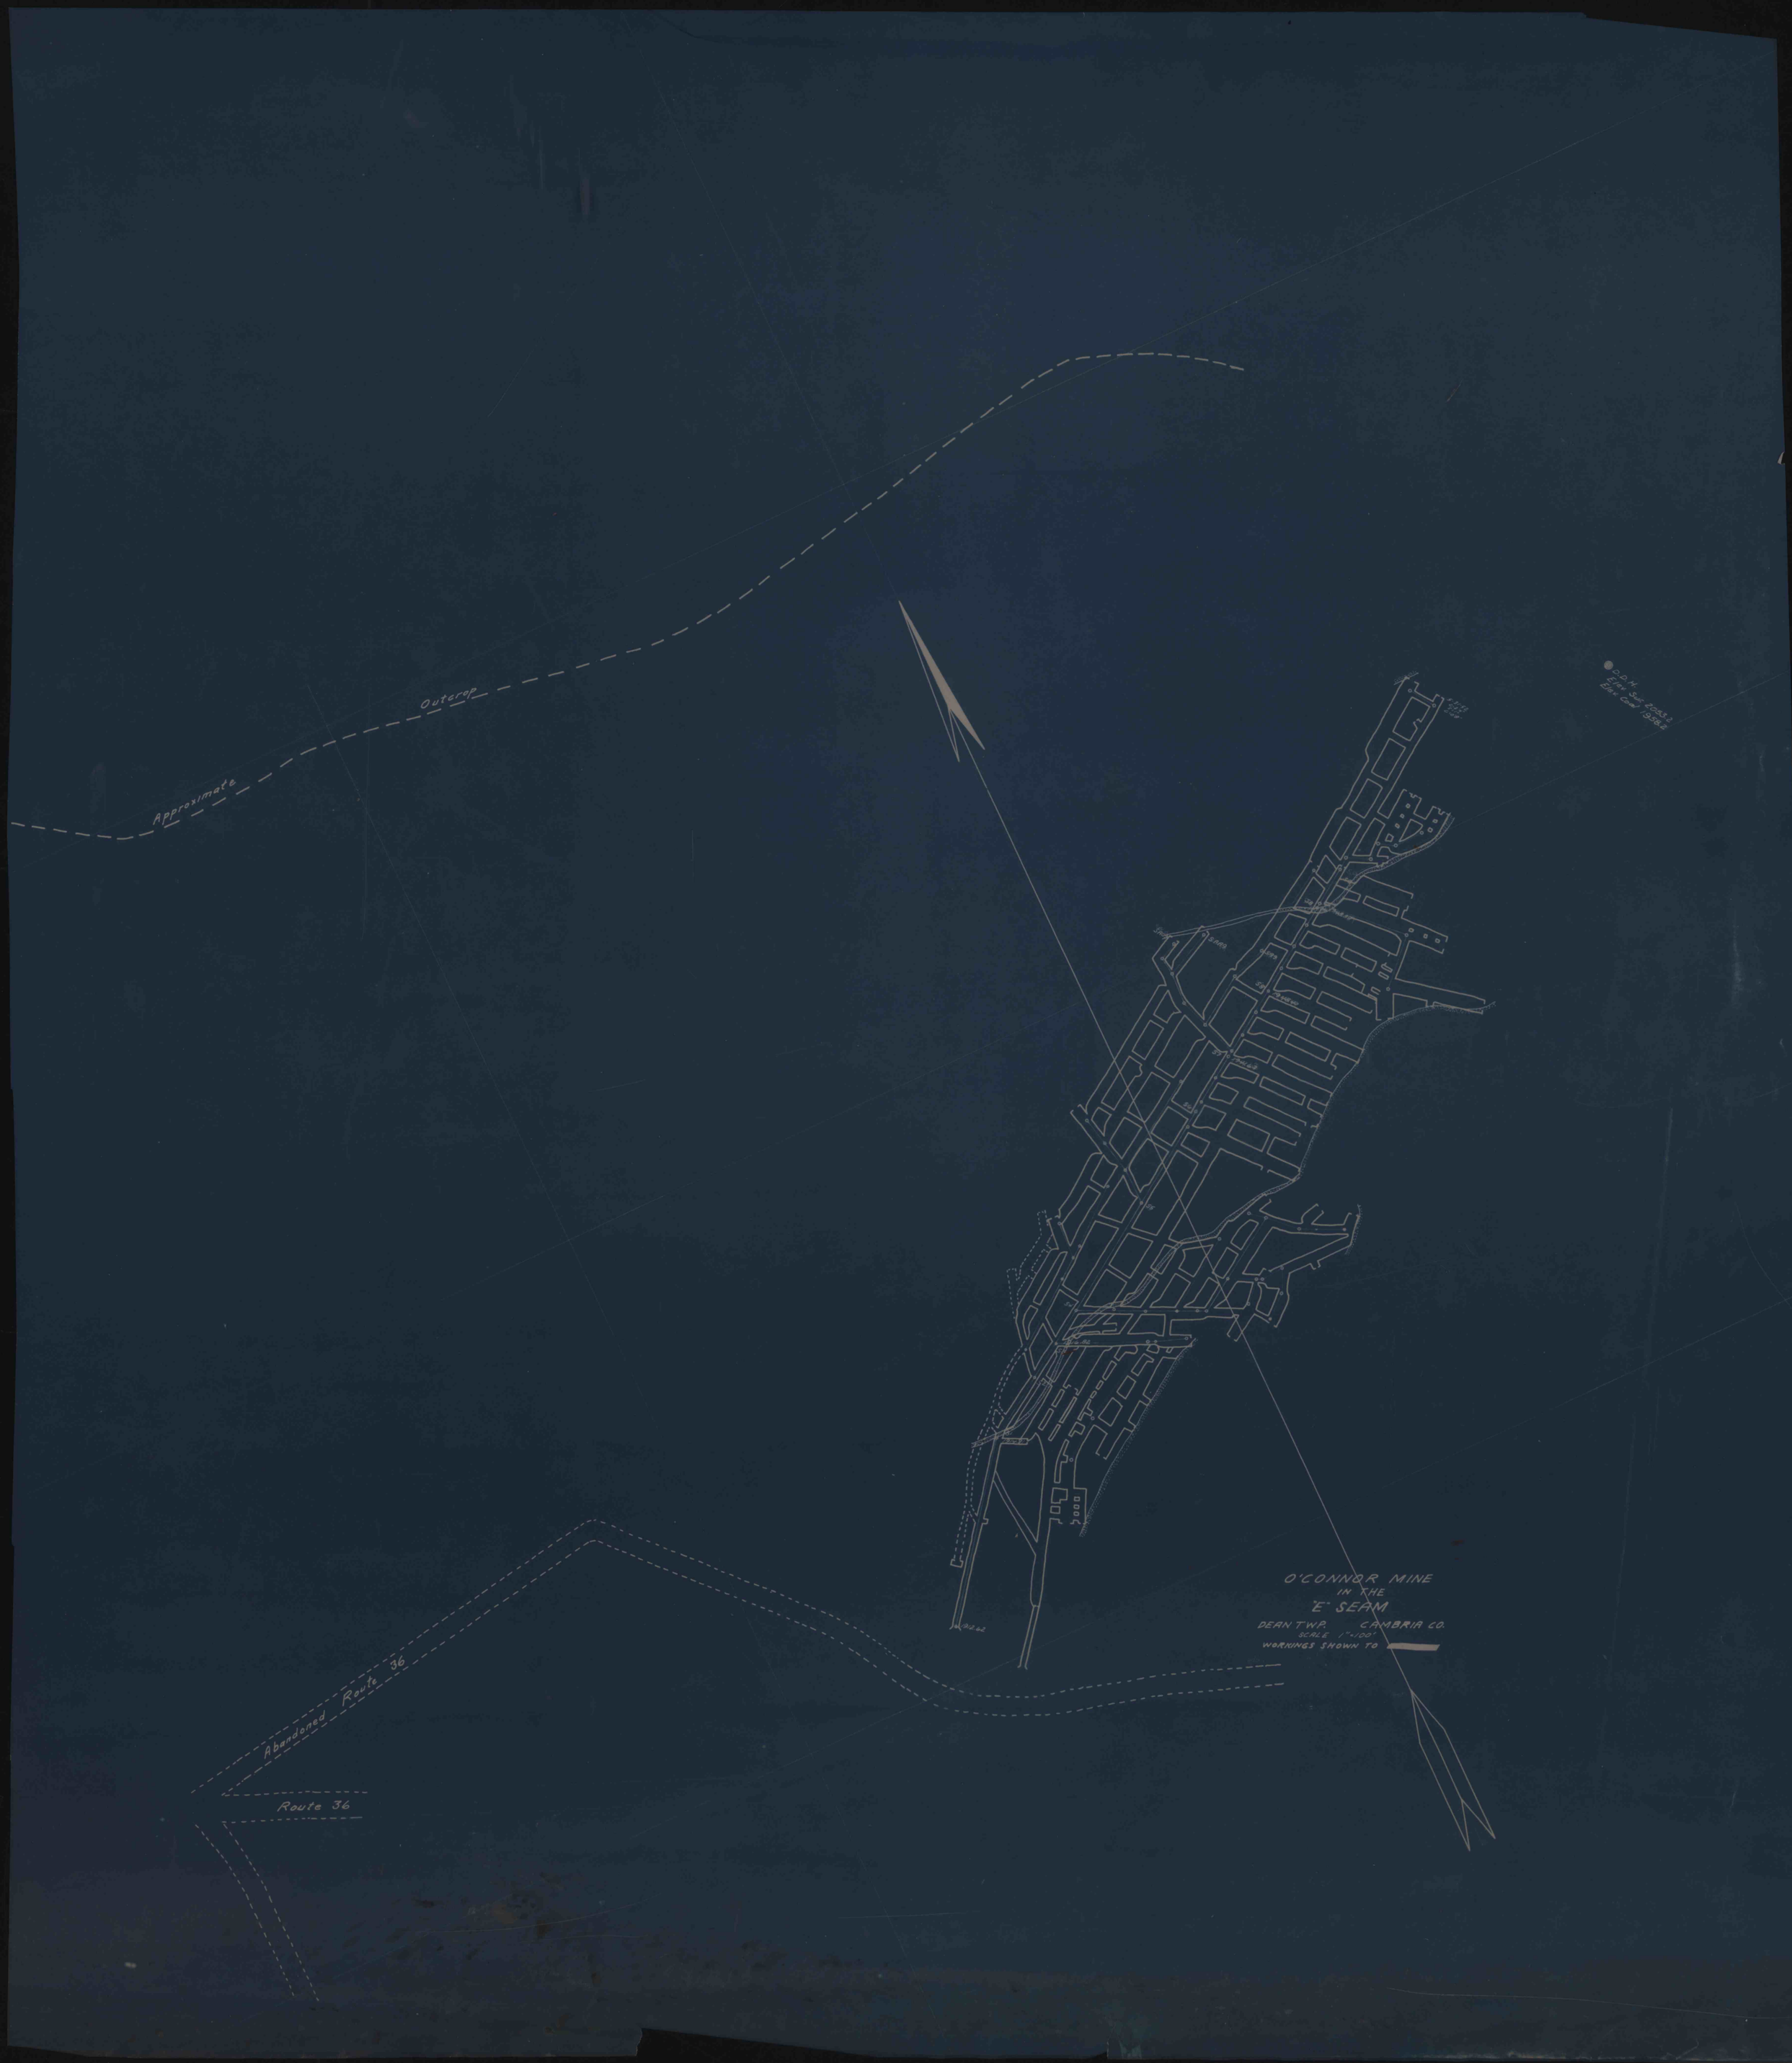
Approximate Outcrop
Abandoned Route 36
Route 36
O'CONNOR MINE
IN THE
"E" SEAM
DEAN T.W.P. CAMBRIA CO.
SCALE 1"=100'
WORKINGS SHOWN TO