




MAP OF UPPER WORKINGS OF
'B' SEAM MINE OF
W.H. PIPER & CO. INC.
-SCALE 1" = 100' -

I, RICHARD L. WESTLEY, REGISTERED SURVEYOR
CORRECT COPY OF LAST OPERATIONS OF
W.H. PIPER & CO. INC.
Signed Richard L. Westley
LAST OPERATIONS 2-25-20
LAST WORKED 2-11-20

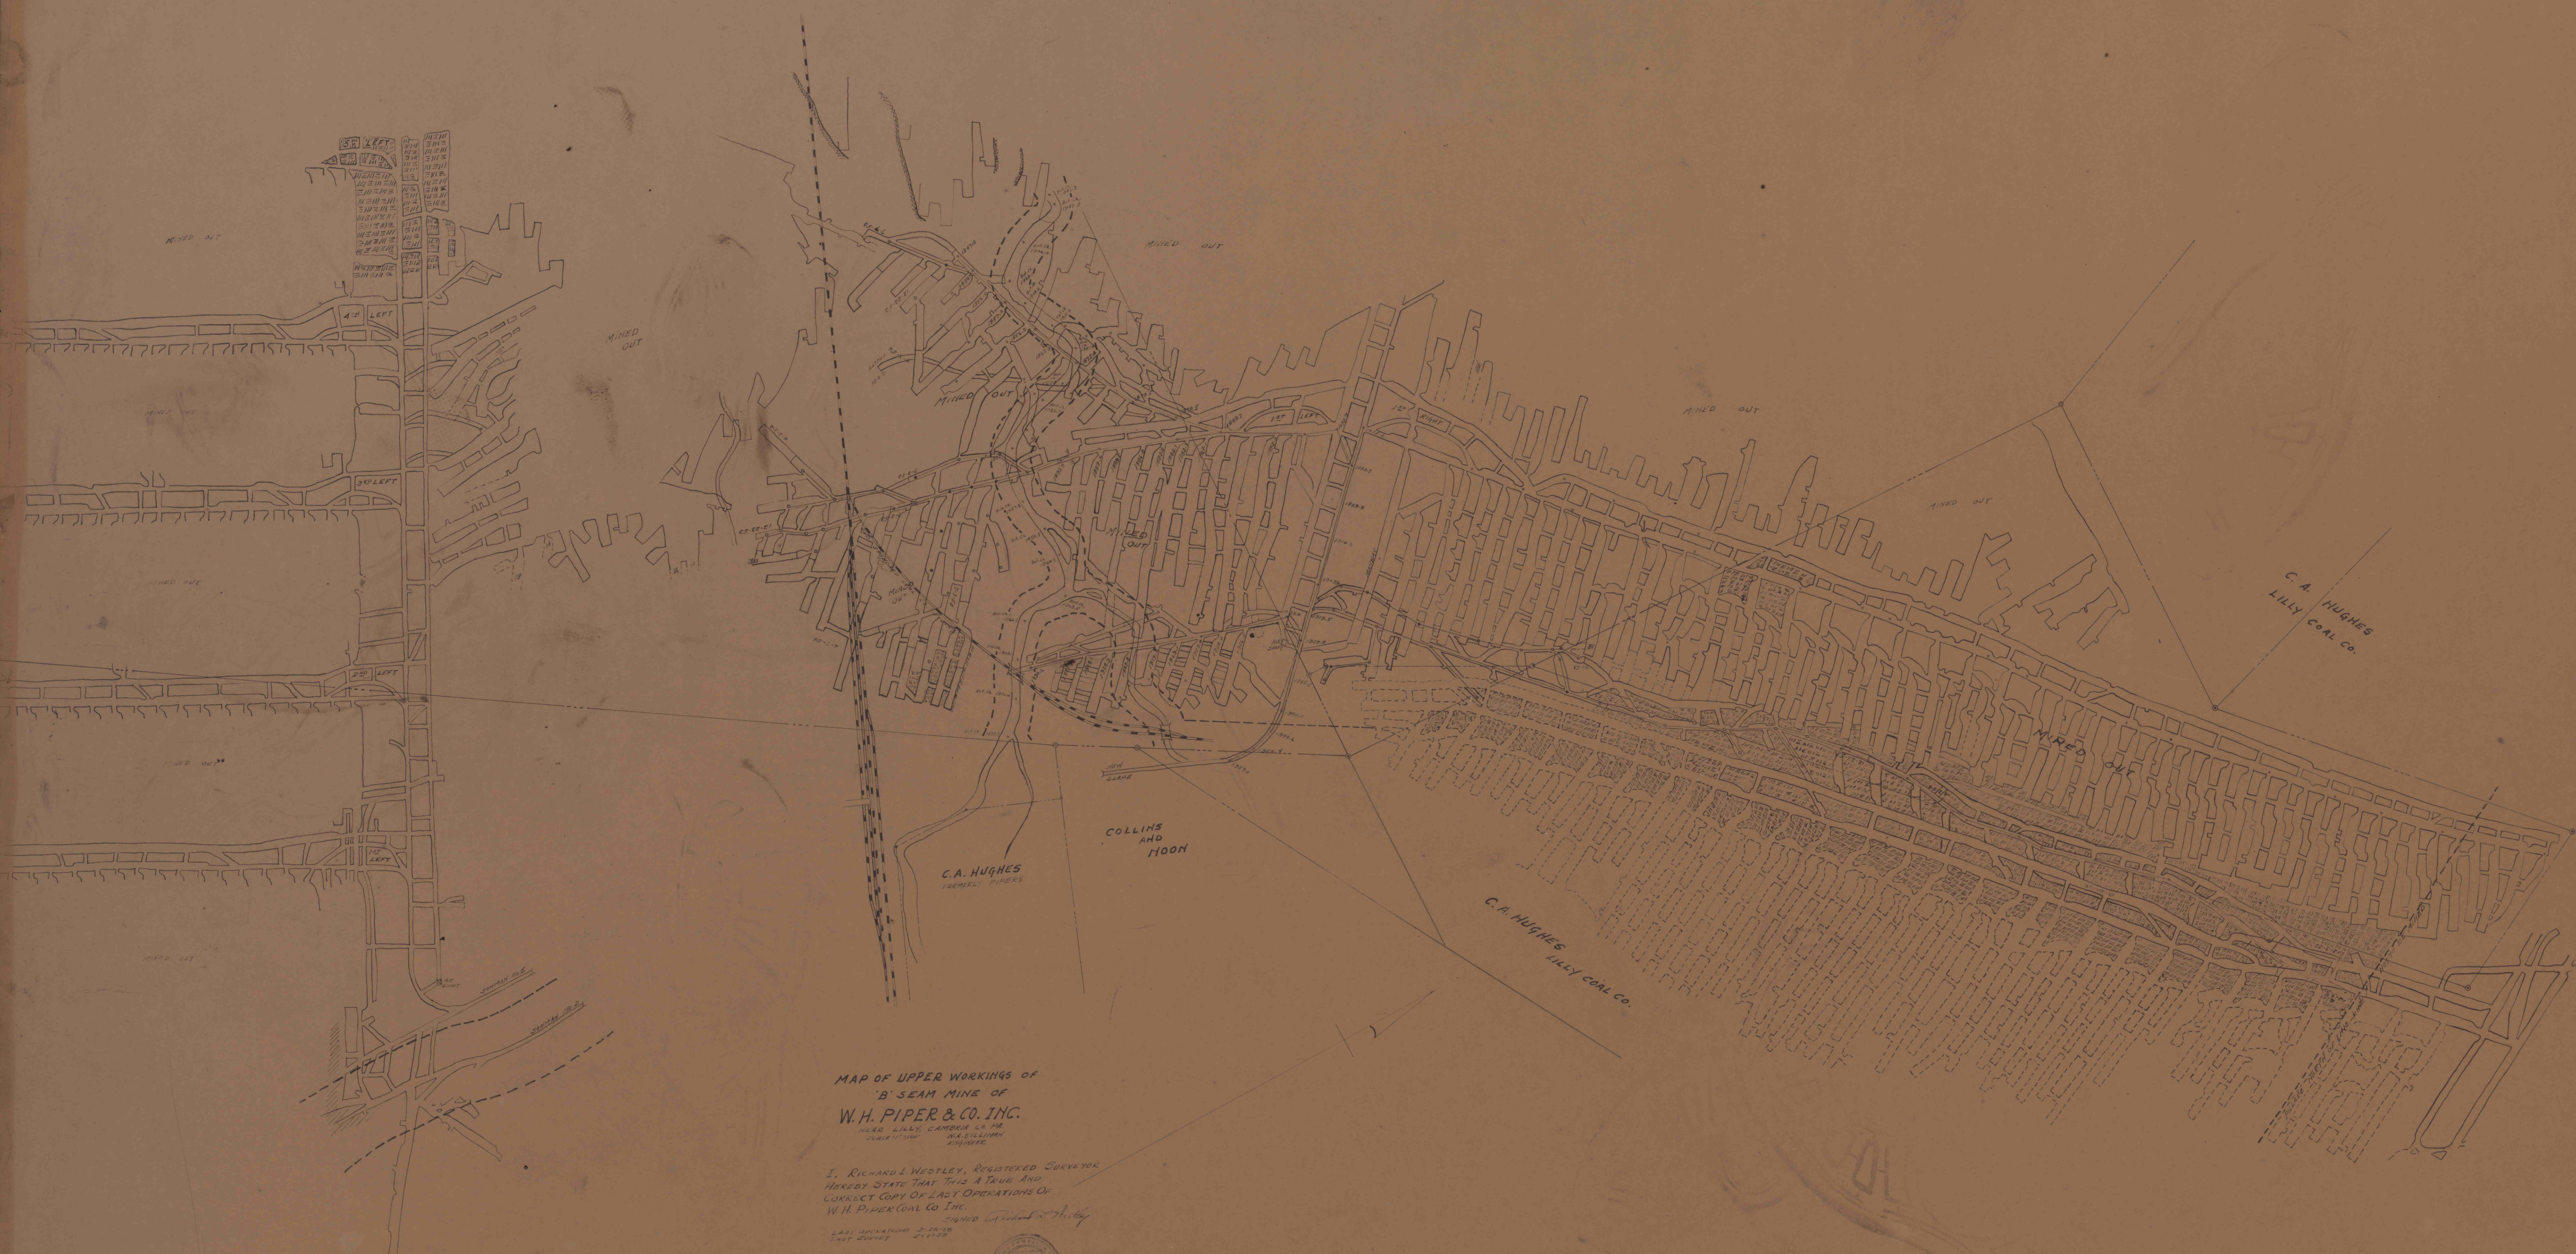