


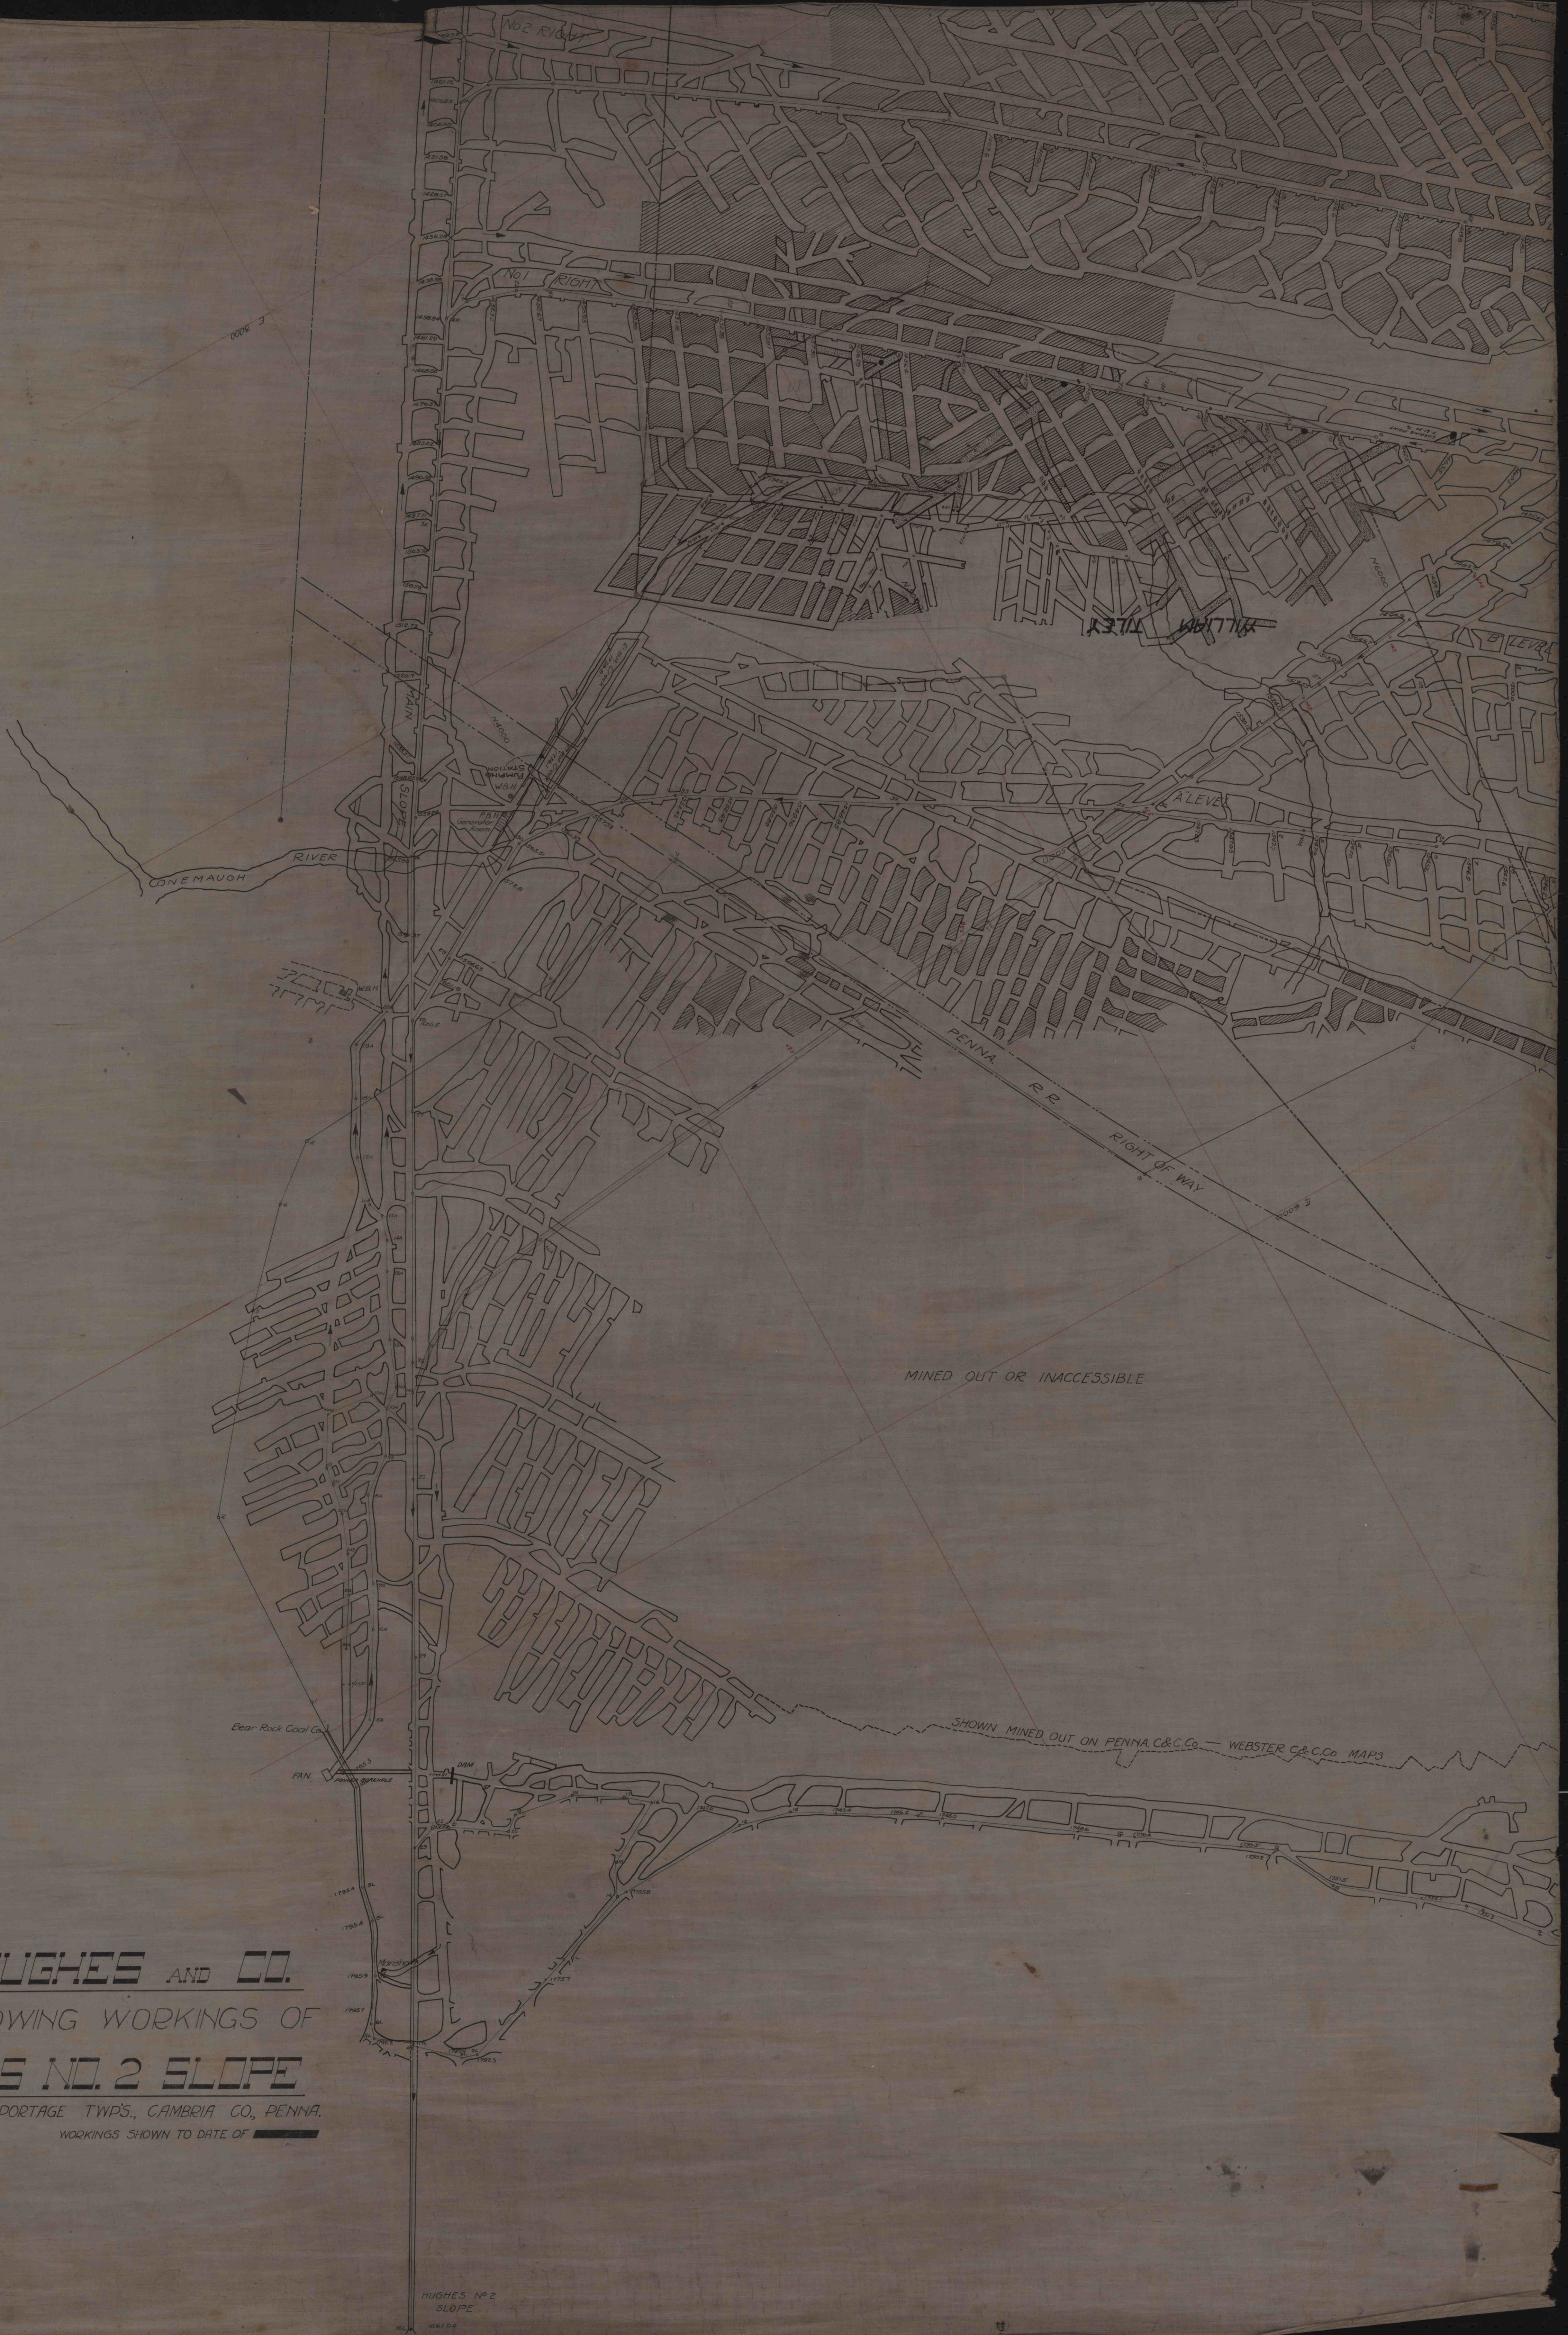

C. A. HUGHES AND CO.

MAP SHOWING WORKINGS OF

HUGHES NO. 2 SLOPE

WASHINGTON AND PORTAGE TWP'S., CAMBRIA CO., PENNA.

SCALE - 1"=100'

WORKINGS SHOWN TO DATE OF