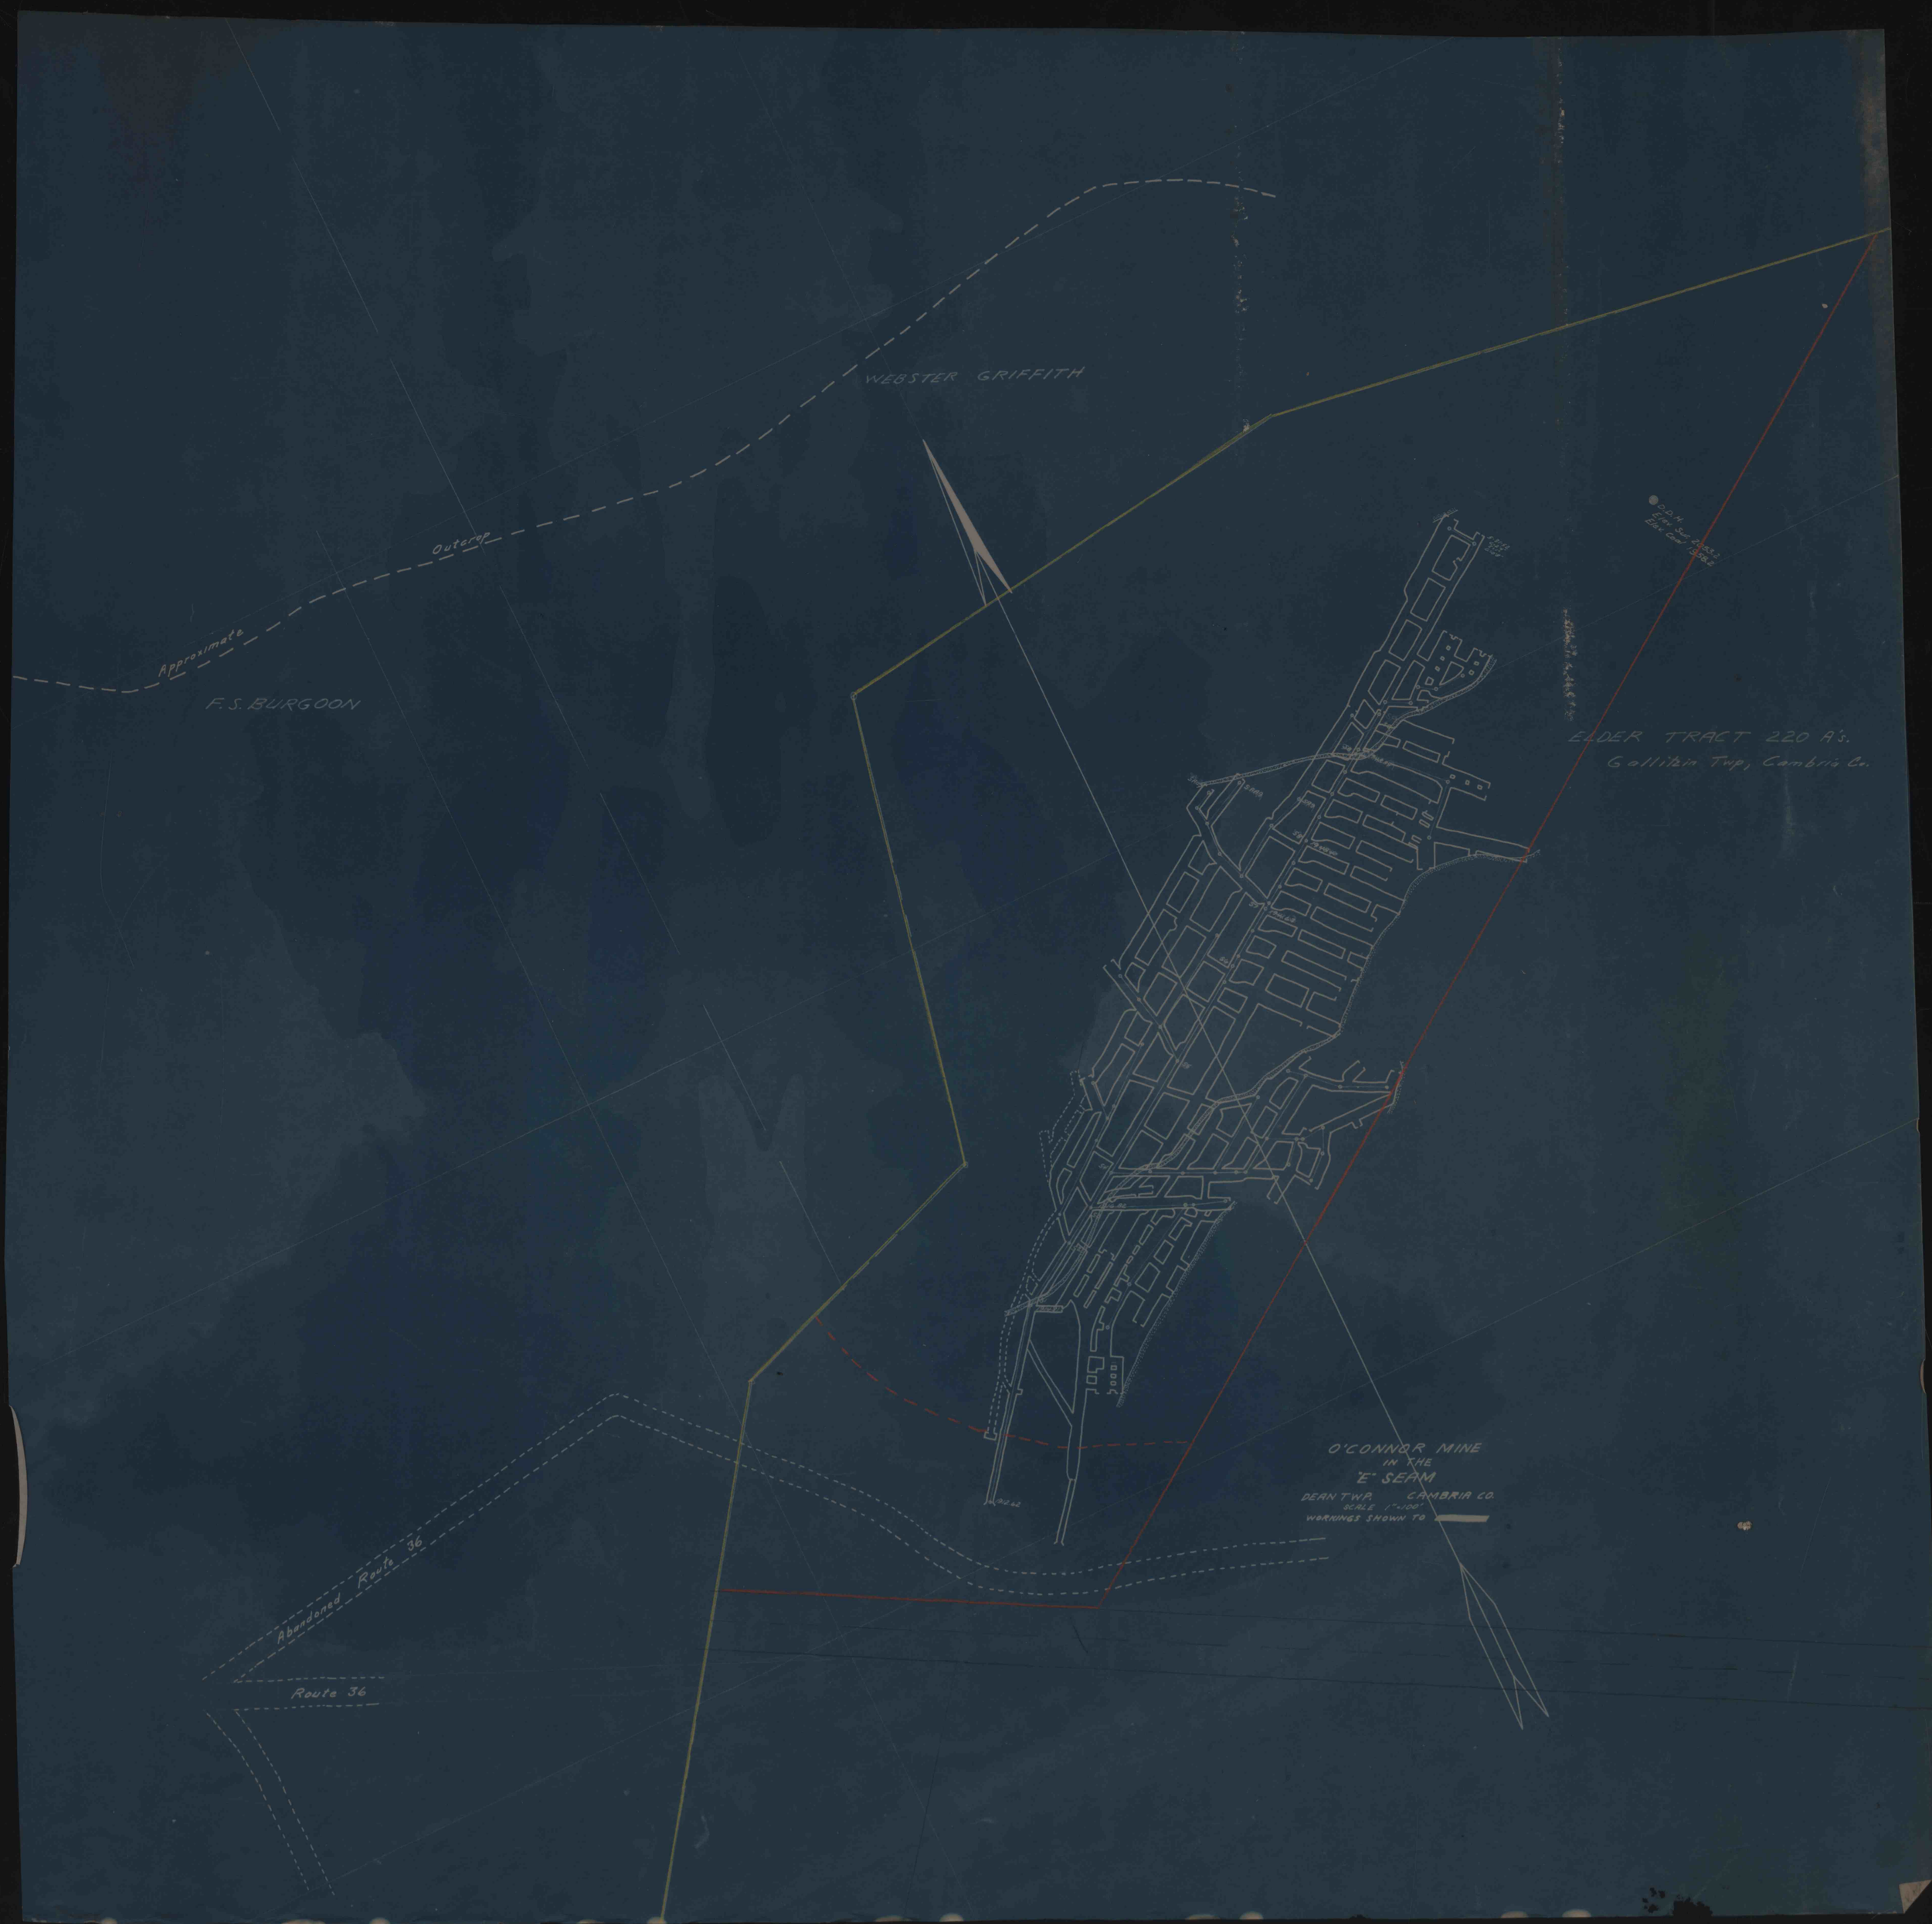
WEBSTER GRIFFITH
Outcrop
Approximate
F. S. BURGOON
ELDER TRACT 220 A's.
Gallitzin Twp, Cambria Co.
O'CONNOR MINE
IN THE
"E" SEAM
DEAN TWP. CAMBRIA CO.
SCALE 1"=100'
WORKINGS SHOWN TO
Abandoned Route 36
Route 36