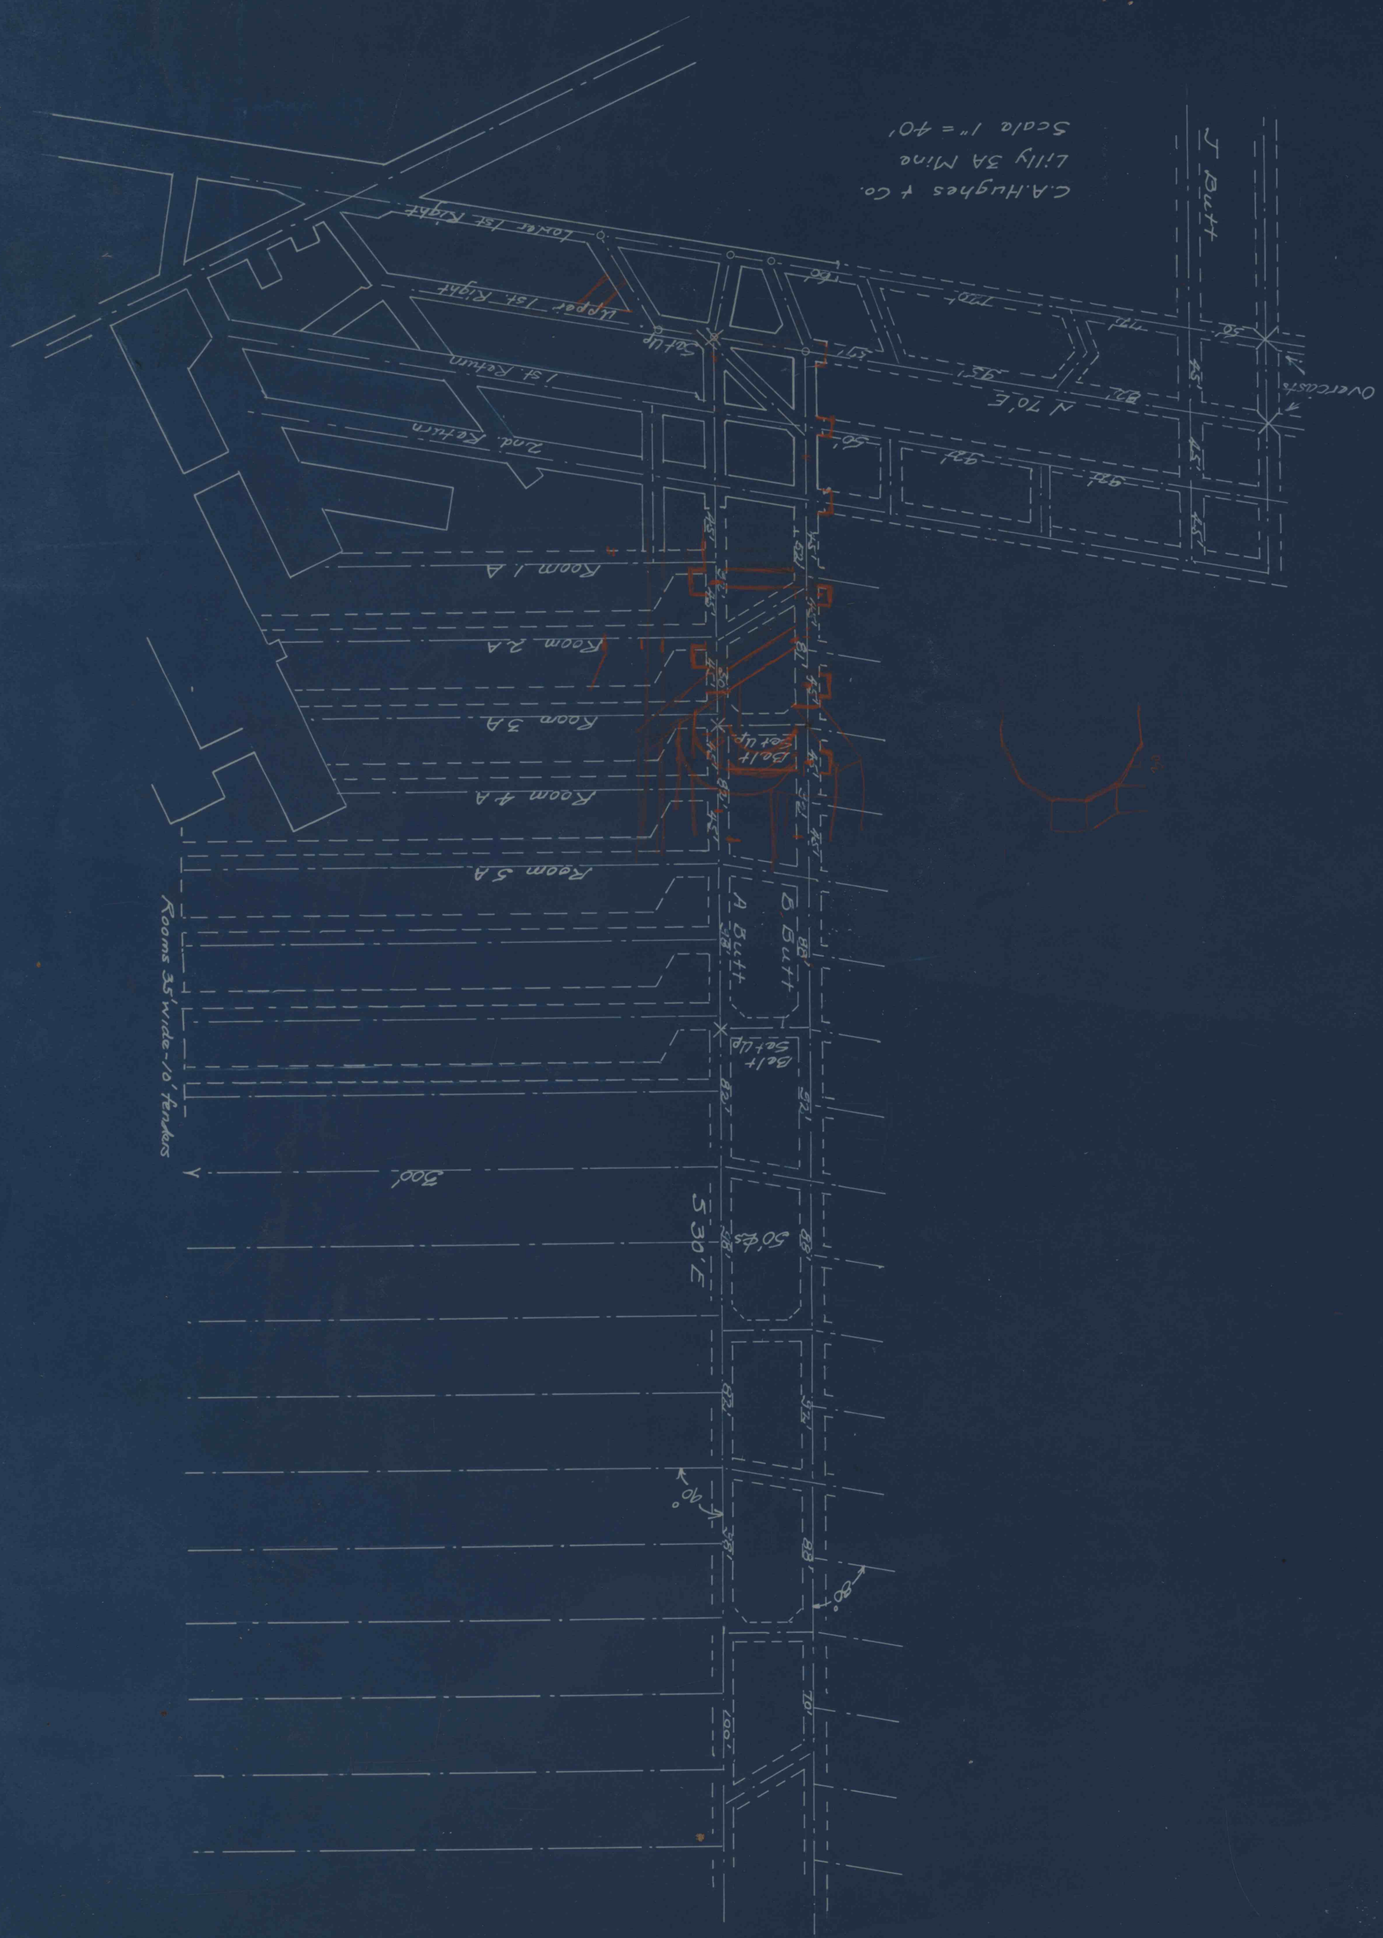
C.A.Hughes & Co.
Lilly 3A Mine
Scale 1" = 40'
J Butt
Overcast
N 70°E
92'
92'
50'
2nd. Return
1st Return
Upper 1st. Right
Lower 1st Right
Rooms 35 wide-10' Pillars
Room 5A
Room 4A
Room 3A
Room 2A
Room 1A
A Butt
B Butt
Bolt Sol Up
S 30°E
300'
50' Ess
90°
90°