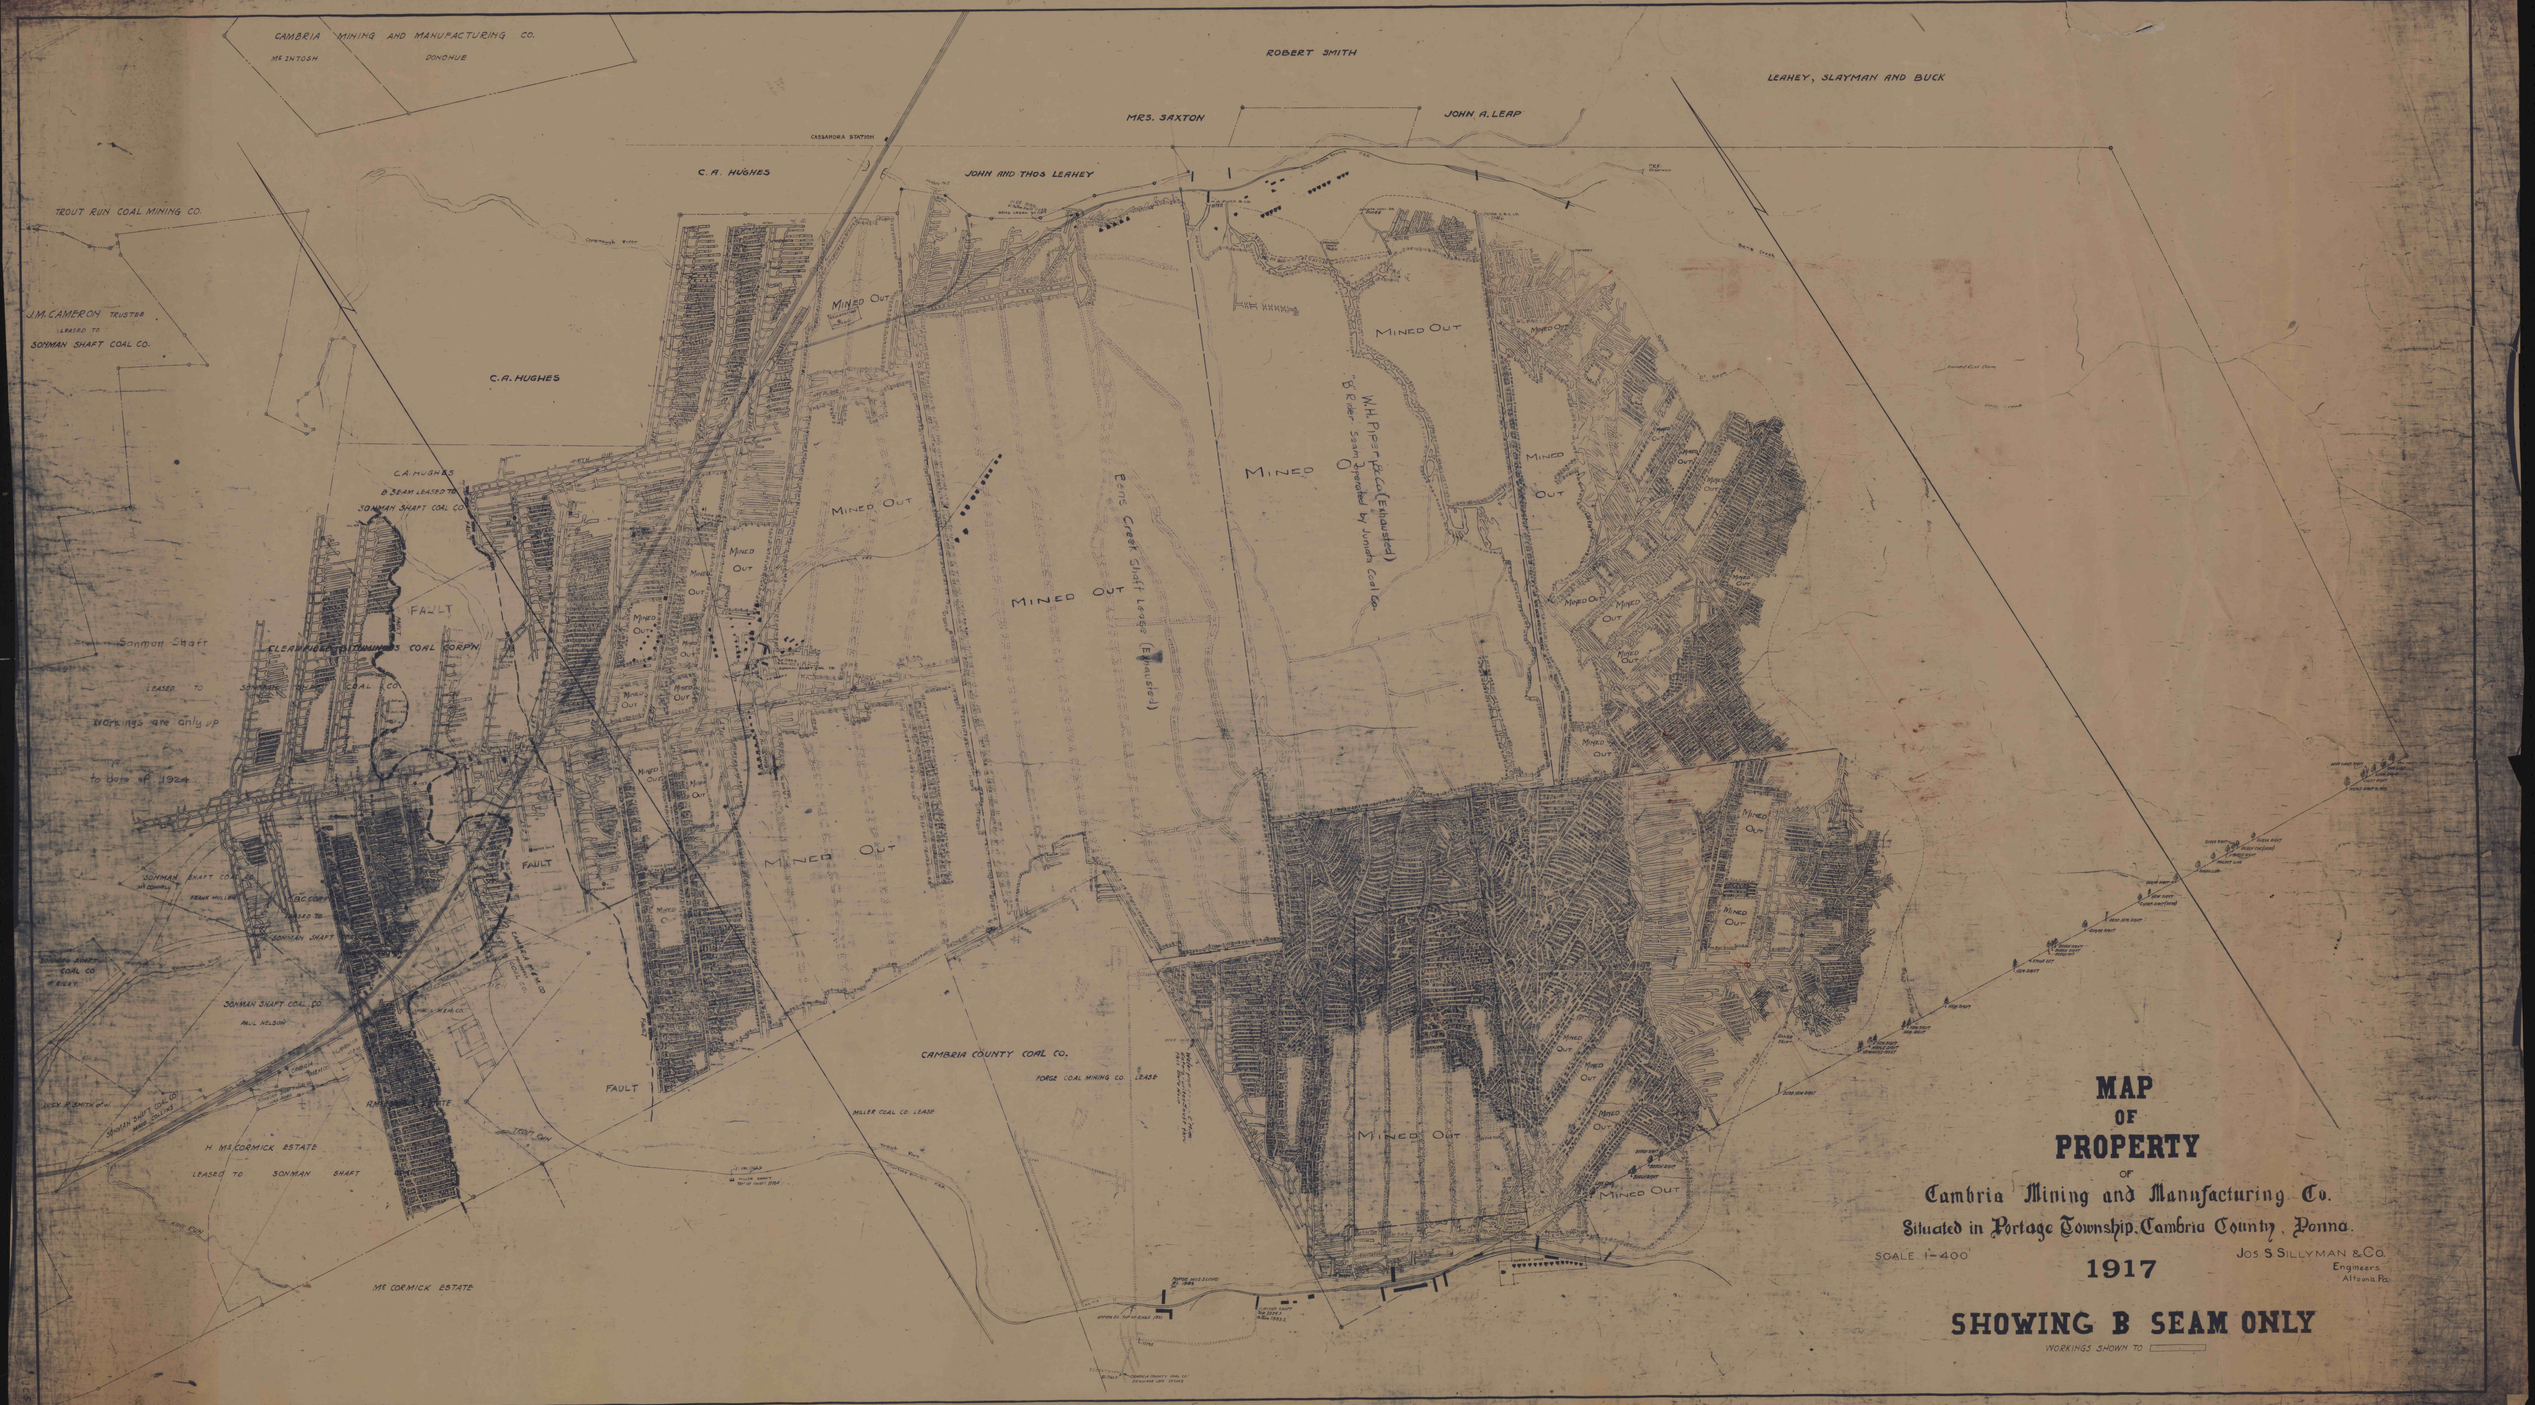
CAMBRIA MINING AND MANUFACTURING CO.
MCINTOSH
DONOHUE
ROBERT SMITH
LEAHEY, SLAYMAN AND BUCK
MRS. SAXTON
JOHN A. LEAP
CASSANDRA STATION
C. A. HUGHES
JOHN AND THOS. LEAHEY
TROUT RUN COAL MINING CO.
J.M. CAMERON TRUSTEE
LEASED TO
SONMAN SHAFT COAL CO.
C.A. HUGHES
C.A. HUGHES
B SEAM LEASED TO
SONMAN SHAFT COAL CO.
MINED OUT
FAULT
Sonman Shaft
LEASED TO
SONMAN SHAFT COAL CO.
Workings are only up
to date of 1924
Bens Creek Shaft Lease (Exhausted)
W.H. Piper Lease (Exhausted)
"B" Rider Seam Operated by Juniata Coal Co.
SONMAN SHAFT COAL CO.
PAUL NELSON
CAMBRIA COUNTY COAL CO.
FORGE COAL MINING CO. LEASE
MILLER COAL CO. LEASE
H. McCORMICK ESTATE
LEASED TO SONMAN SHAFT
McCORMICK ESTATE
MAP
OF
PROPERTY
OF
Cambria Mining and Manufacturing Co.
Situated in Portage Township, Cambria County, Penna.
SCALE 1"=400'
1917
JOS S SILLYMAN & CO.
Engineers
Altoona Pa.
SHOWING B SEAM ONLY
WORKINGS SHOWN TO