


23074
M 62 824
172507

ADAM EDGAR
11237 A. TOTAL AREA

Sketch showing
Butt joints Right & Left off 25.4 F.A.E.
Scale 1:50 Aug 1948

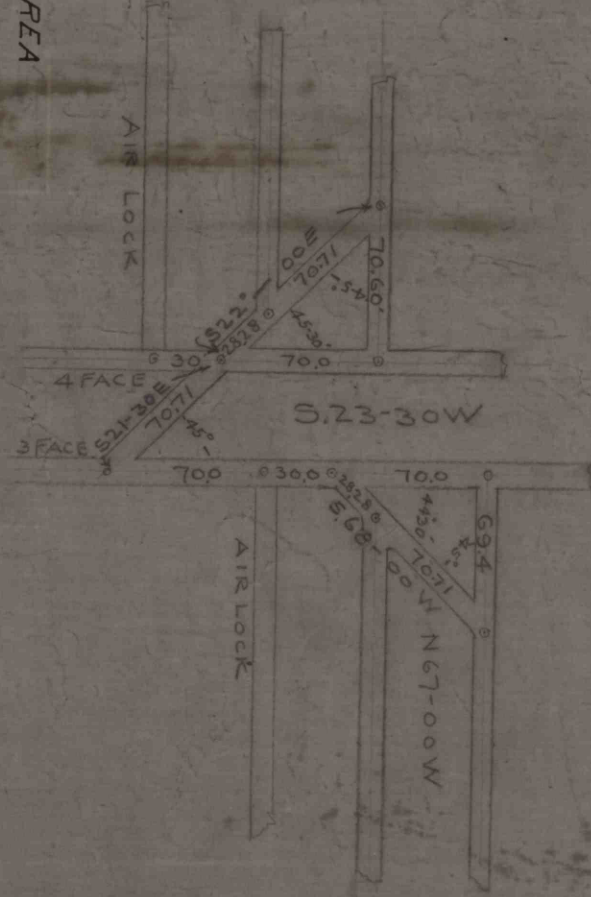

WILLIAM E. MOORE.
100 A.

BOUNDARY

2.5592 N 65° 31' W
DISTANCE 1.033

MINNIE M. AND S. ELLA
P. McCONNELL
55A.184P. TOTAL AREA

DAVID McCONNELL
142A.143P. TOTAL AREA

BOUNDARY

LINE

BOUNDARY

LINE

