

FIT TO H-5426 D-33

FIT TO H-5425 D-33


H-5292

FIT TO 5283

FIT TO 5291

FIT TO 5293

JOHN EDGAR

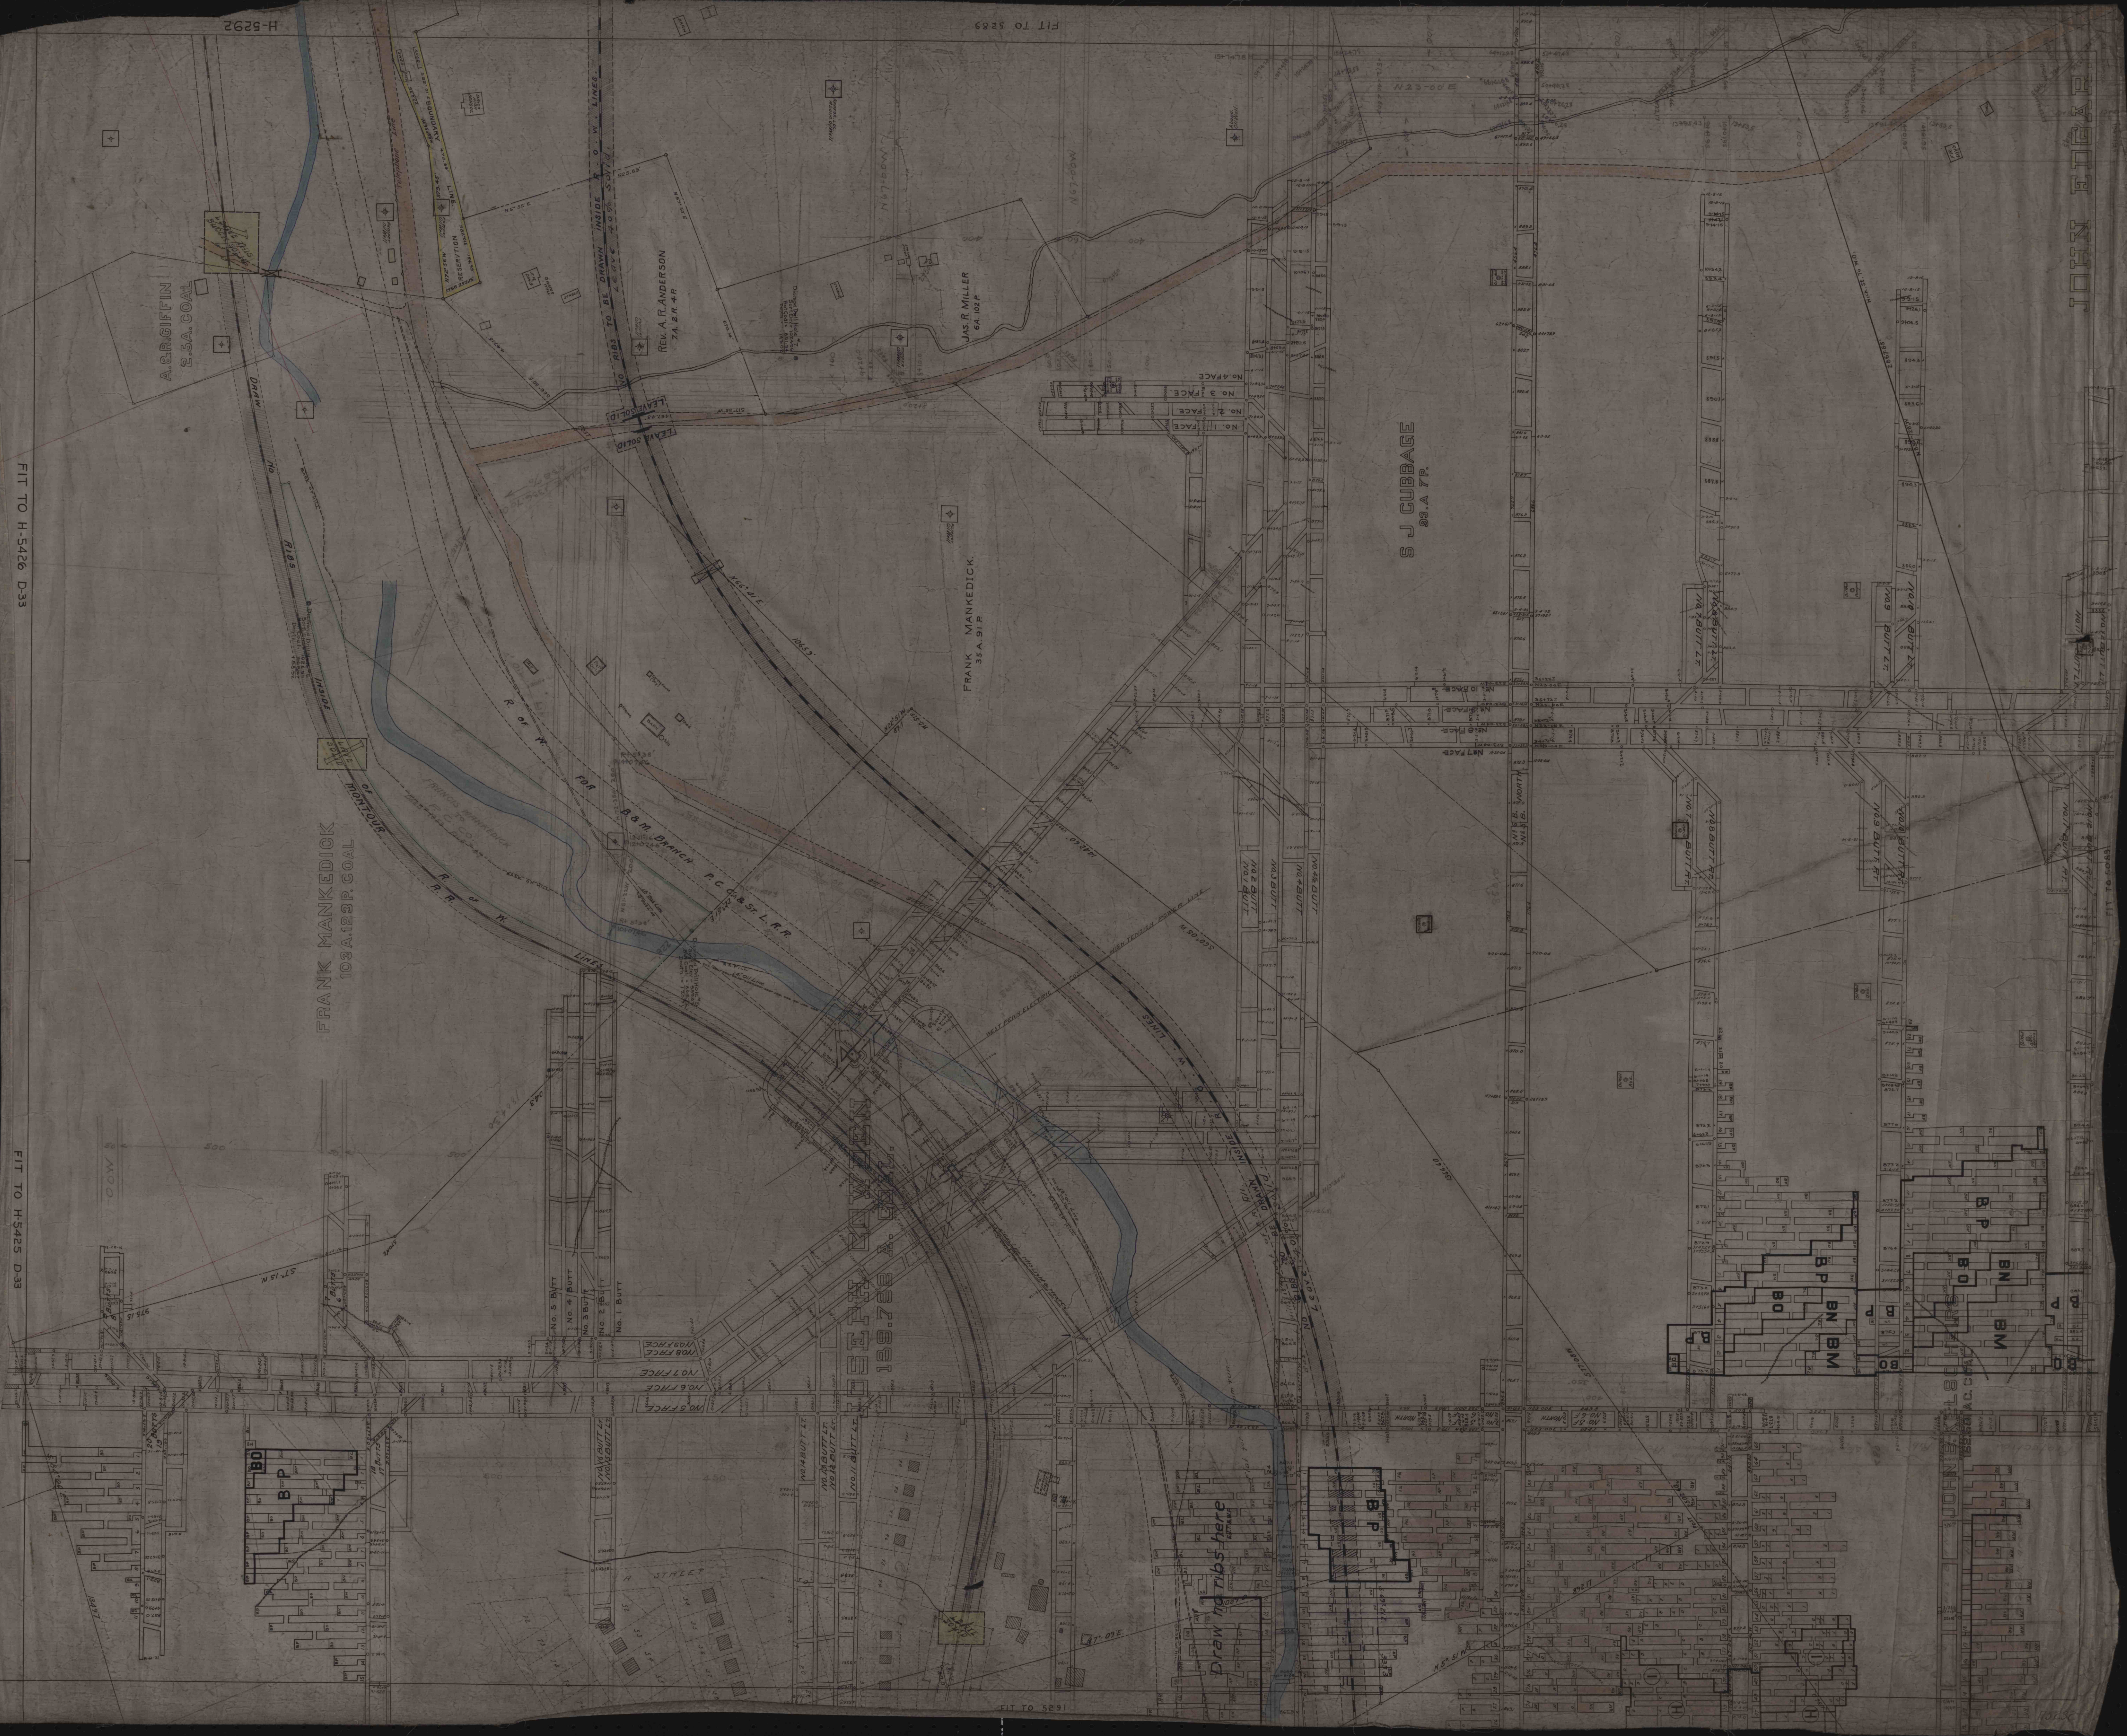

AEROFFIN
25A. COAL

FRANK MANKEDICK
103A123P. COAL

REV. A. R. ANDERSON
7A. 4R

FRANK MANKEDICK
33A 91P

S J CUBBAGE
33A 7P.

JOHN EDGAR
103A123P. COAL

Draw ribs here

JOHN EDGAR
103A123P. COAL