


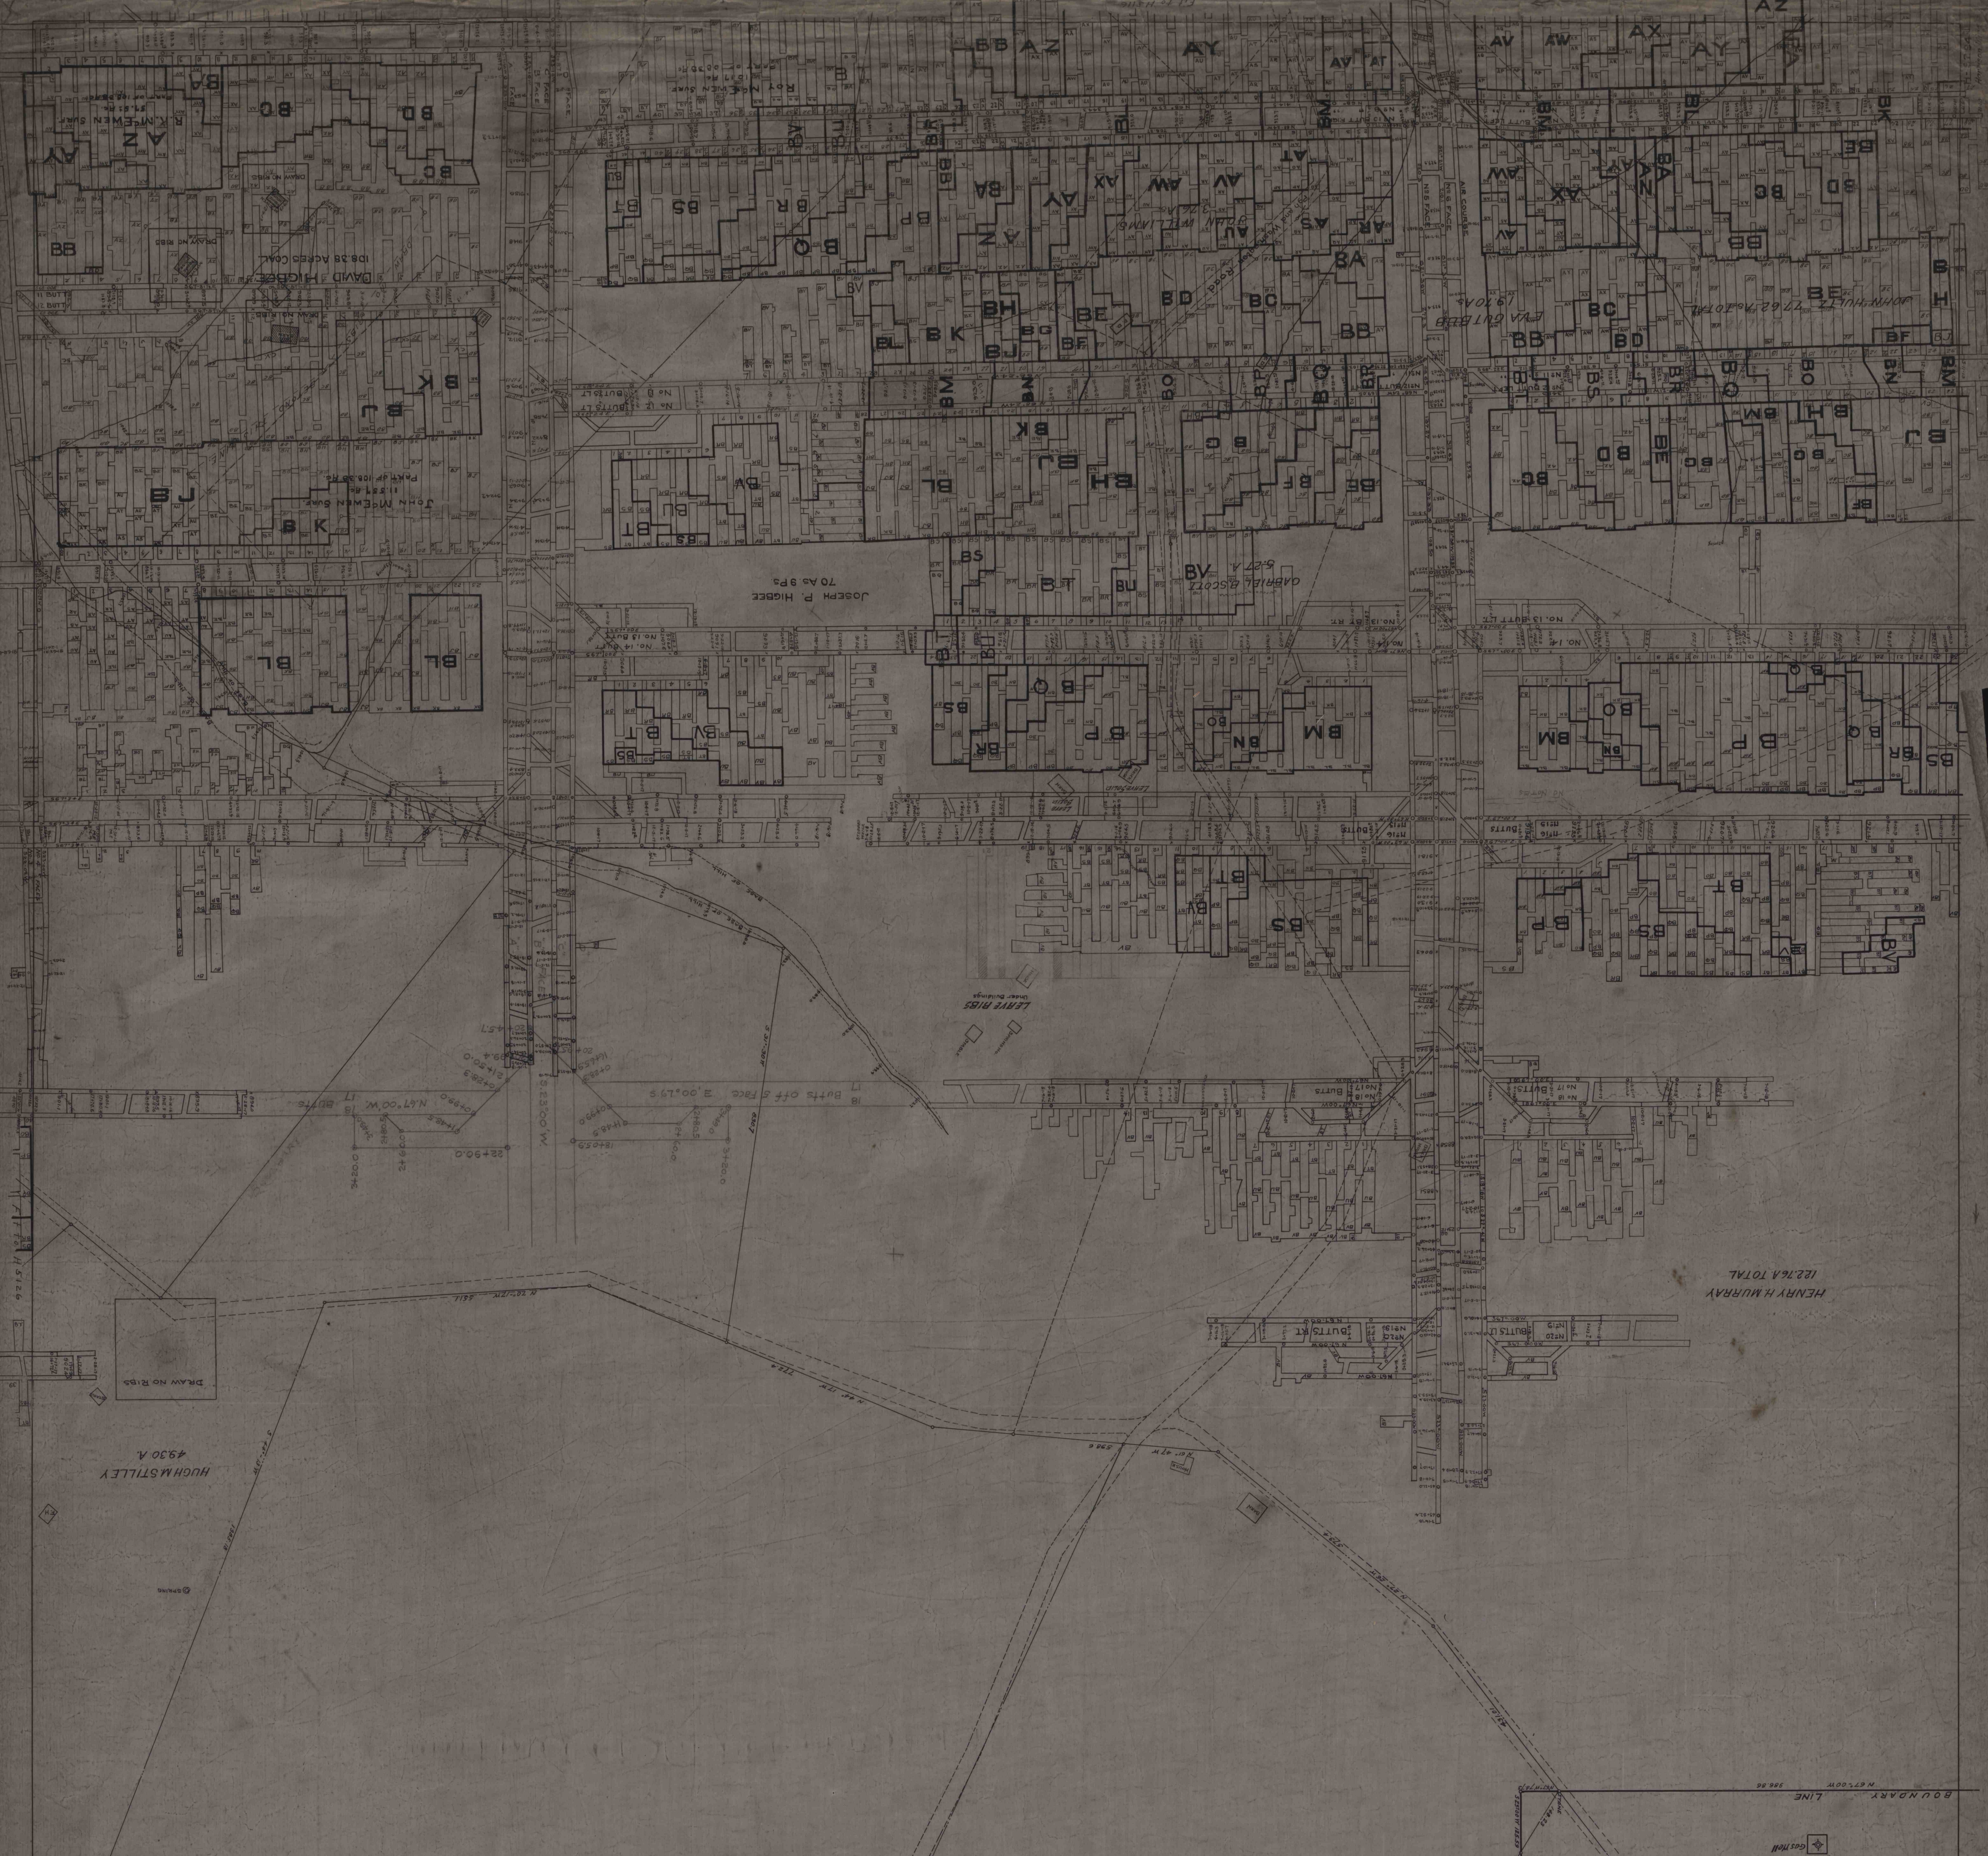

GEO. C. BECKER
48.28 A.

JOHN GILFILLAN
158.281 A.

DIVISION LINE
BRIDGEVILLE MINE
HARRISON MINE

BOUNDARY LINE

BOUNDARY LINE

HENRY H. MURRAY
122.76 A. TOTAL

HUGHSTILLEY
49.30 A.

LEWIS RIBS

JOSEPH P. HIGGINS
70 A. 3 P.

DAVID McMEIN GARDEN

JOHN McMEIN GARDEN

LEWIS RIBS

LEWIS RIBS

