


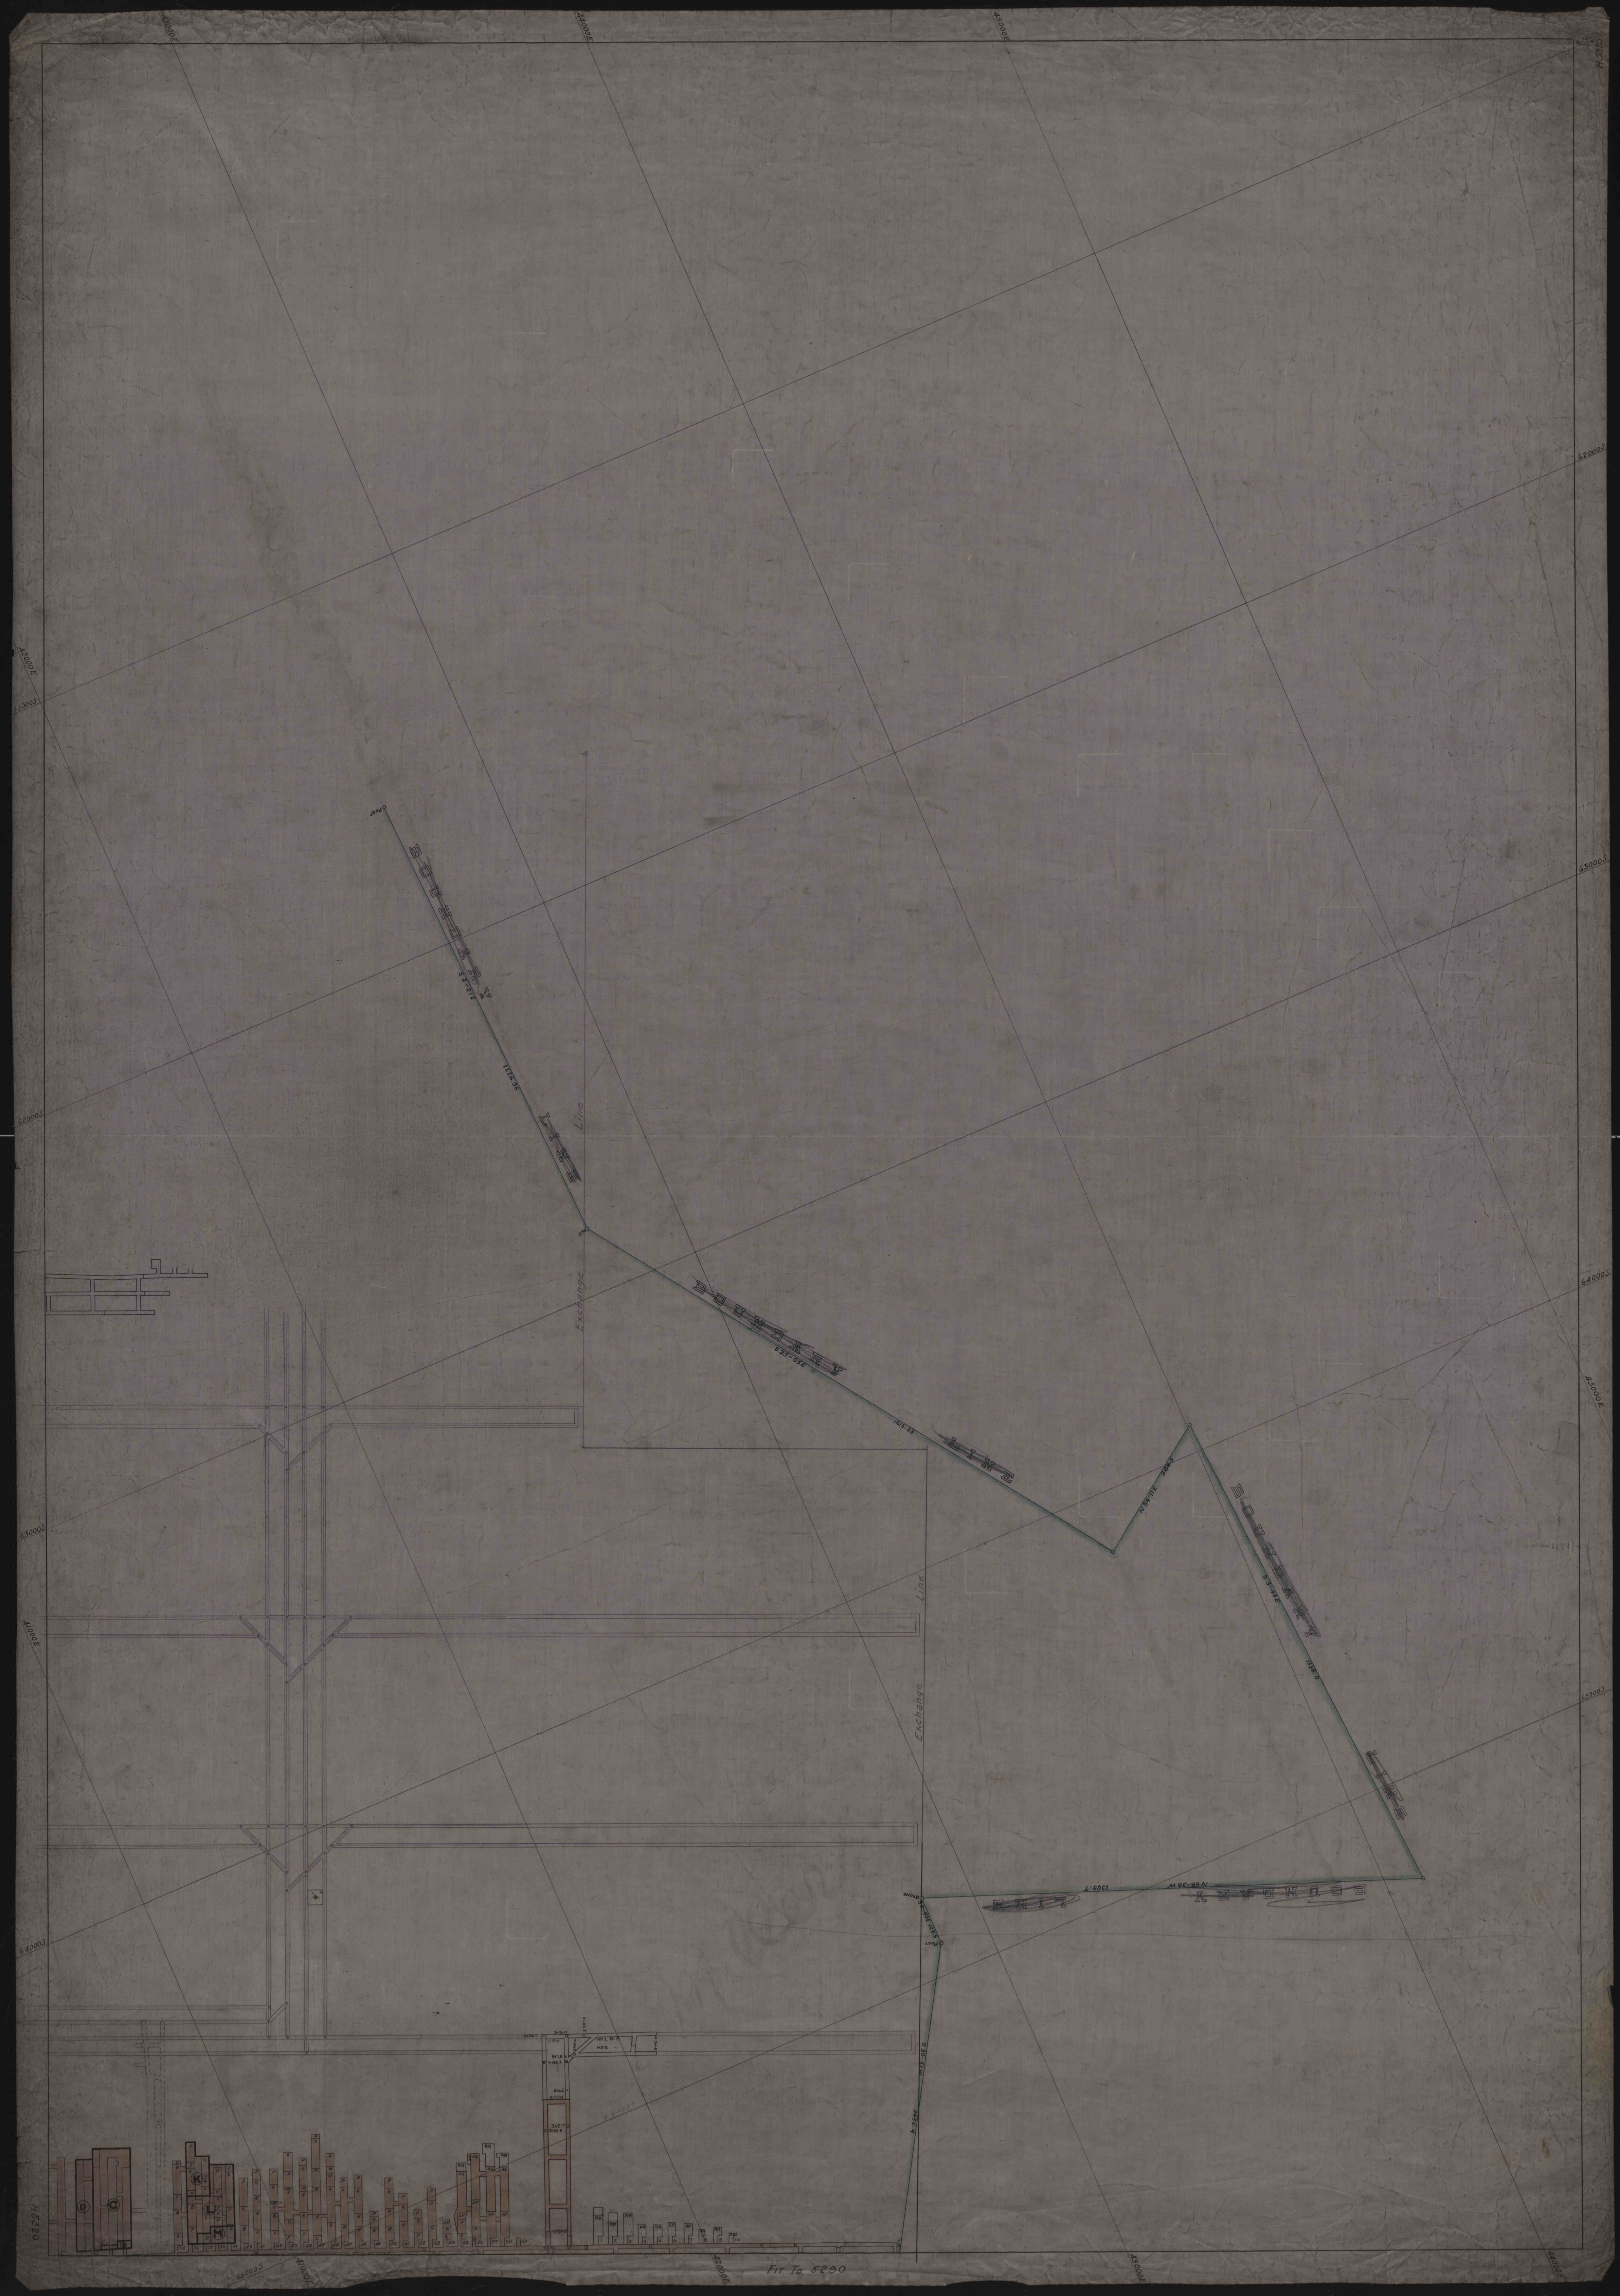

13903

640003

630003

640003

640003

450003

450003

640003

630003

640003

630003

640003

Fit To 5290