


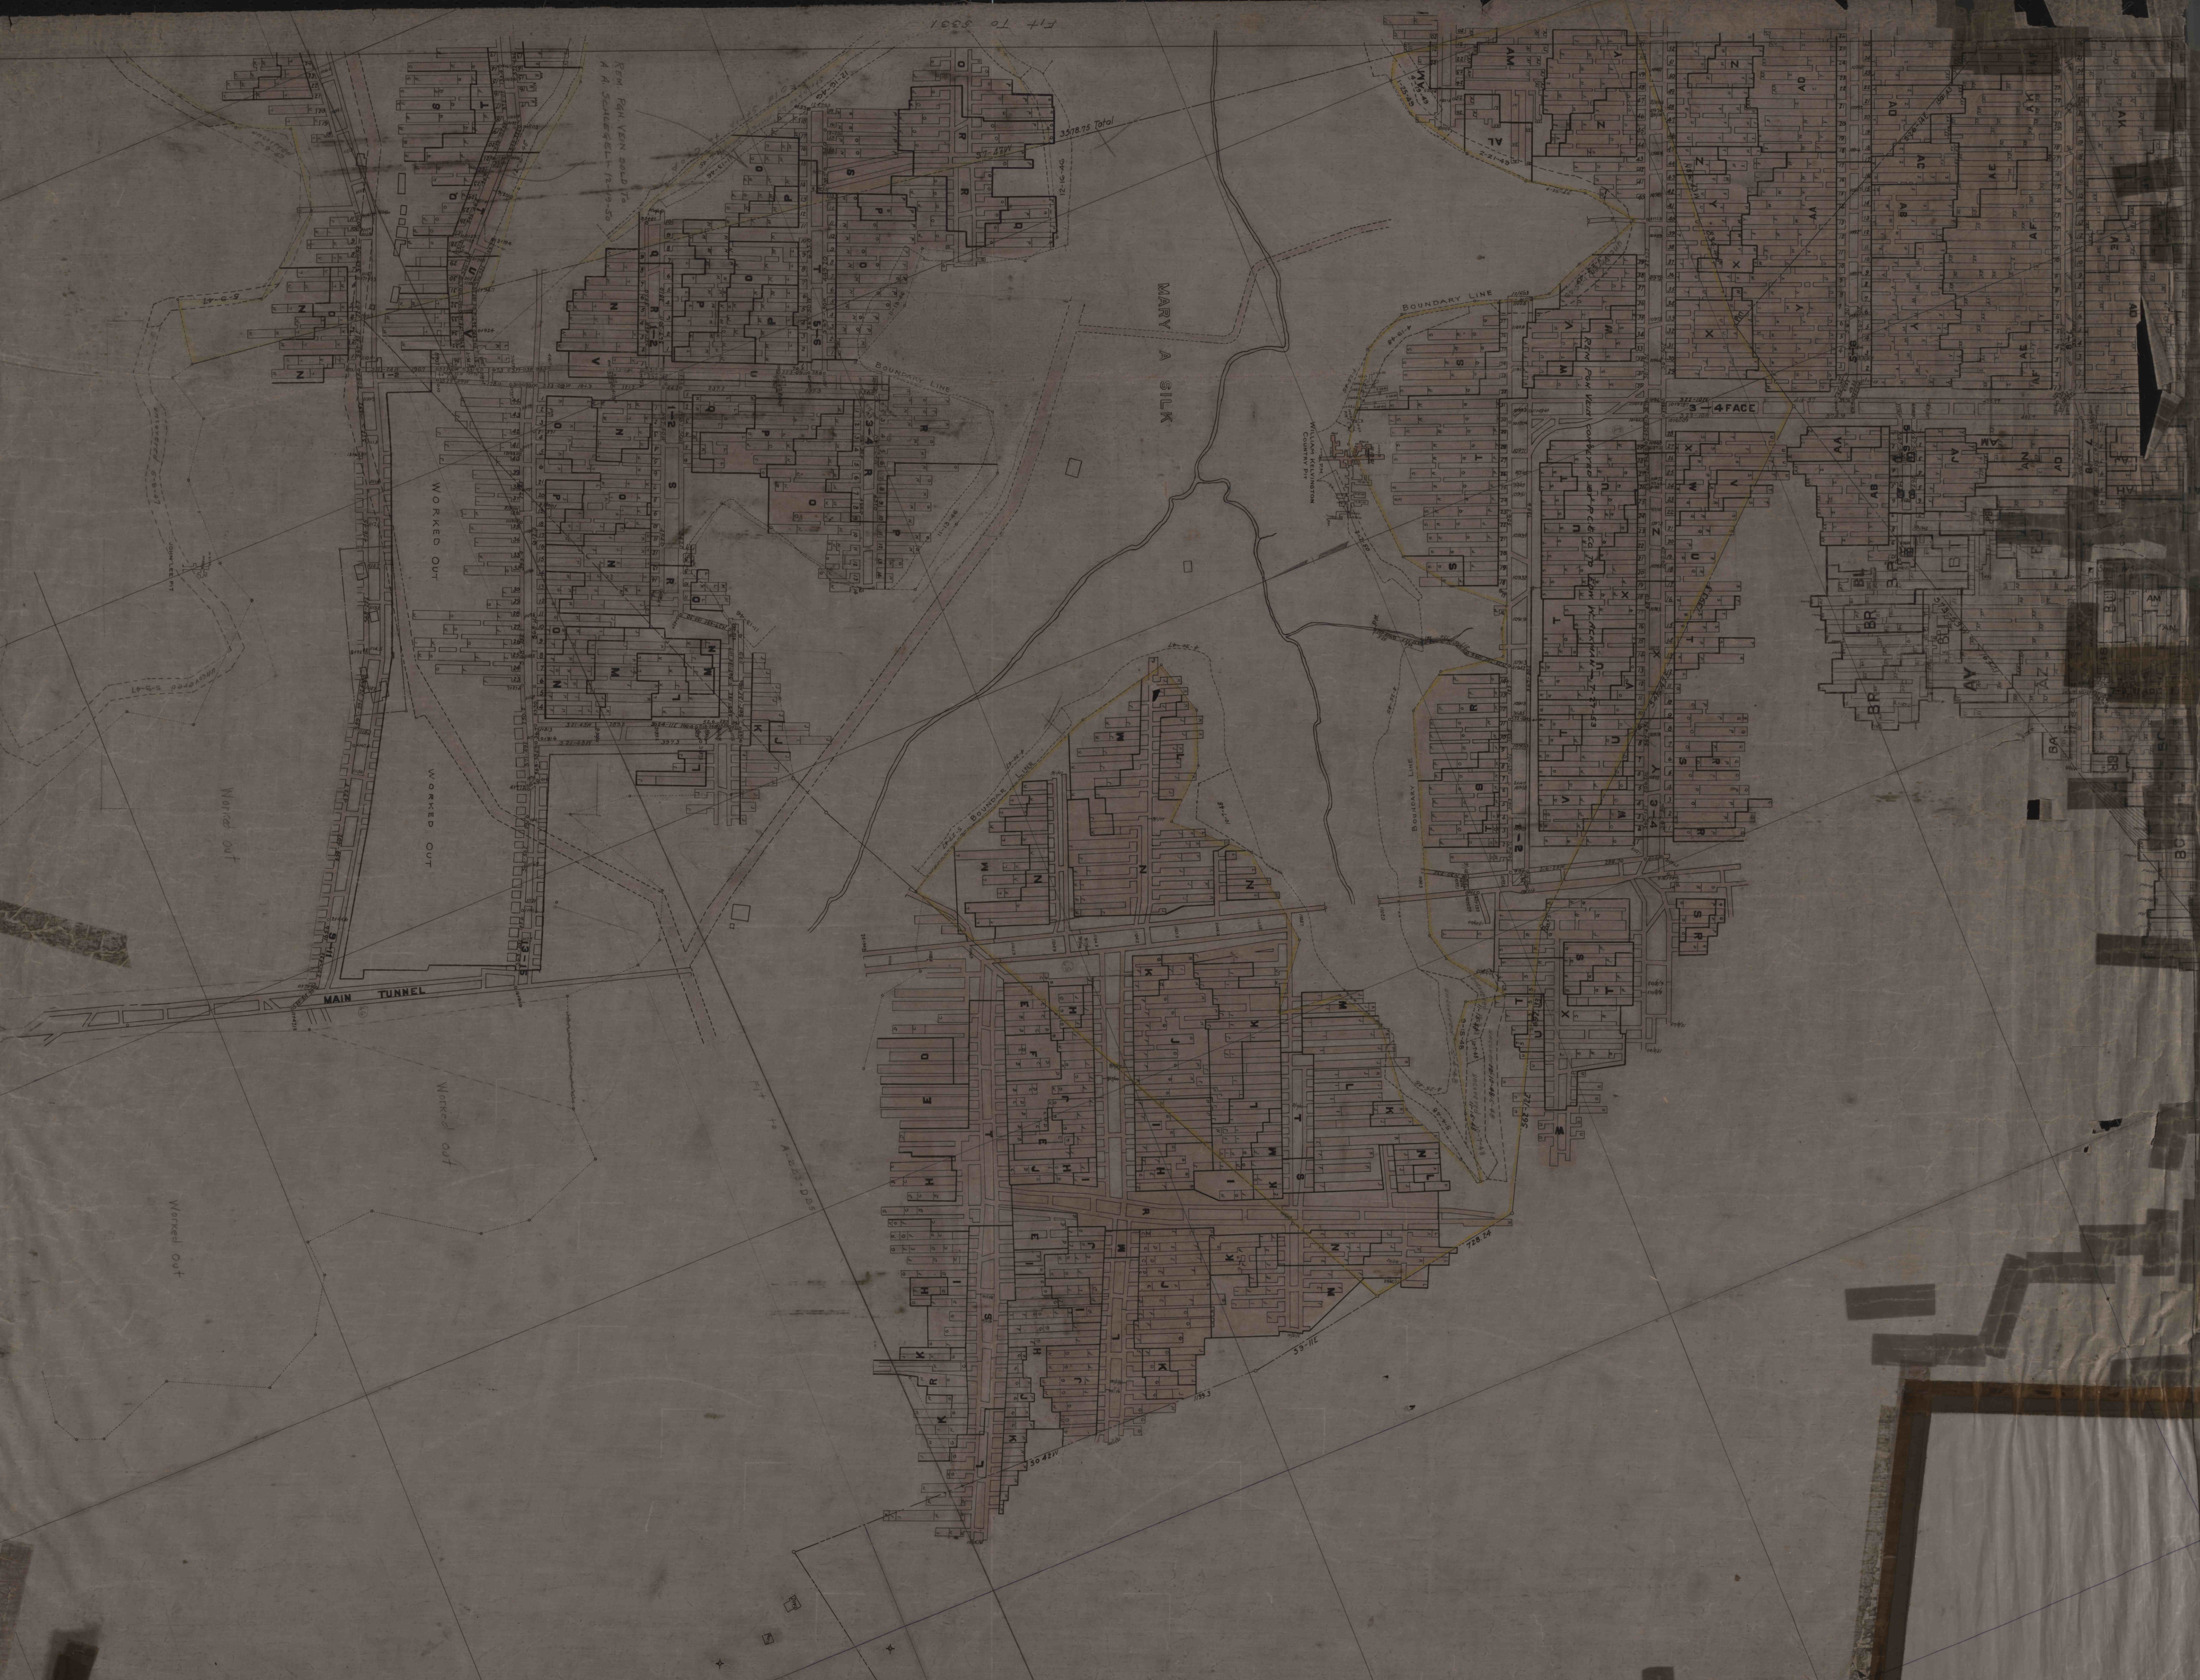

H-5332

H-5332