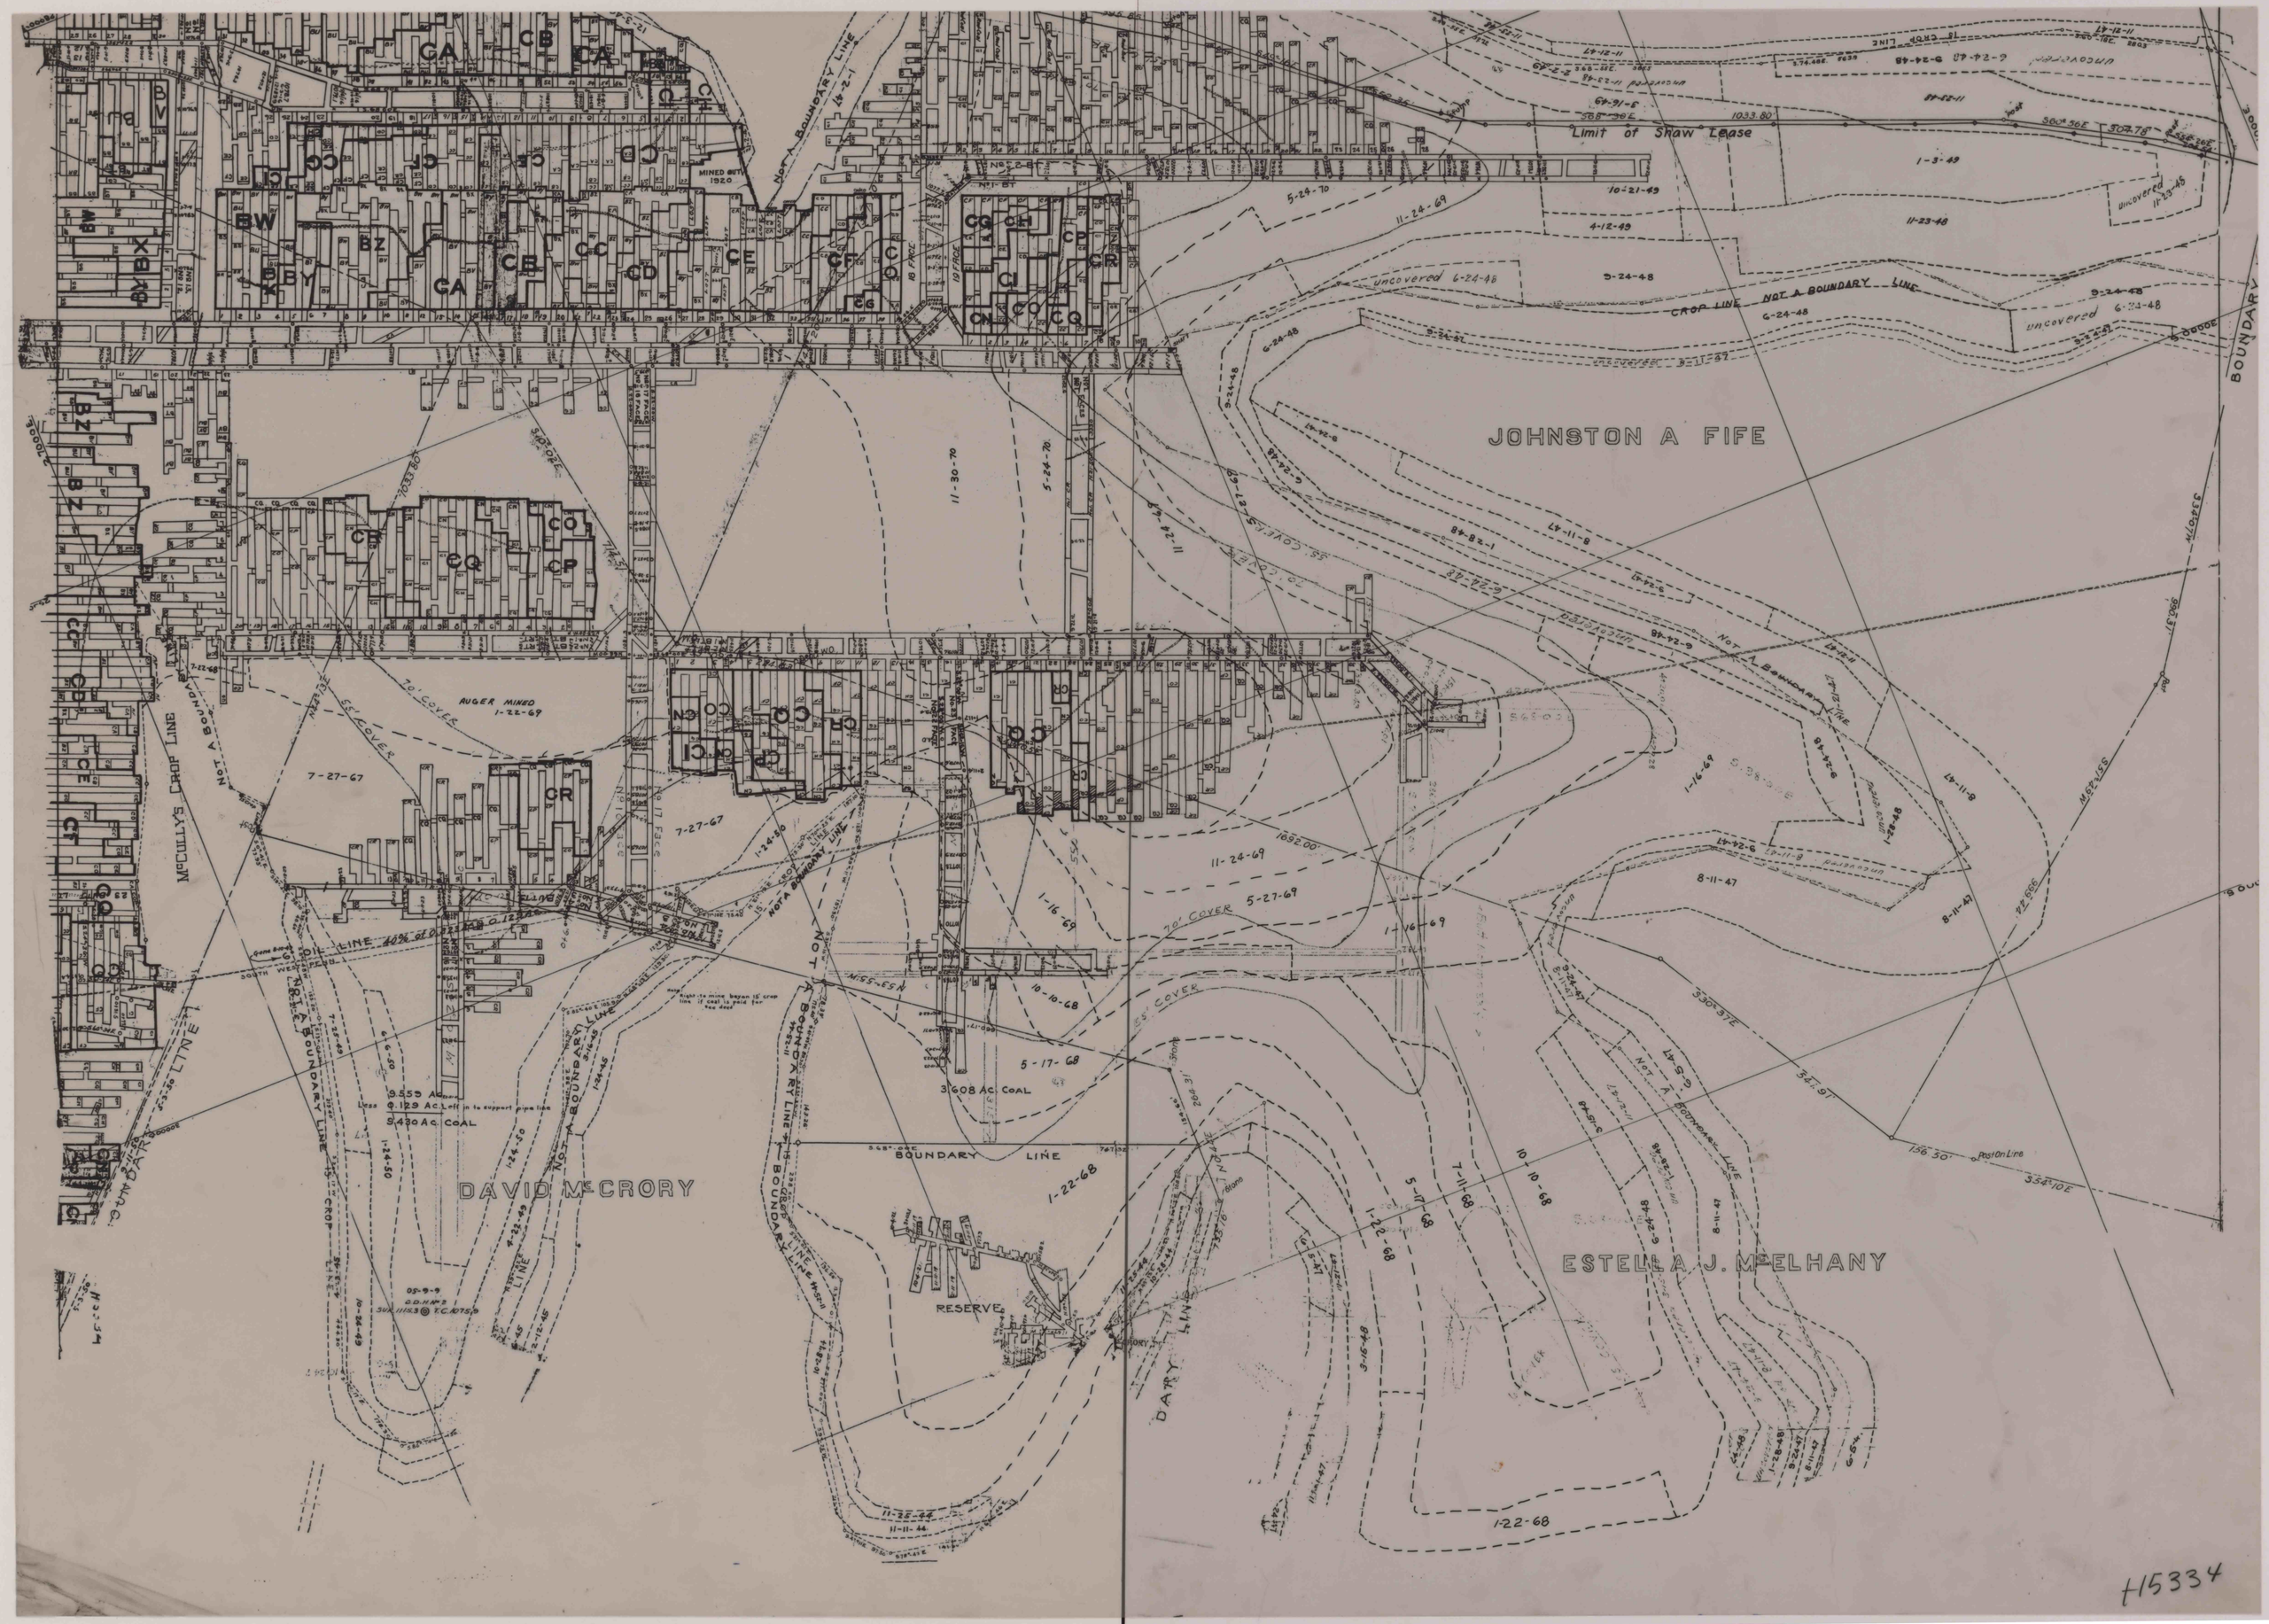
JOHNSTON A FIFE
DAVID McCRORY
ESTELLA J. McELHANY
"Limit of Shaw" Lease
NOT A BOUNDARY LINE
McCULLY'S CROP LINE
BOUNDARY LINE
RESERVE
3.608 Ac. Coal
9.430 Ac. Coal
MINED OUT 1920
AUGER MINED 1-22-69
70' COVER
55' COVER
uncovered 6-24-48
uncovered 11-23-48
