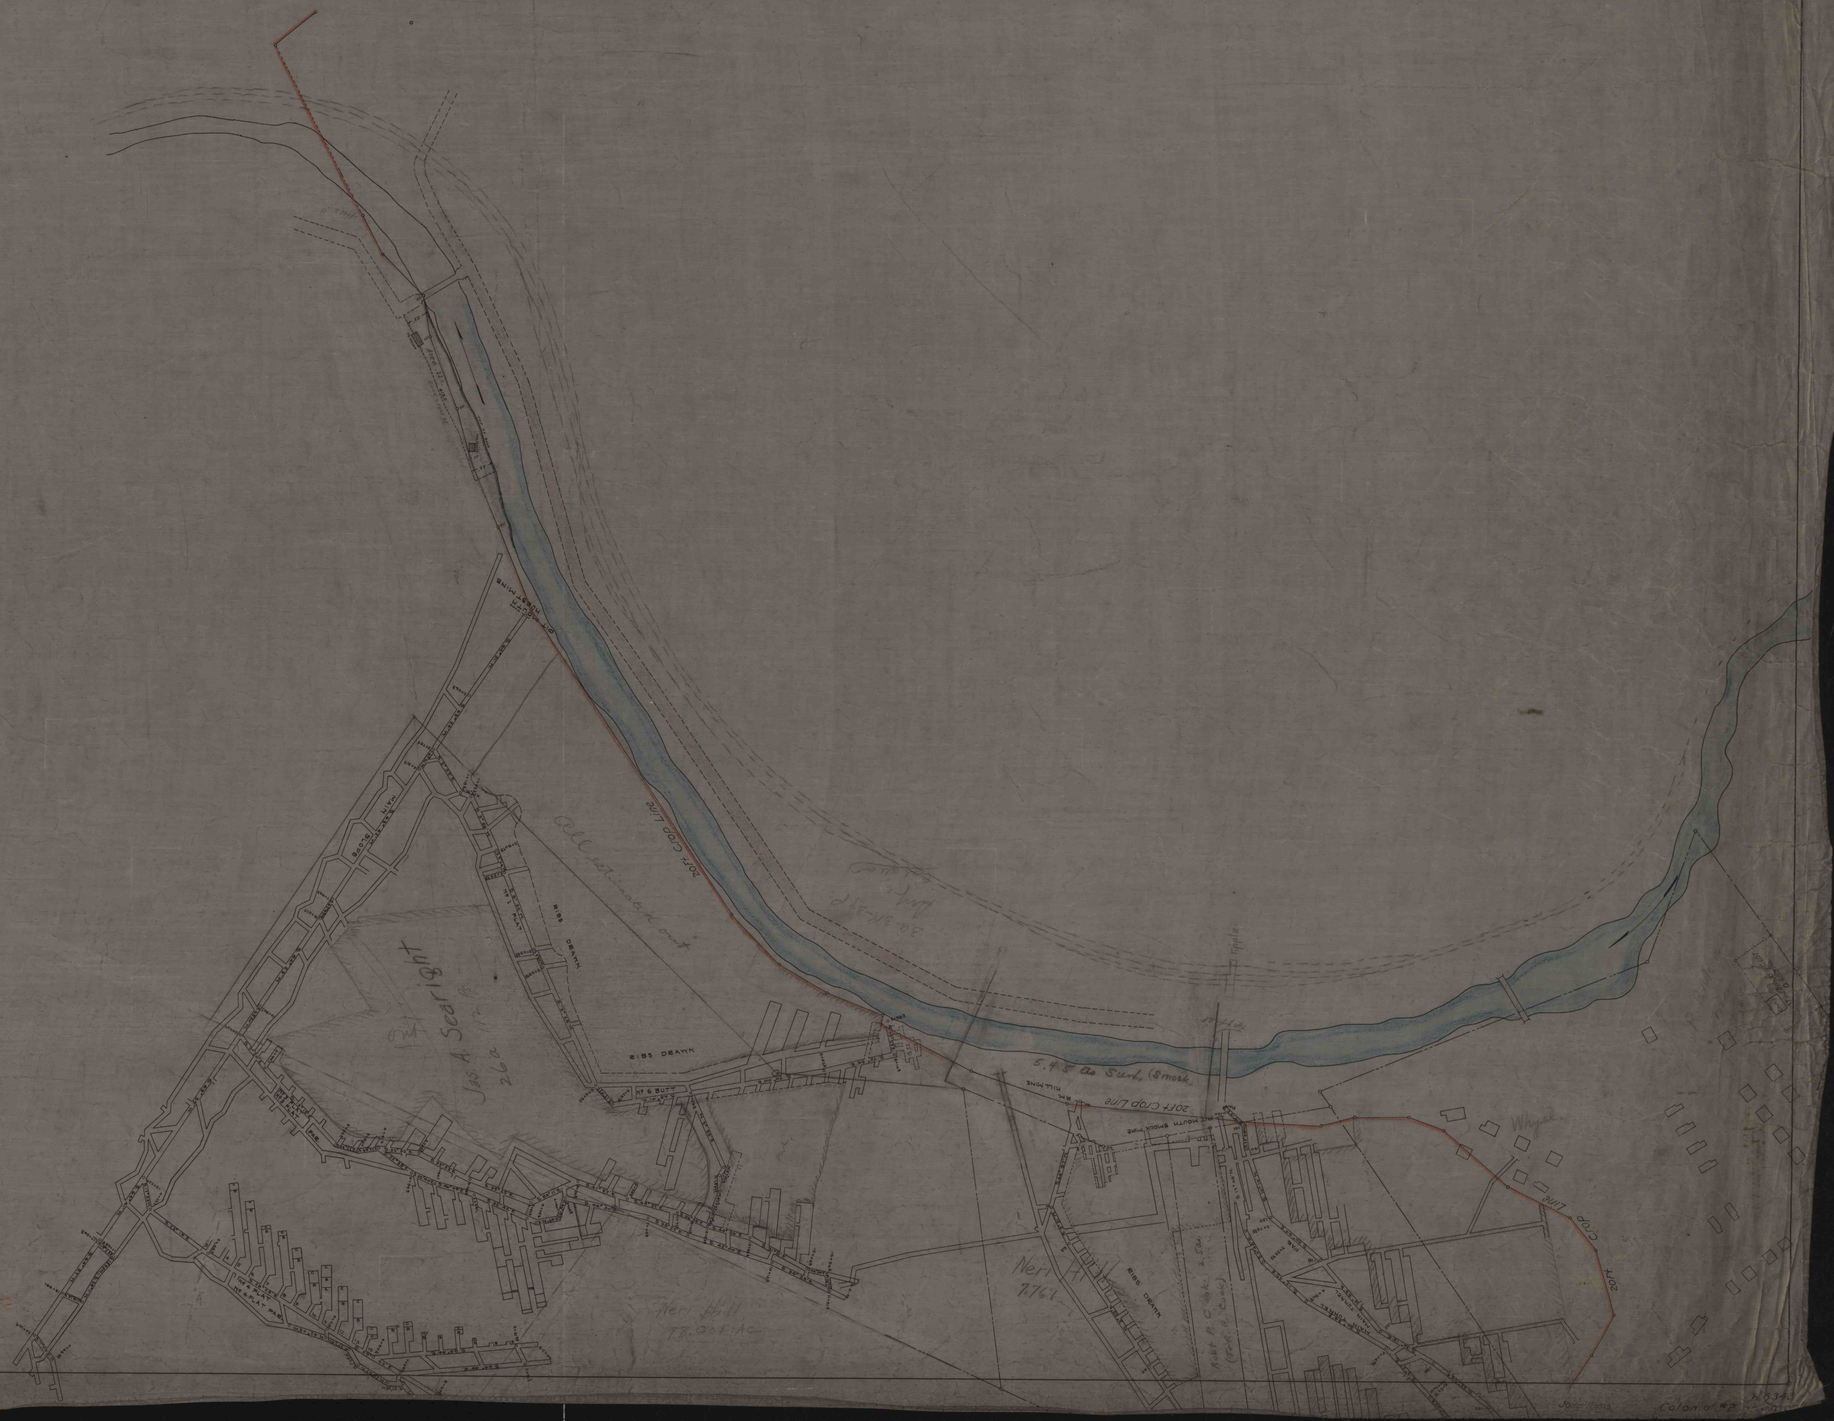
SOFT CROP LINE
Jas A Searight
Alex Hill
77.00 A
Ner
77.61
5.4 E to Surf. (Smock
SOFT CROP LINE
SOFT CROP LINE
R.I.B.S. DRAIN
R.I.B.S. DRAIN
R.I.B.S. DRAIN
SOUTH BROOK TWP.
MILL RUN
Colorado