

FIT TO
H5506-P-33




Do not use

Work

TRACING H-5205 FITS HERE

FIT TO H5344

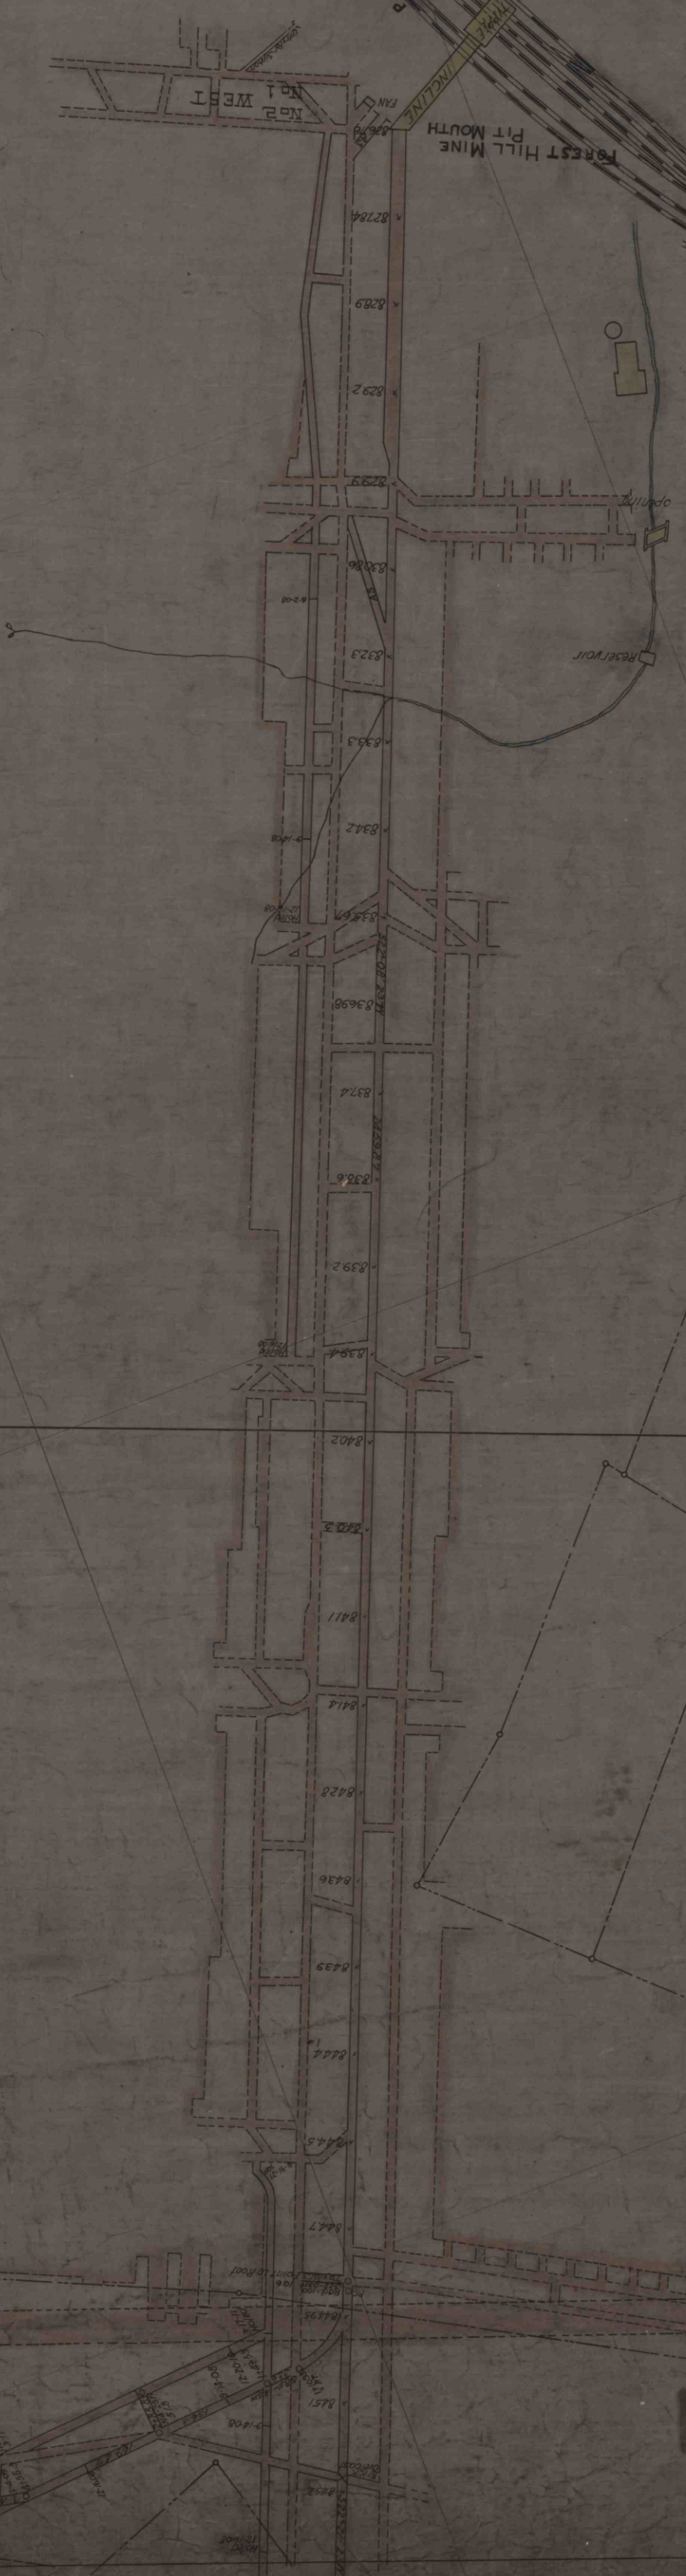

07657 645