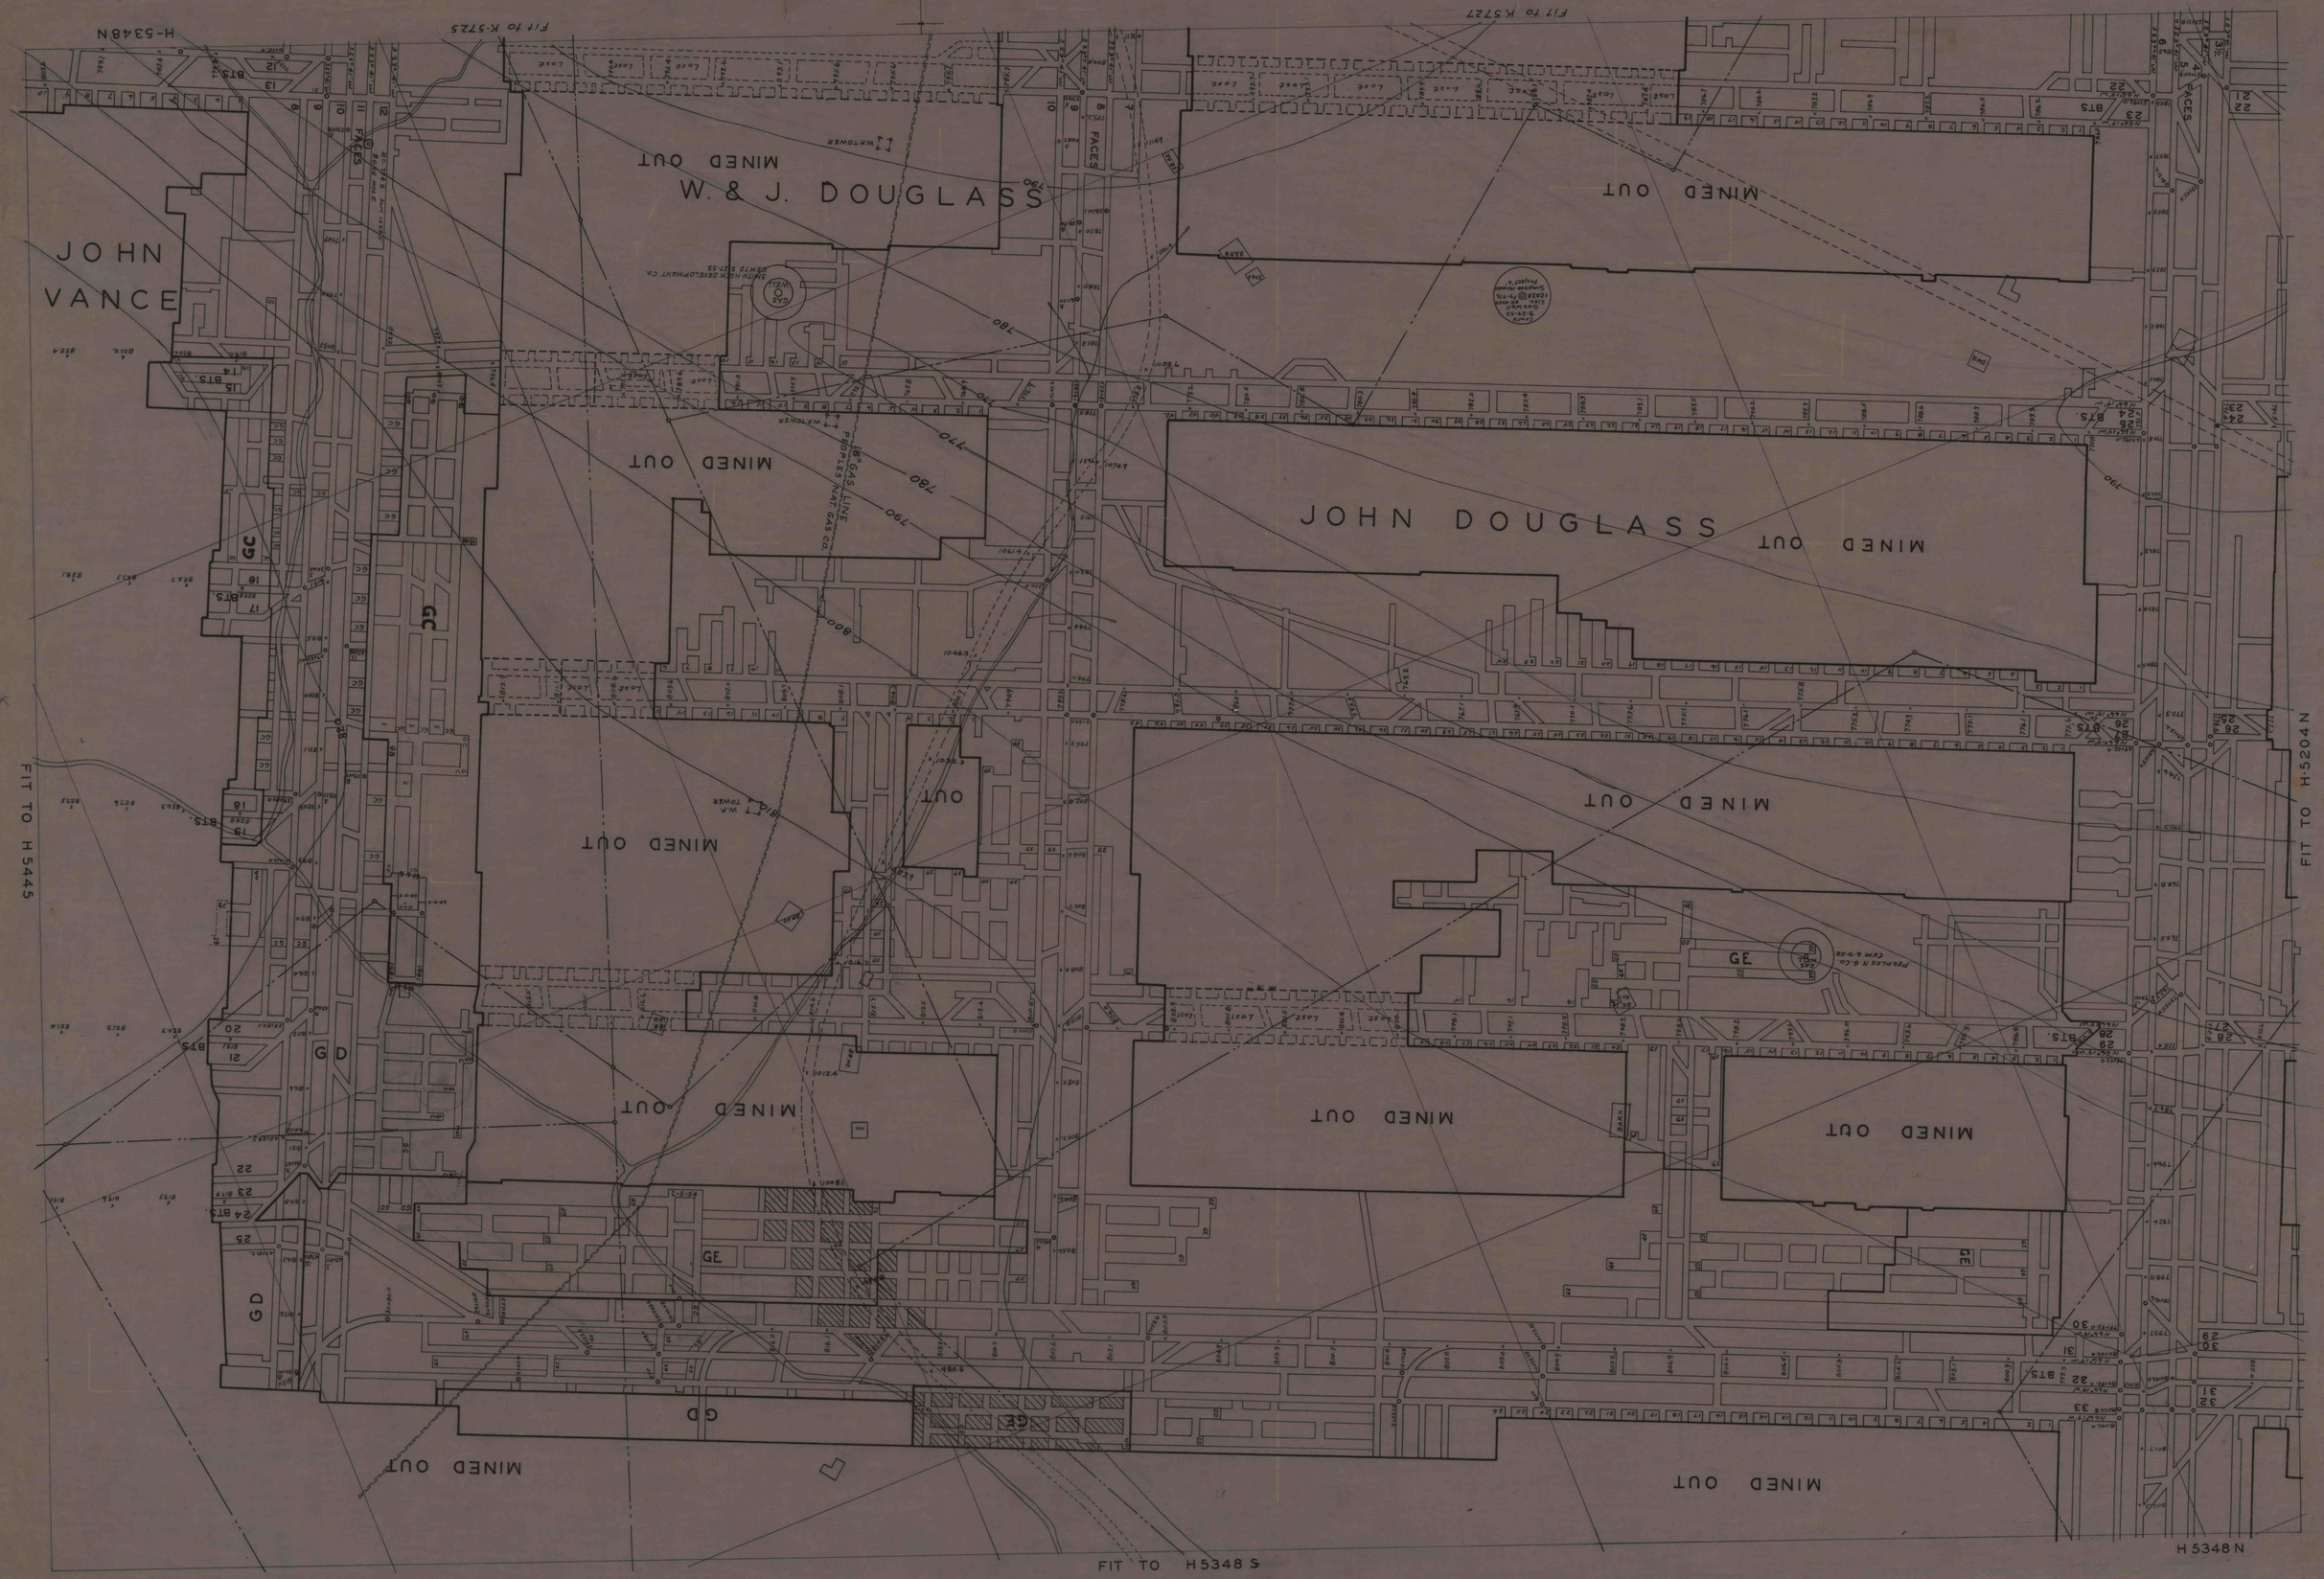
JOHN VANCE
W. & J. DOUGLASS
JOHN DOUGLASS
MINED OUT
FIT TO K-5725
FIT TO K5727
H-5348N
FIT TO H5445
FIT TO H5204 N
FIT TO H5348 S
H 5348 N
GC
GD
GE
FACES
BTS.
WATTOWER
W.P. TOWER
BARN
GAS WELL
SMITH-HICK DEVELOPMENT CO.
PEOPLES NAT. GAS CO.
PEOPLES N.G.CO.
CFM 6-9-28
County
9-29-32
Dam Well
Elev. 24.8ft
Dampsie Power
Project X
12926 Ph-Th
8" GAS LINE
PEOPLES NAT. GAS CO.
780
790
800
770
10483