


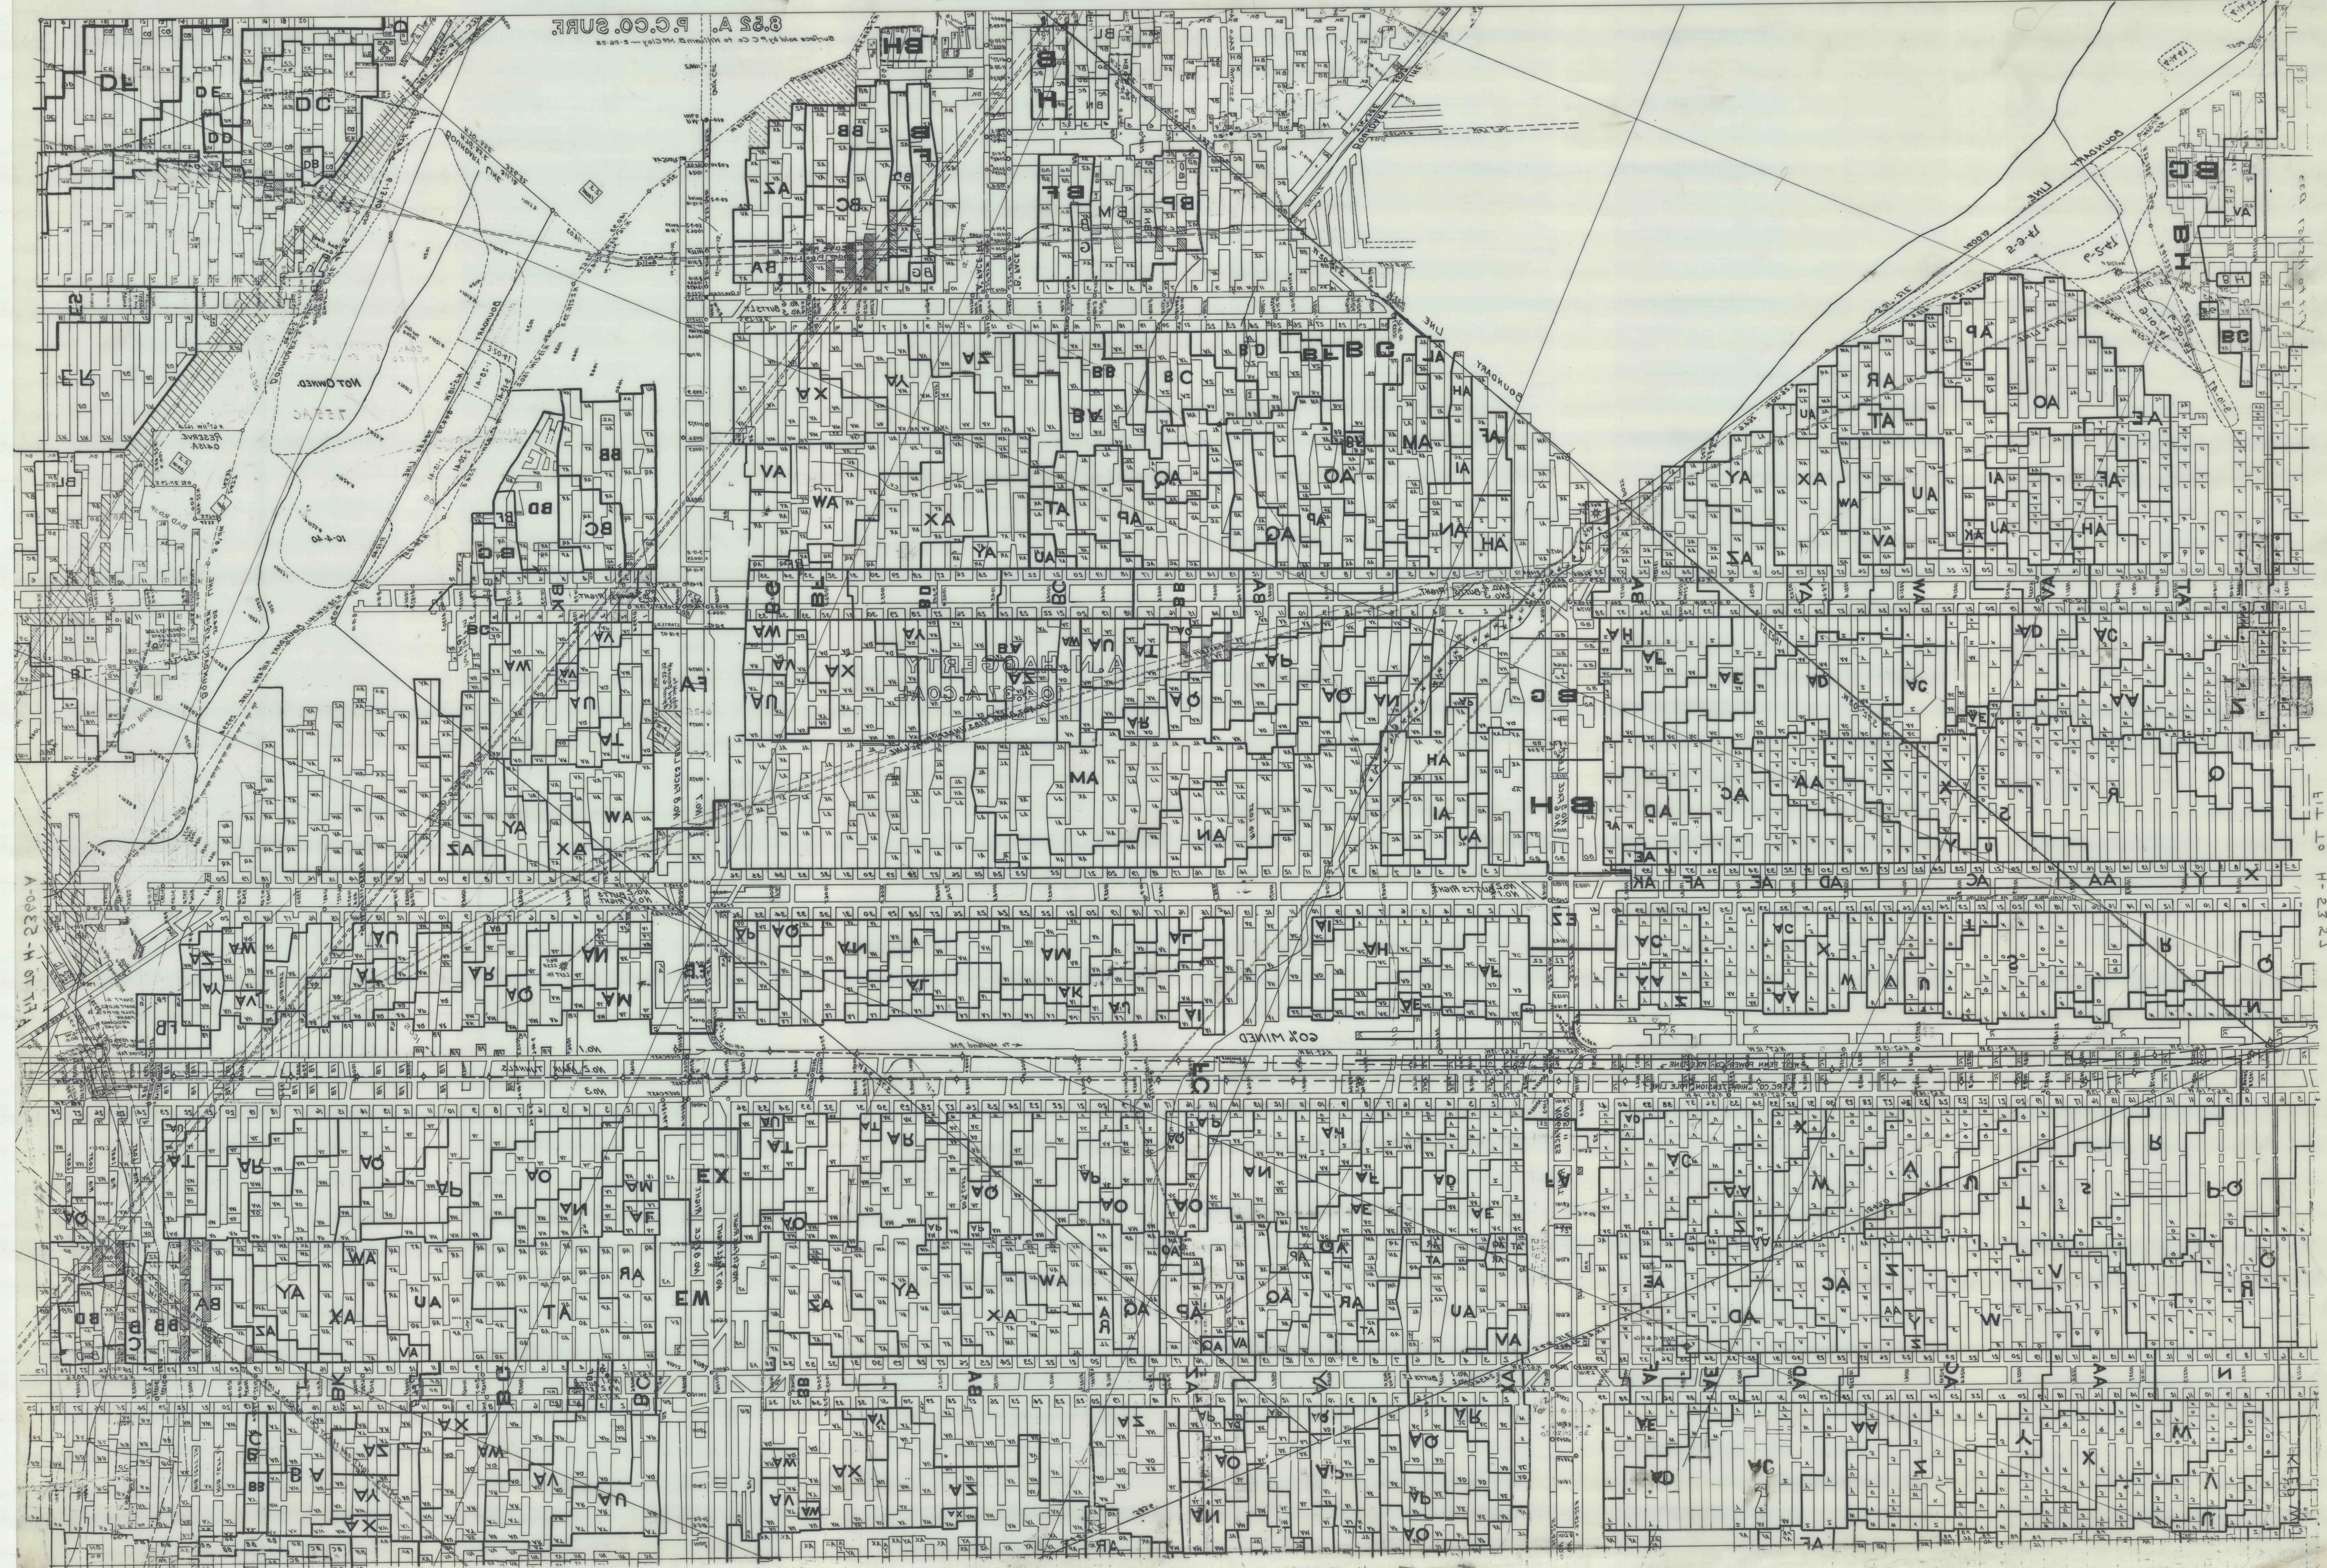

8.25 A.P.C.O. SURF

NOT OWNED

10-4-40

COX WIND

FIG. 10 H-2325