


FILE TO K-2229

(WIDFUND) WESTLAND

H 2229-B

①

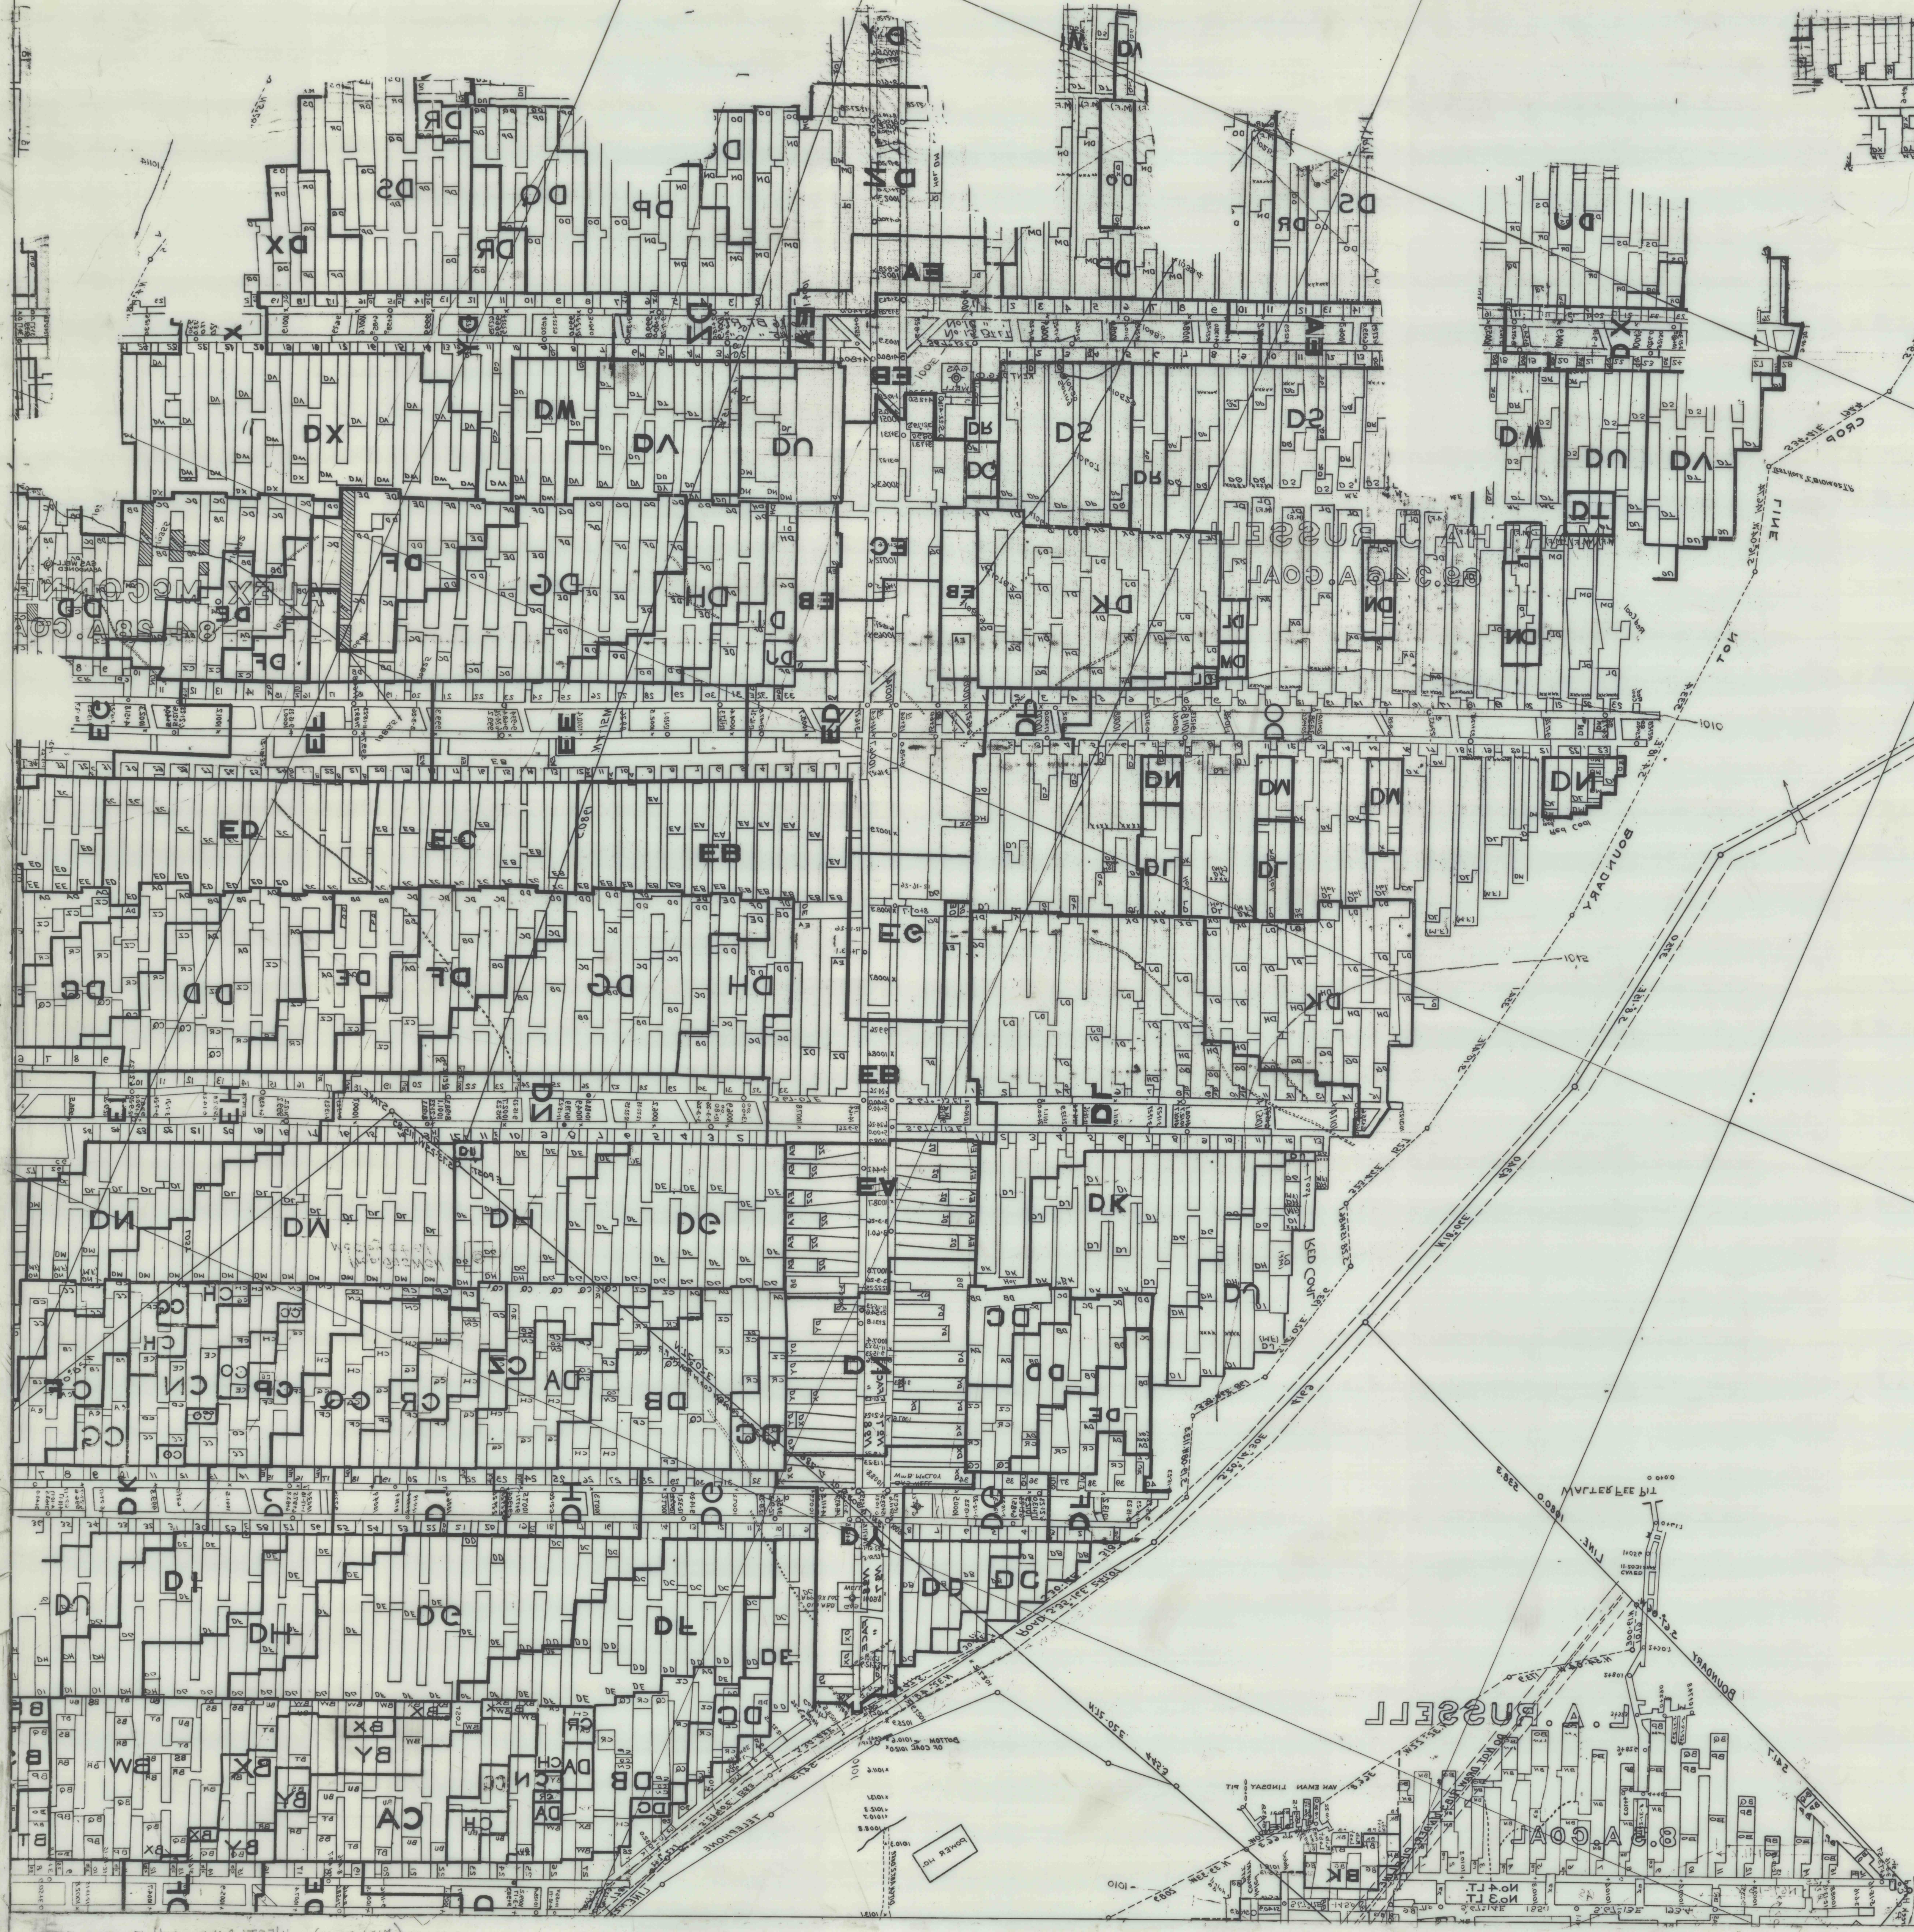

FILE TO K-2229-B

FILE TO H-2229-A

(WIDFUND) WESTLAND H-2229-B