


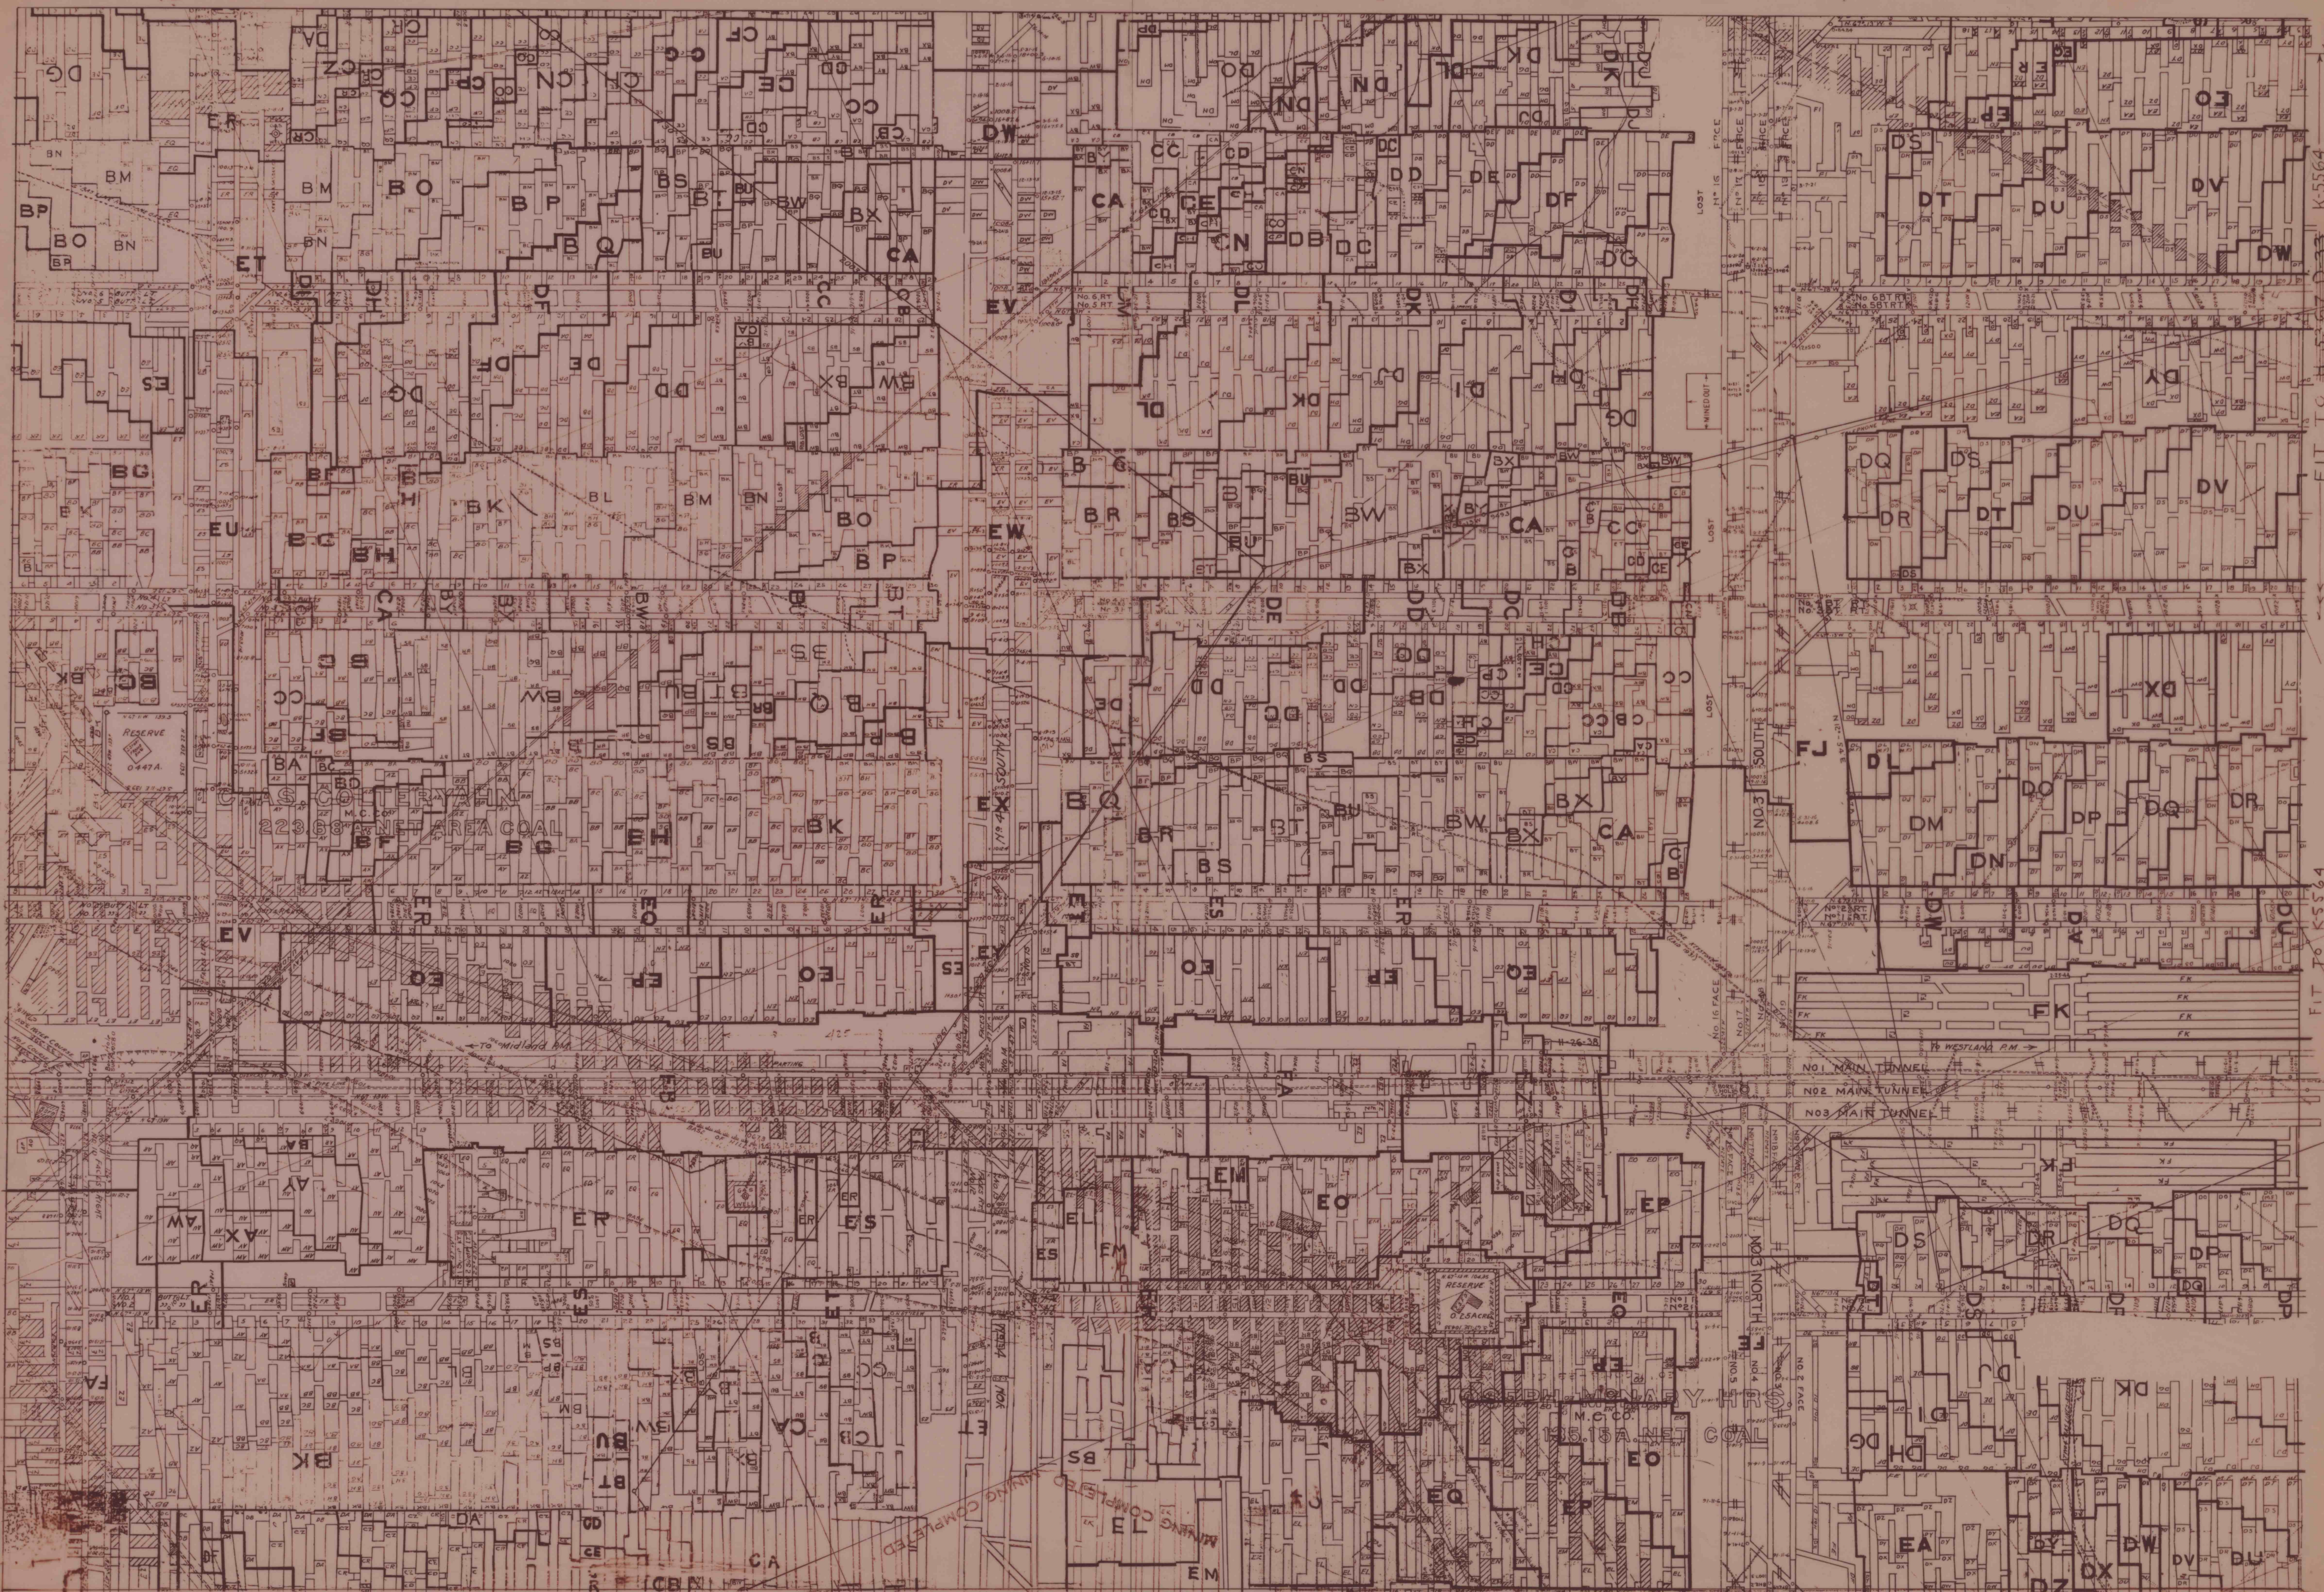

FIT TO K-5371

(MIDLAND) WESTLAND H-5360-A